

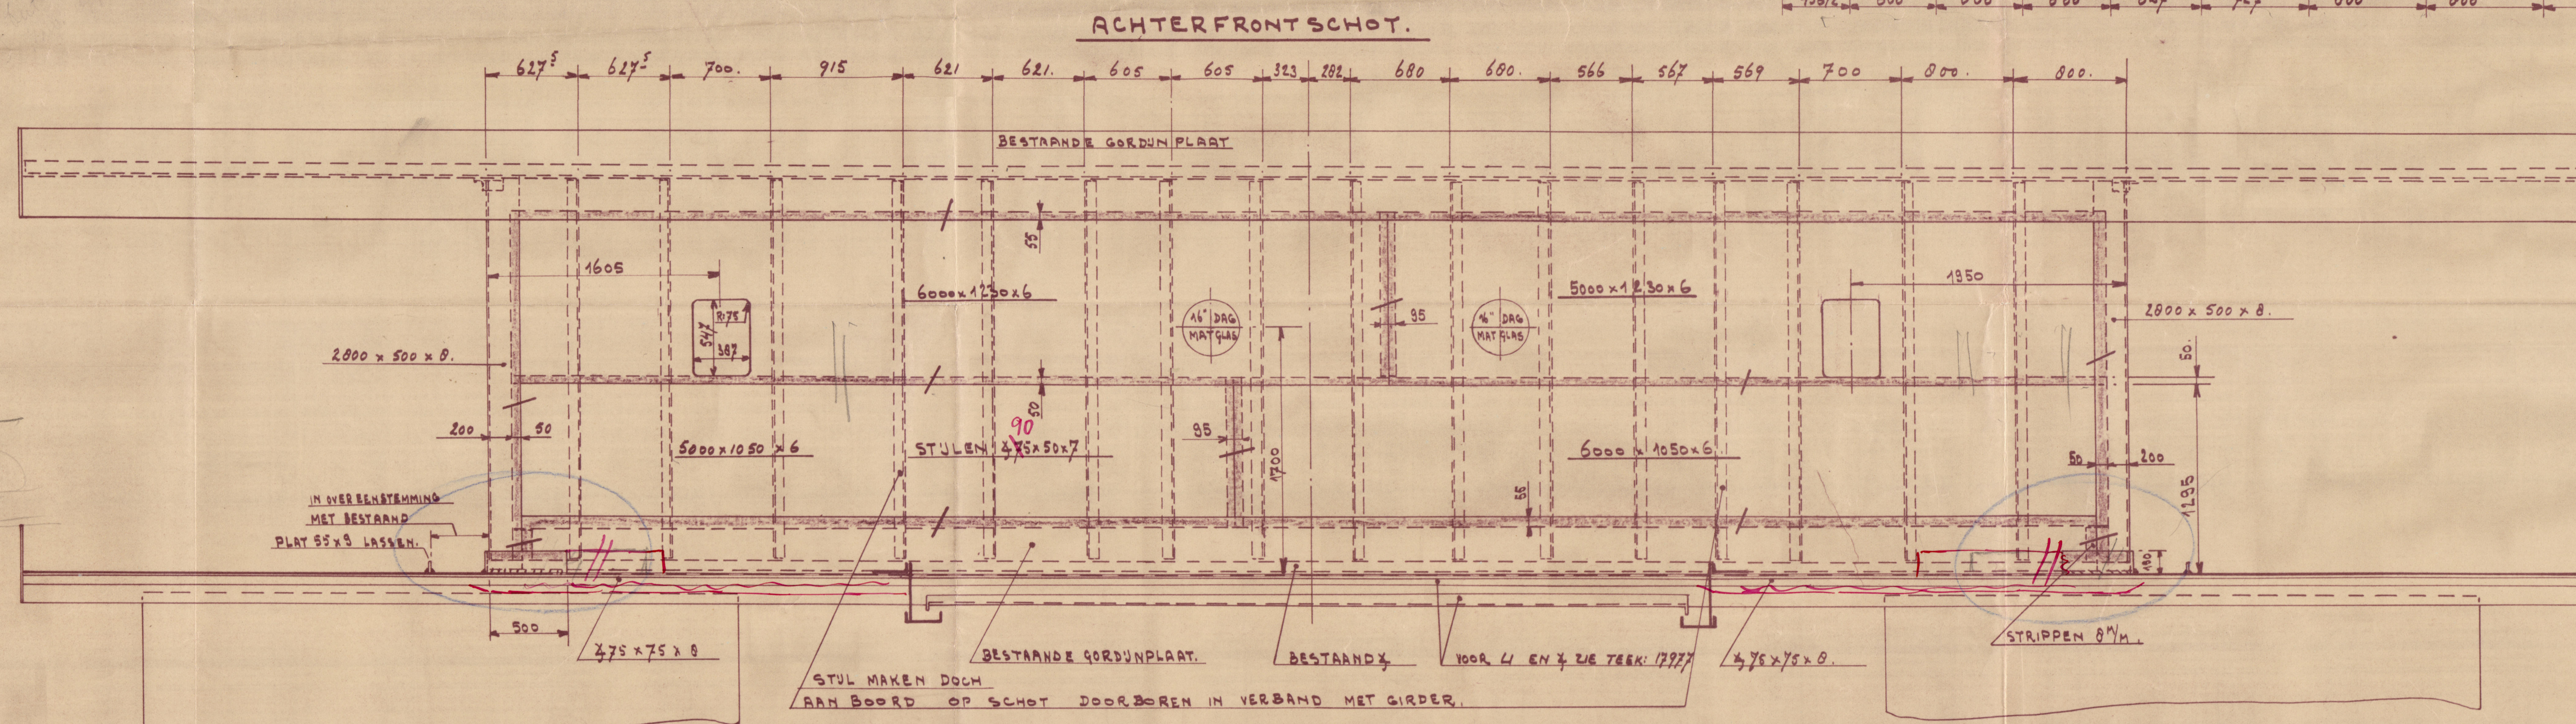
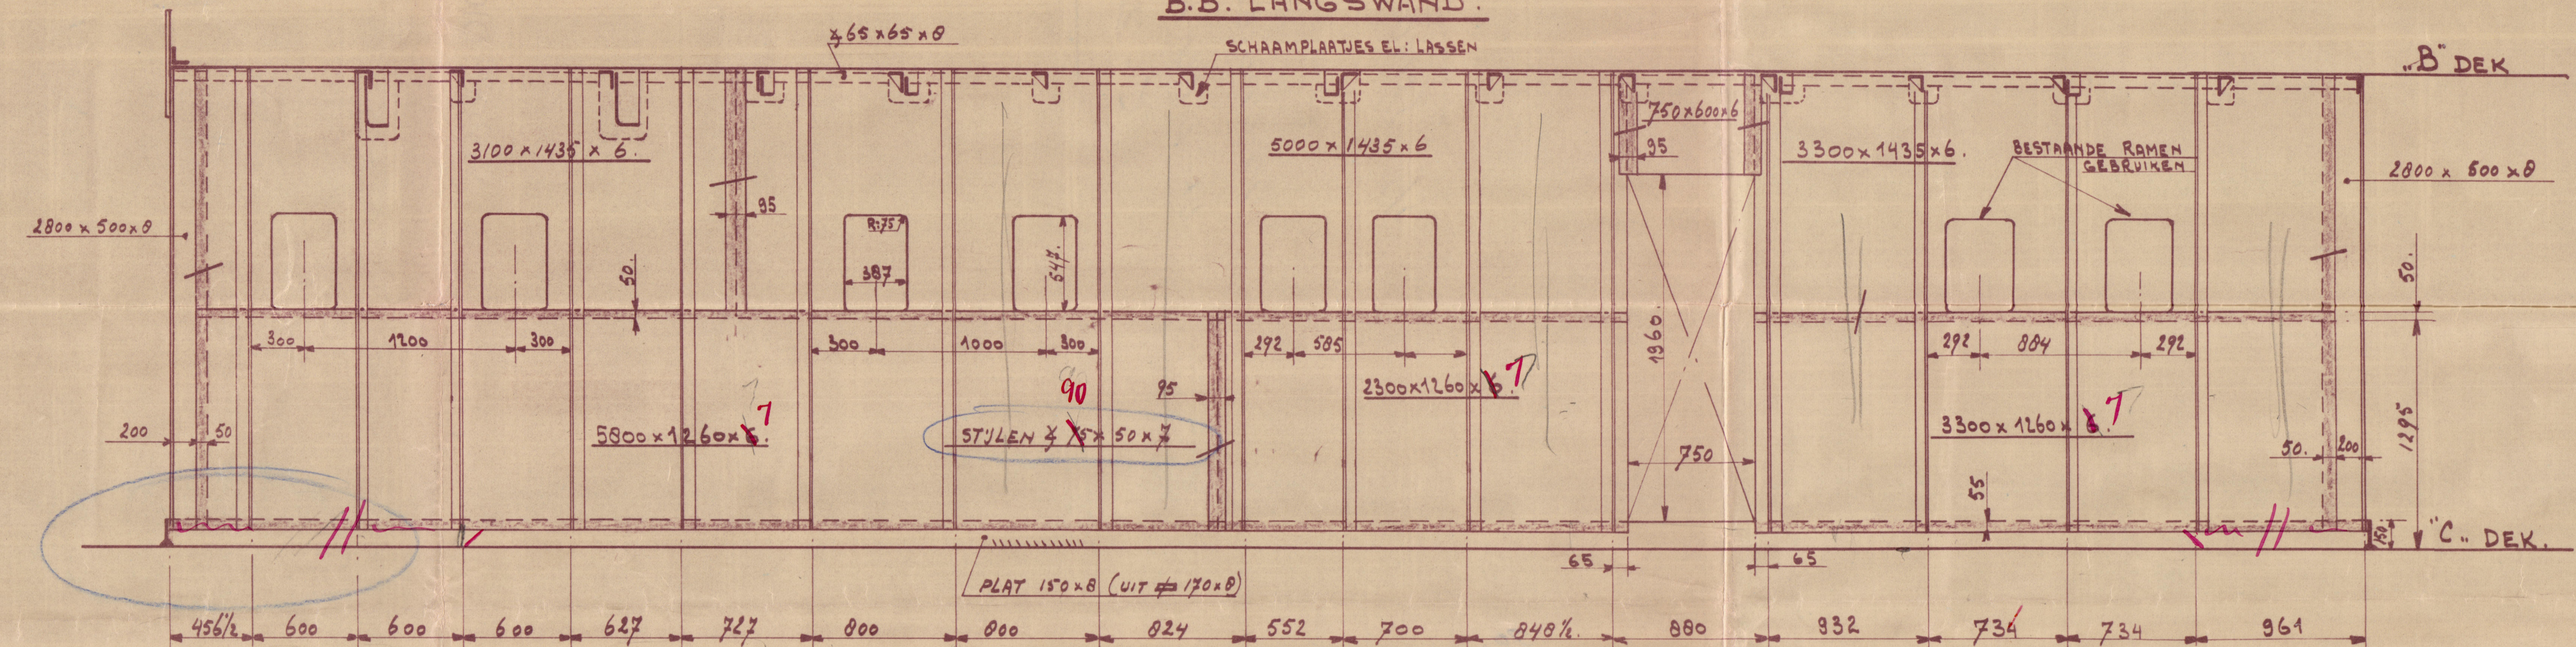
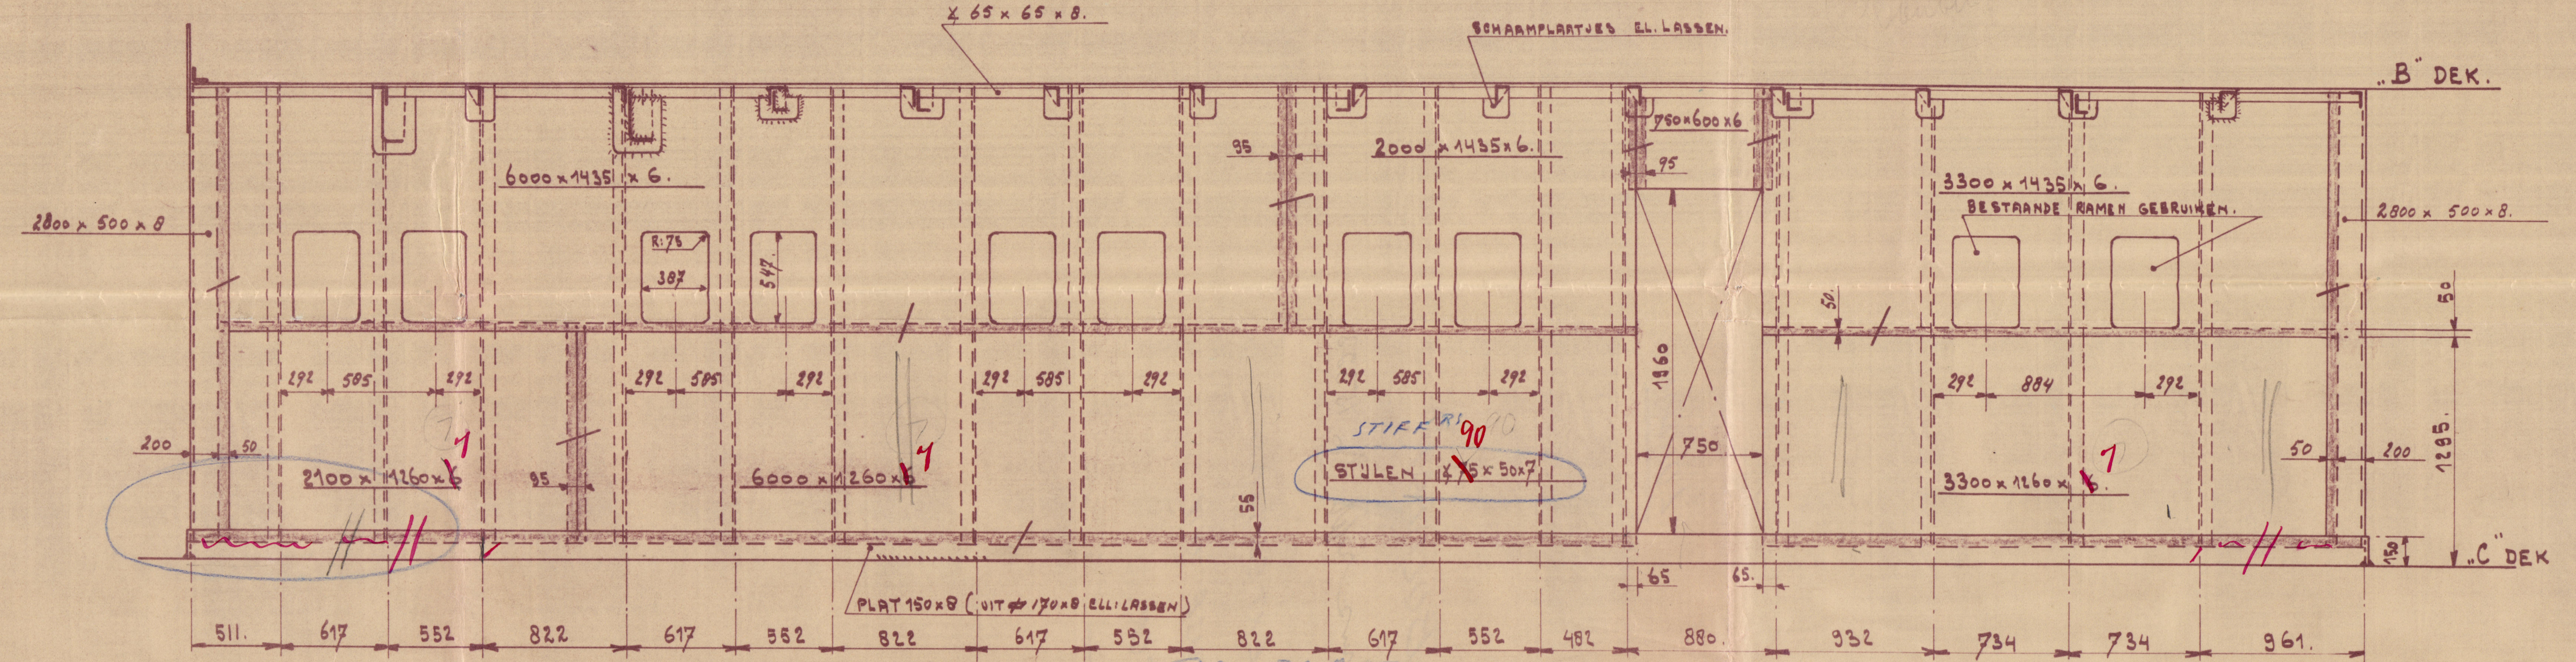


28 APR 1938

F.A.D. BULKHEAD.  
S.B. LANGSWAND.

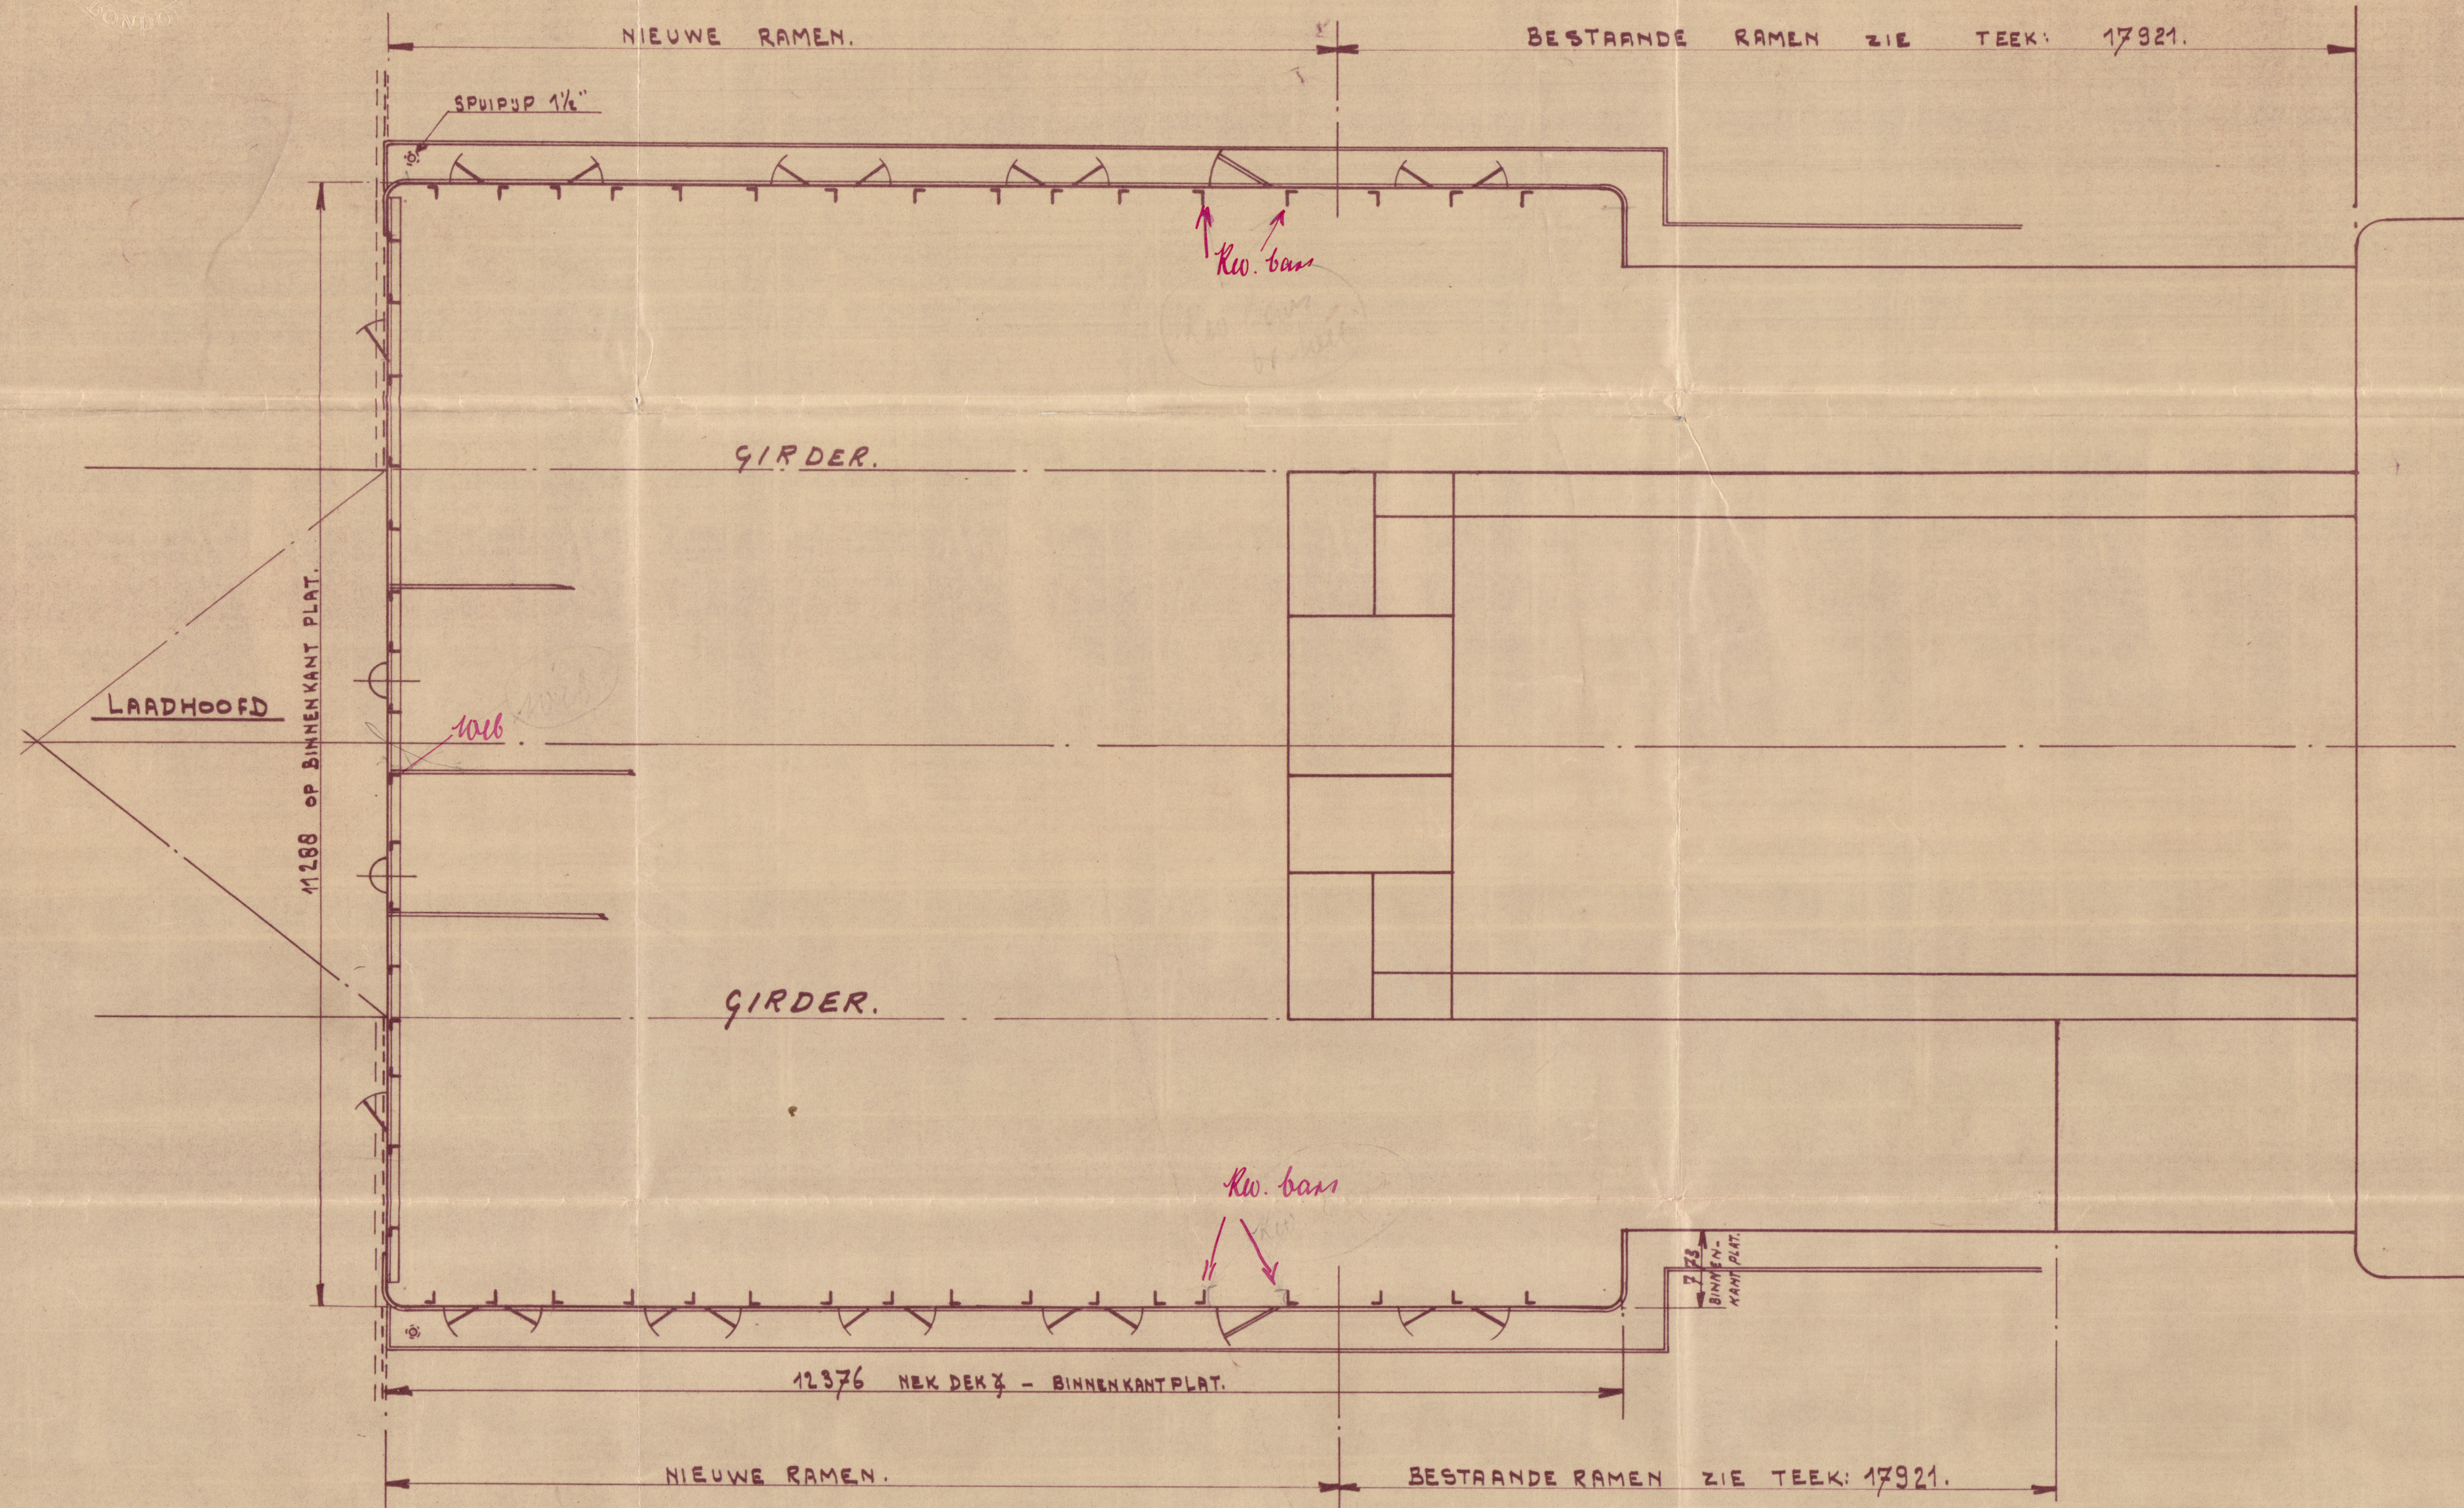

VOORSCHOT - SB EN B.B.  
B.B. IS GETEEKEND.

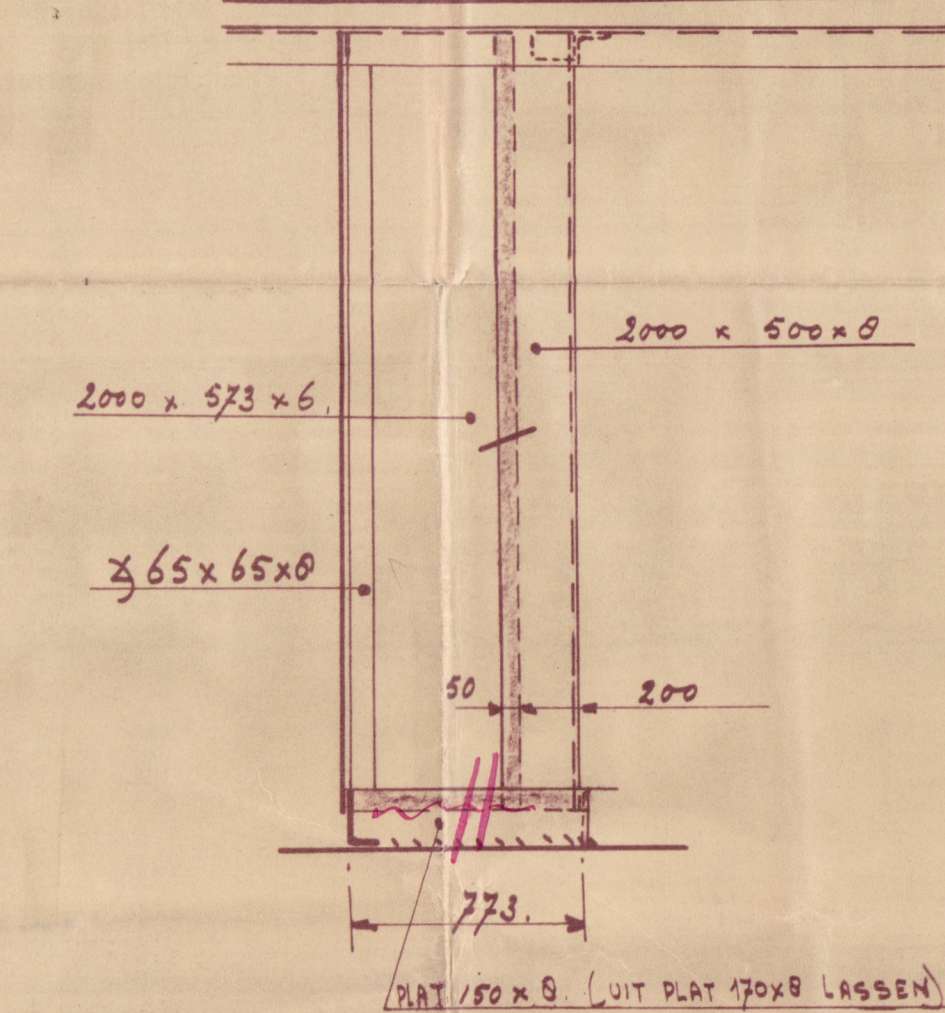

KLIN K WERK.  

GOEDGEKEURD

N.V. AMST. DROOGDOK MU  
DEKHUIZEN OP "C" DEK.  
POST. 3. S.S. "SIMON BOLIVAR"  
SCHAAL DATUM GET. GEG. GEZ. BESTEMD VOOR.  
1:15. 20-4-18 1/2  
ORDER NO. 17978.  
TEEK. NO. 17978.



LONDON

S/S "SIMON BOLIVAR"

Ans. ref. No. 15323.

PROPOSED EXTENSION  
OF DECKHOUSE ON  
C-DECK.

---



© 2019

Lloyd's Register  
Foundation

W478-0100