



# S.S. SIMON BOLIVAR

SCHAAL 1/8" = 1'-0"

C DEK

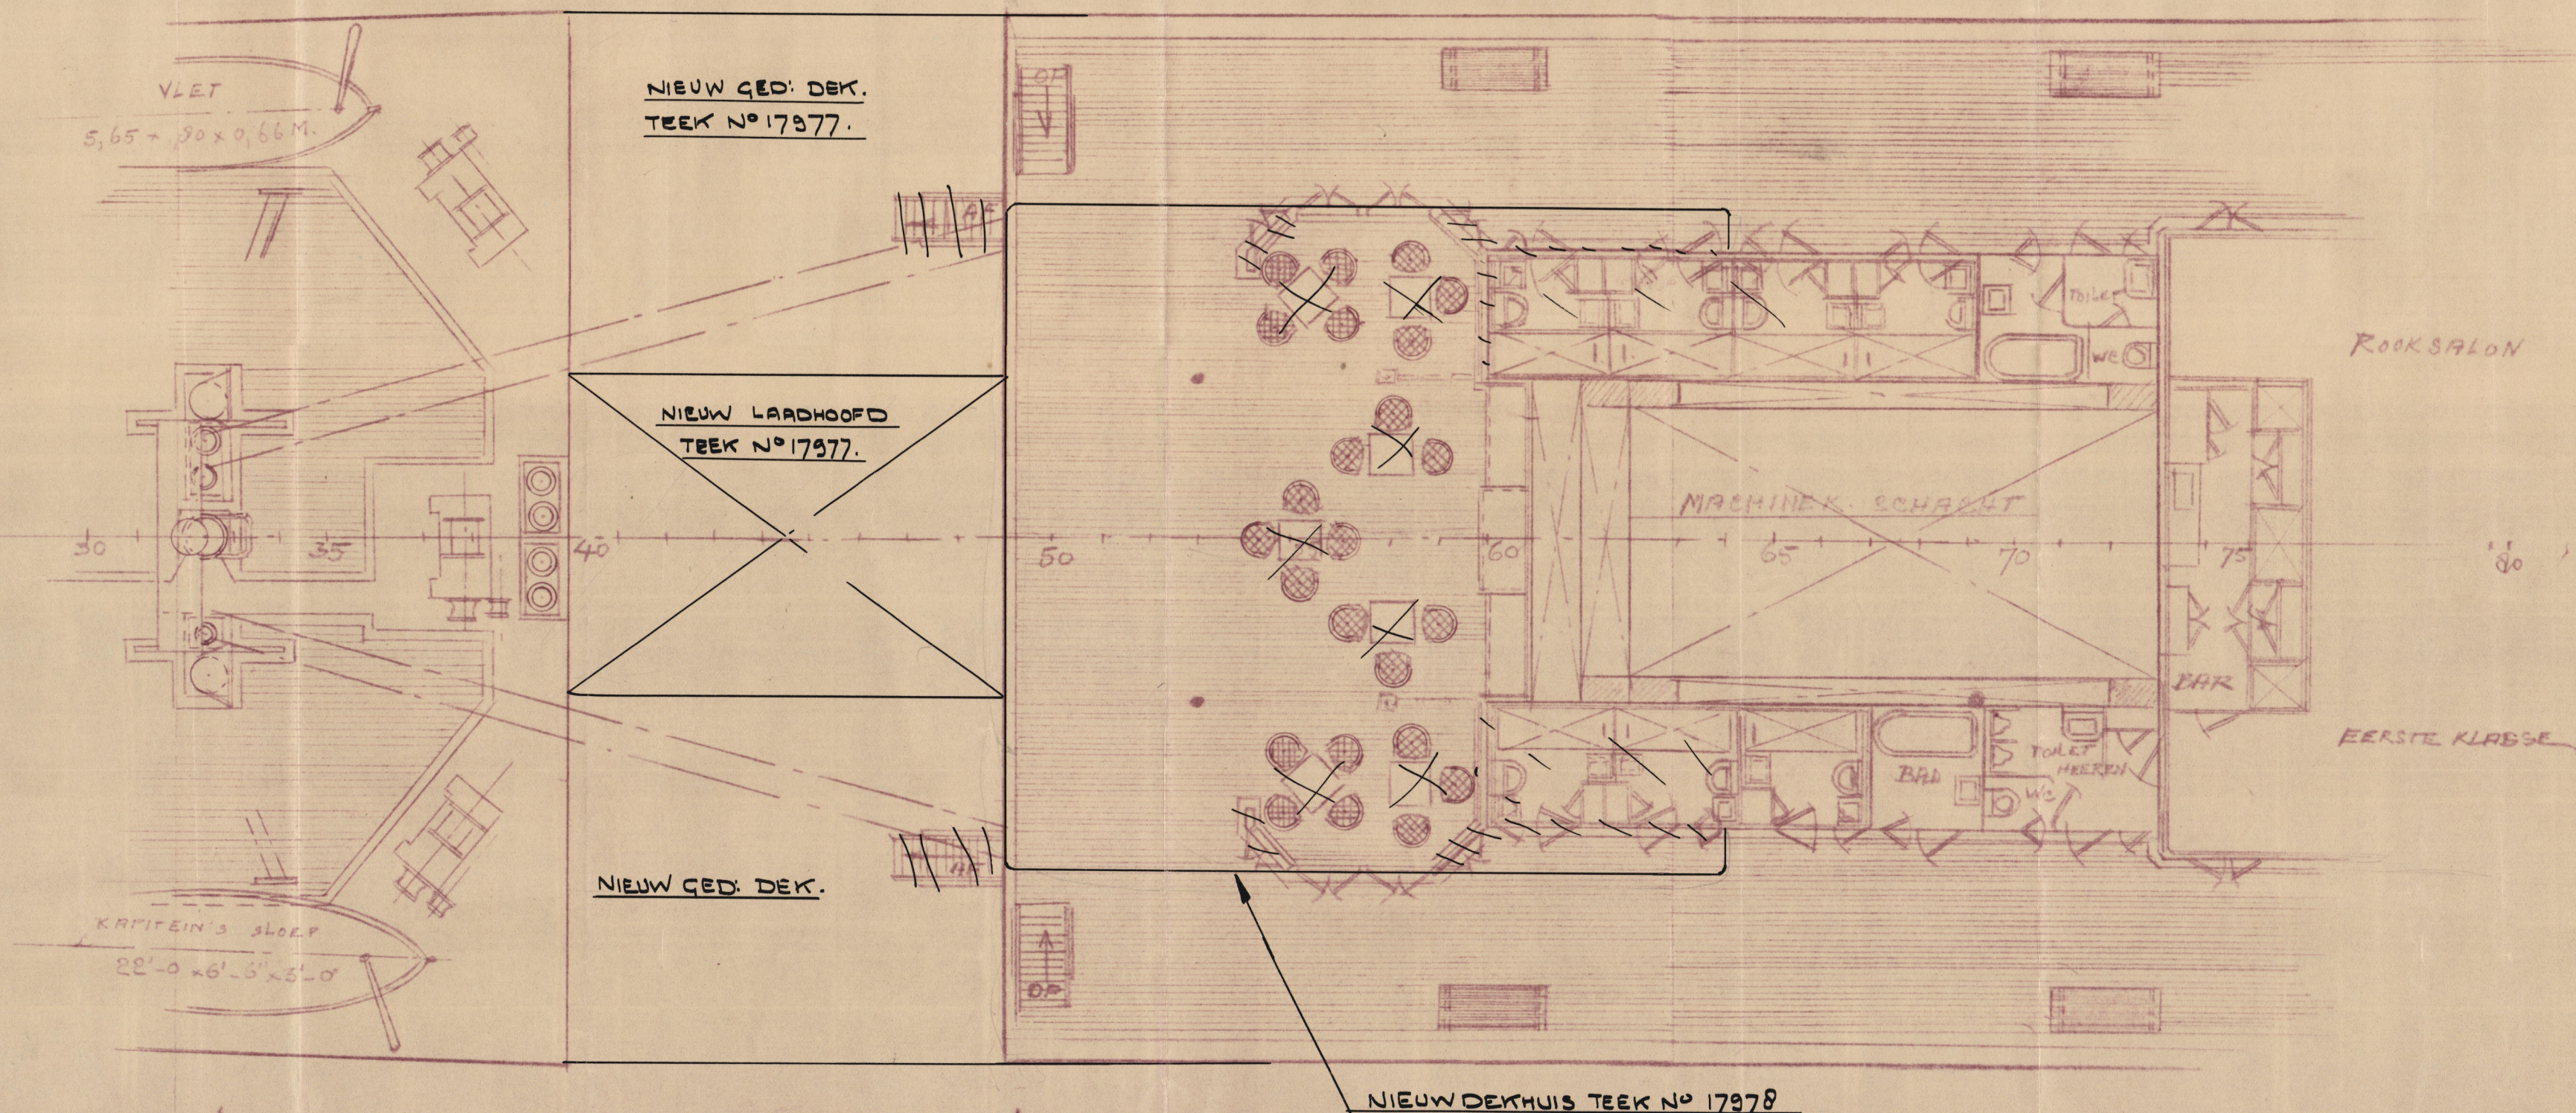

D DEK

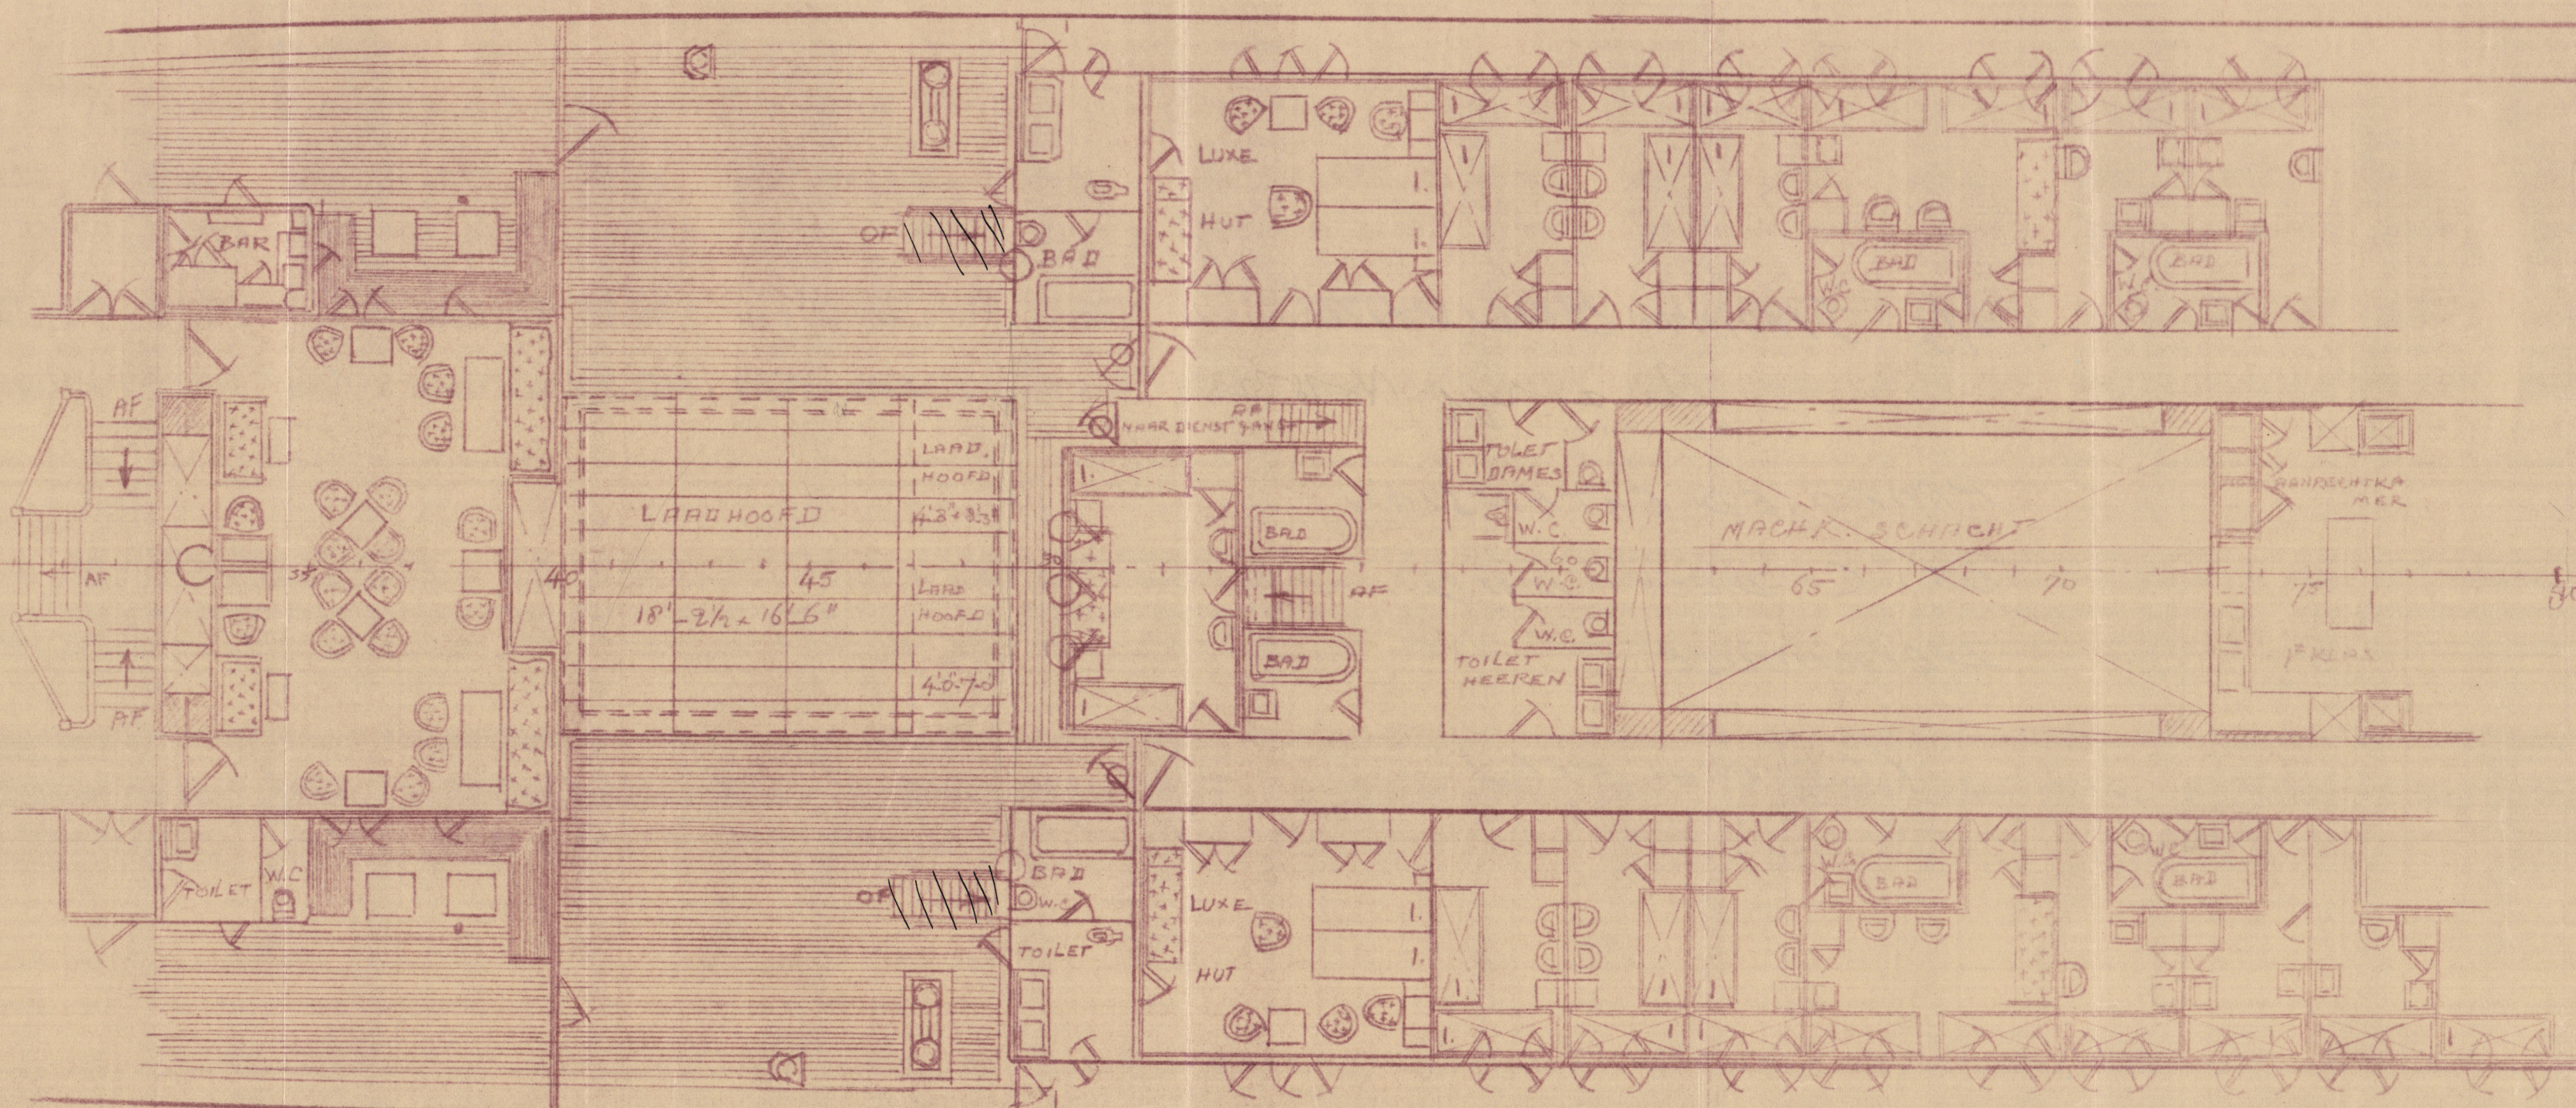

C dek.

~~E DEK~~




LONDON

S/S "SIMON BOLIVAR"

Aus. reg. No. 15323

PROPOSED EXTENSION  
OF C-DECK AND  
DECKHOUSE

(GENERAL ARR.)

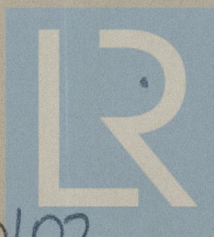

© 2019

Lloyd's Register  
Foundation

W478- 0102