


S.S. SIMON BOLIVAR


Ans repl
No 15-323.

SCHAAL 1/8" = 1'-0"

C DEK

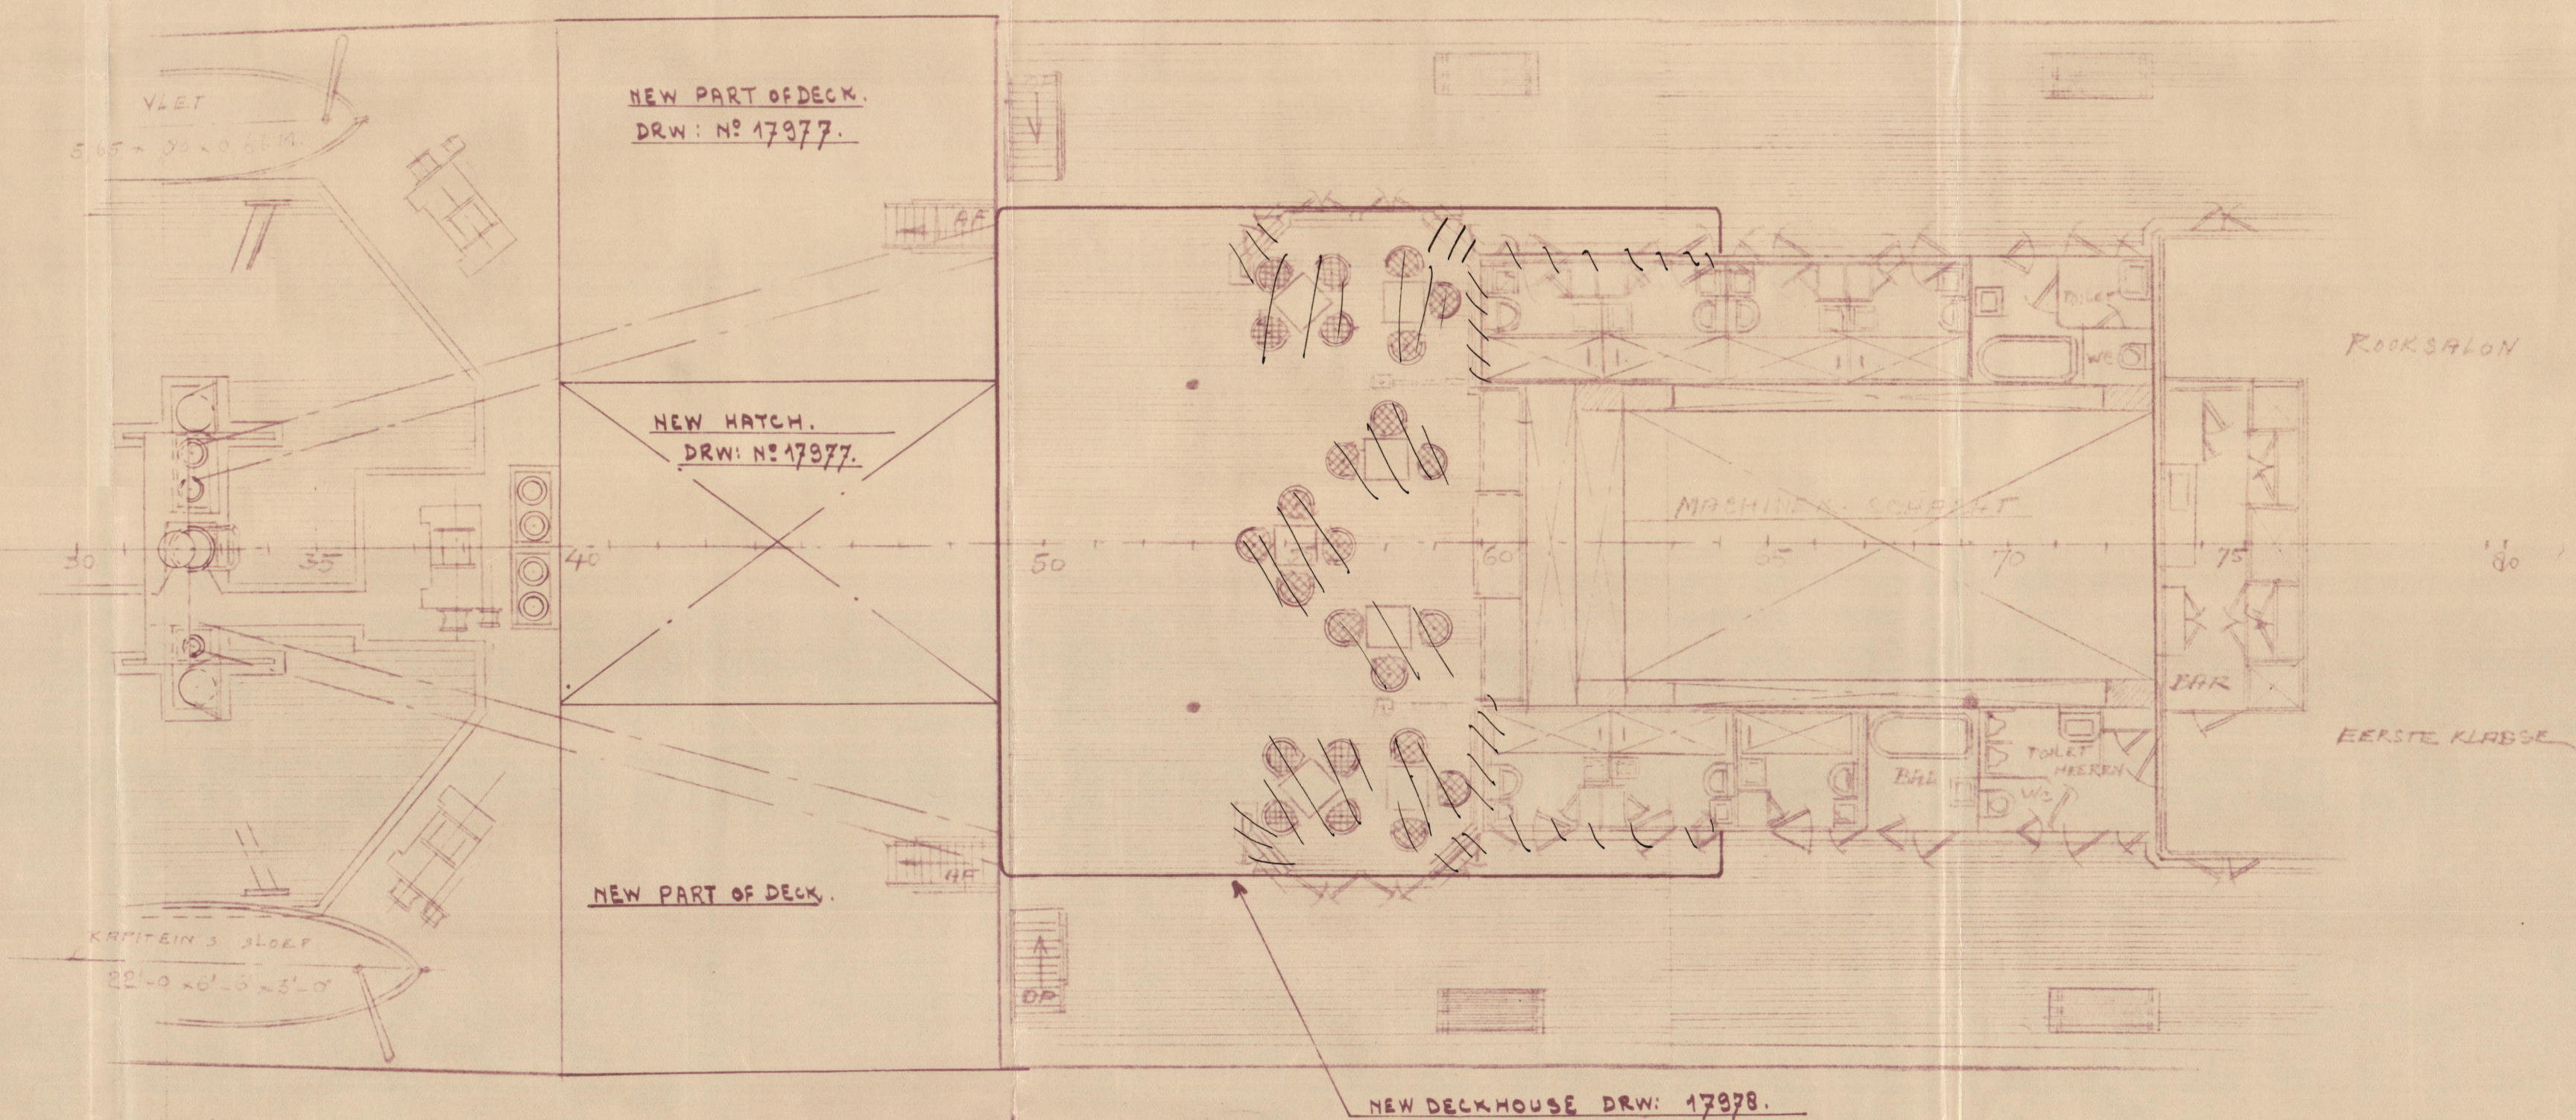

D DEK

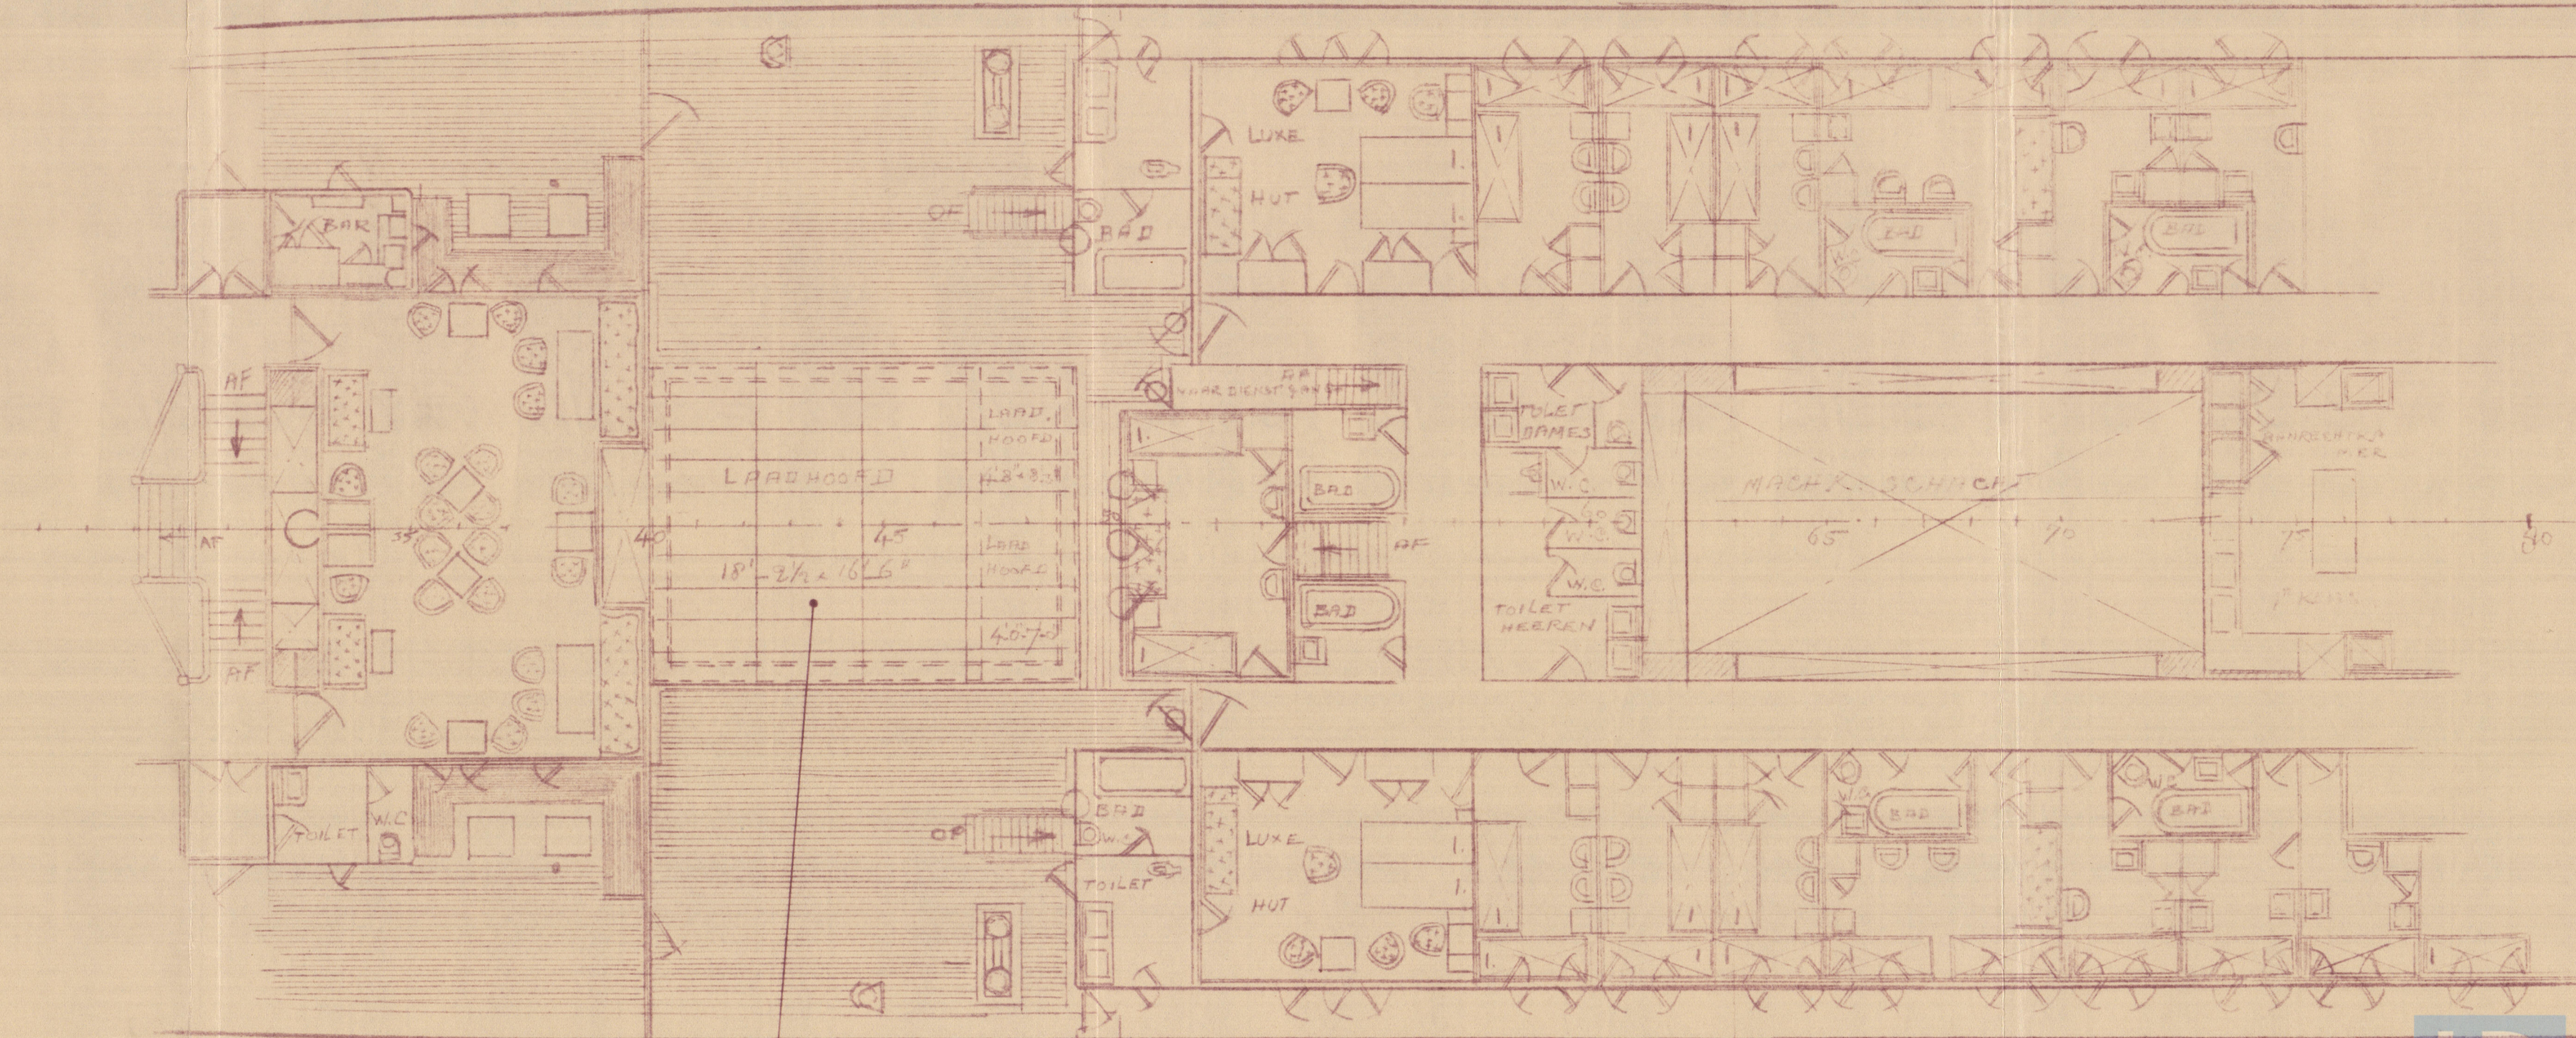

EXISTING HATCH REMAINS WITHOUT ALTERATIONS.

E DEK