

1:4005.


TENSILE STRENGTH OF SHELL PLATES BUTTS & MANHOLE RINGS 28³/₄ TO 32 TONS

"	"	"	OTHER	"	26	"	30	"
"	"	"	LONGITUDINAL STEEL STAYS	"	27	"	32	"

ALL PLATES OF STEEL
" RIVETS "
" TUBES " IRON

POSITION OF MANHOLE
LATER, TO SKETCH

ALL HOLES TO BE DRILLED
IN PLACE

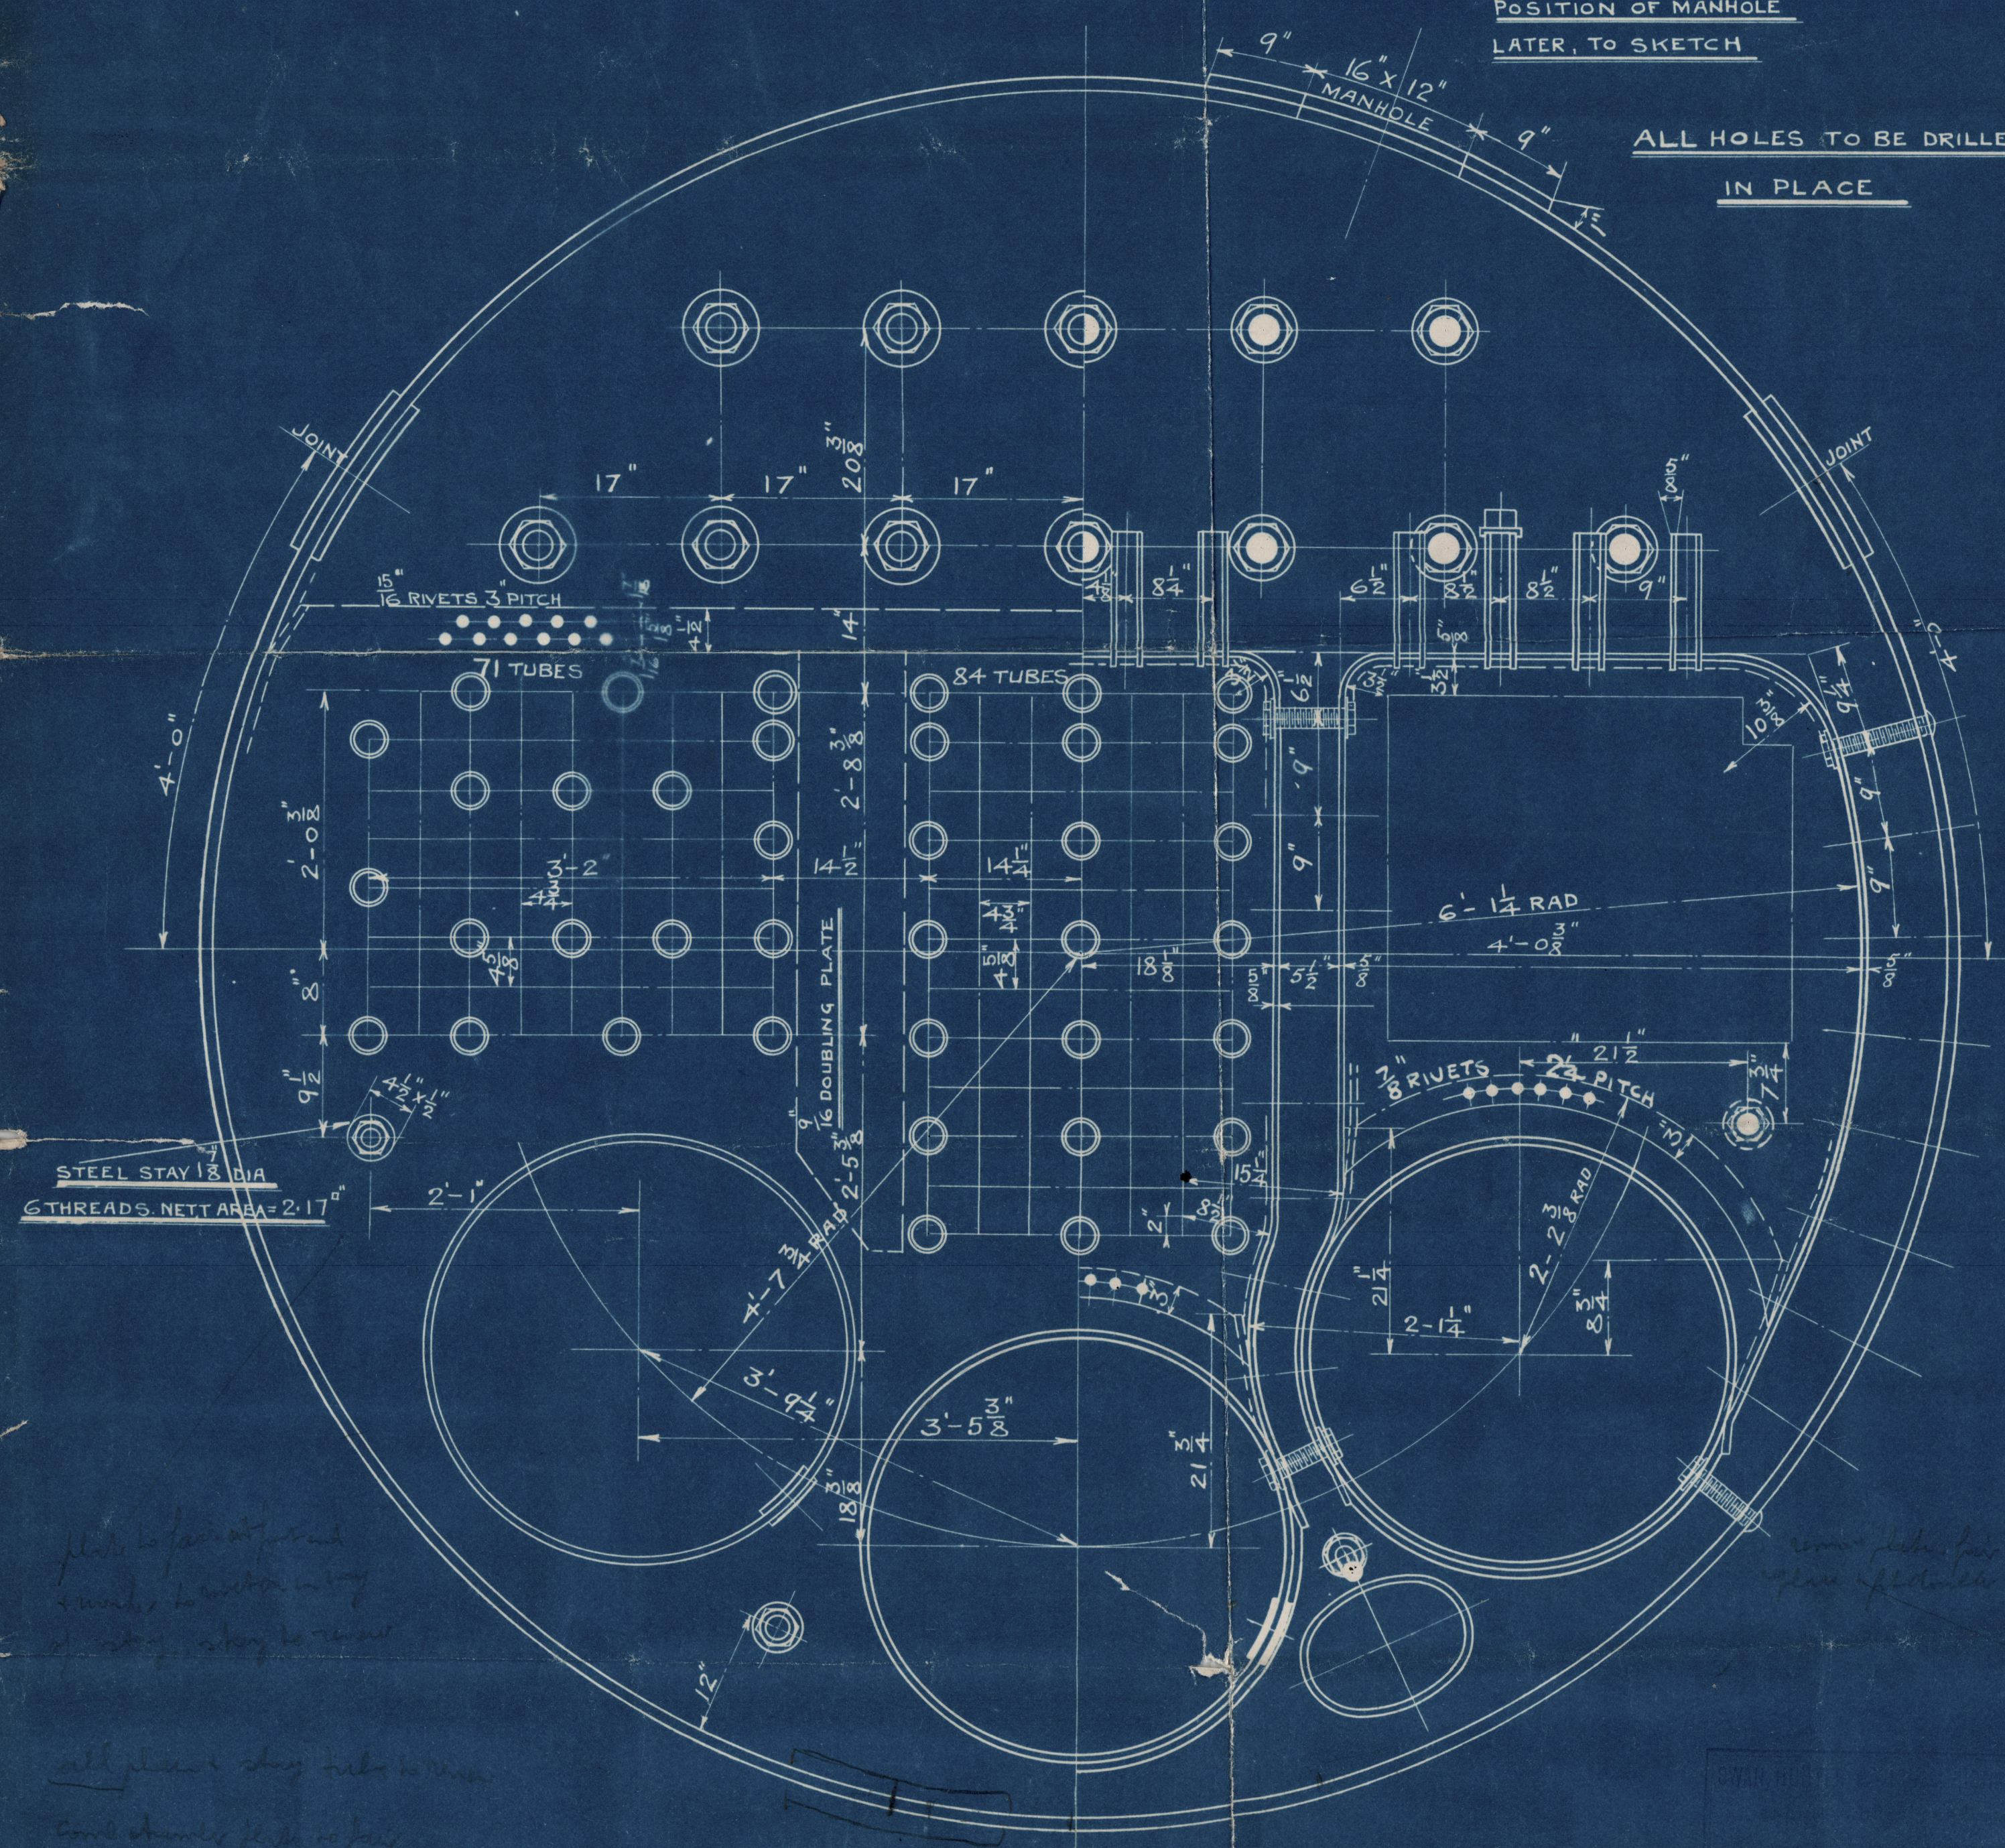

208967

48261
19234
81568

Shaw
175

175 J. Campbell
149 m. 1000 m. 1000 m.
149 m. 1000 m. 1000 m.

60 1000

108
9
912

1080
2160
864

14800
1264
2160
212
432
148

Meas.
Swan, Hunter, Wigham.
Richardson, & Co.
Main Boilers. for No. 740.
Working Press. 160 lbs.



RETAIN

No 7062
Lloyd's List
3204.
L. H. H
23-8-05

J. P. Lestrade
Newcastle Report
No 49459

W479-0063

