

-S.S. N° 474-5-6.


Amended Profil

S/S no 476

'Pangan'

Glasgow Report

Nº 245-90.

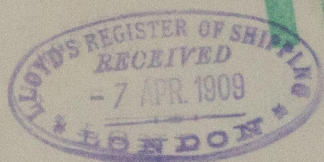

RETAIN

W 479-0172



© 2019

Lloyd's Register  
Foundation