


DECK PLANS N^o 231 ^S/_S.

SCALE $\frac{1}{3}$ = ONE FOOT.

BRIDGE


FORECASTLE

POOP

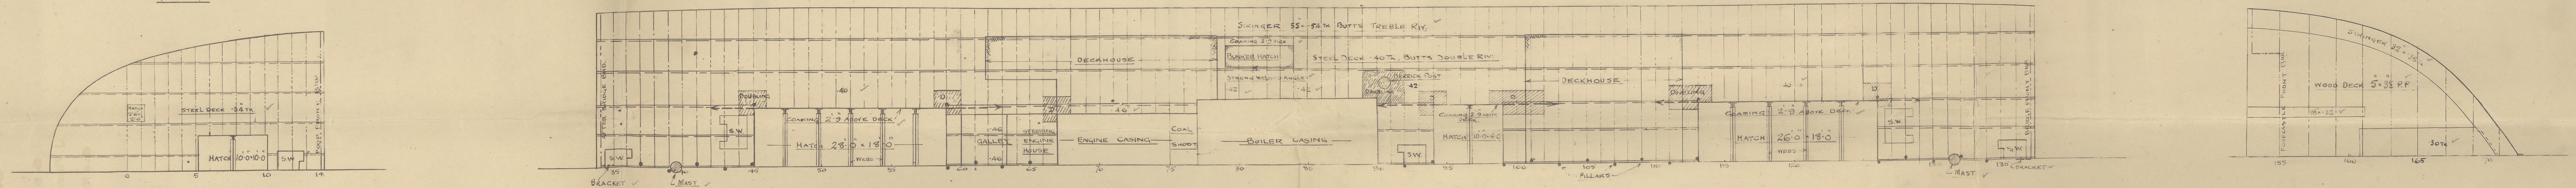

UPPER DECK

John Priestman & Co
Shipbuilders
Sunderland 20.8.13

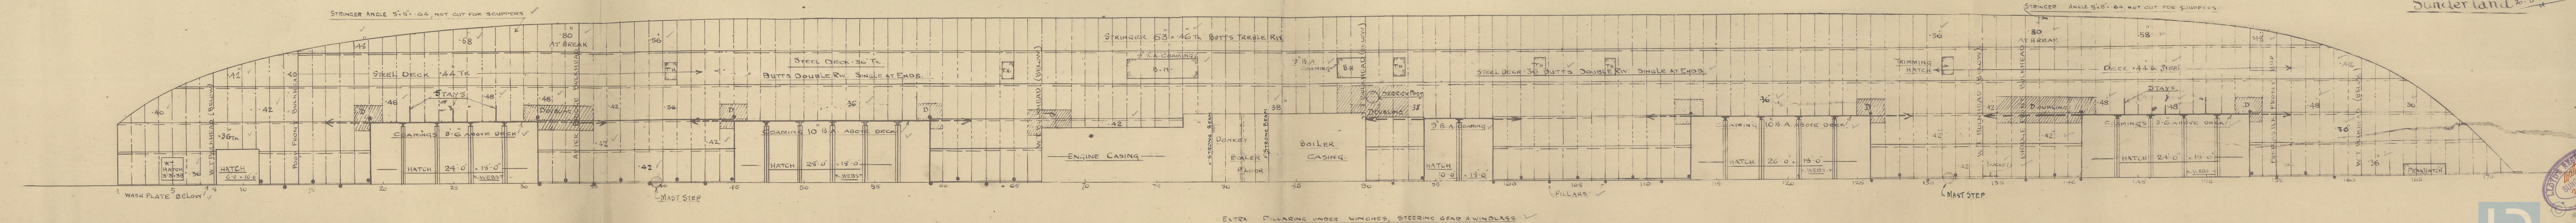

Tul

"ECATERINI MATSOUKI"

DECK PLAN

(AS FITTED)

S. S. N^o 231

J. PRIESTMAN & CO

SLD RPI N^o 25810

W48-0061



© 2020

Lloyd's Register
Foundation