



27.9.12  
17.12.12  
28.2.13

# DECK PLANS N<sup>o</sup> 231<sup>s</sup>.


SCALE  $\frac{1}{8}$  = ONE FOOT

BRIDGE


POOP

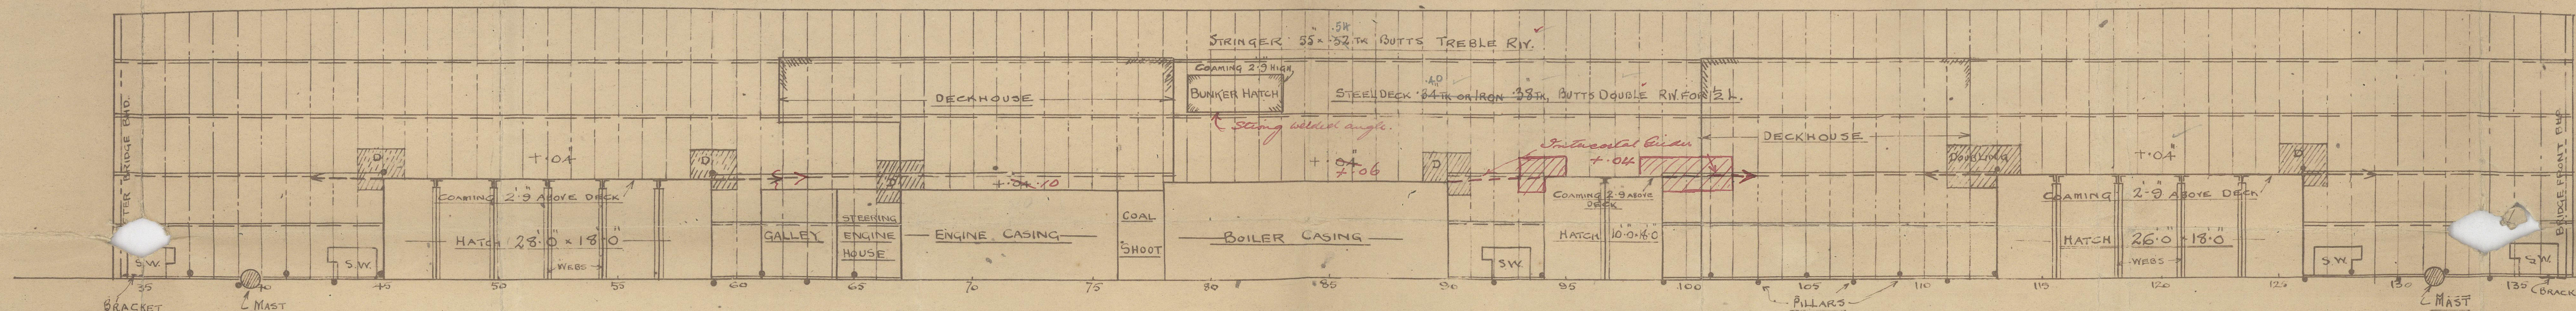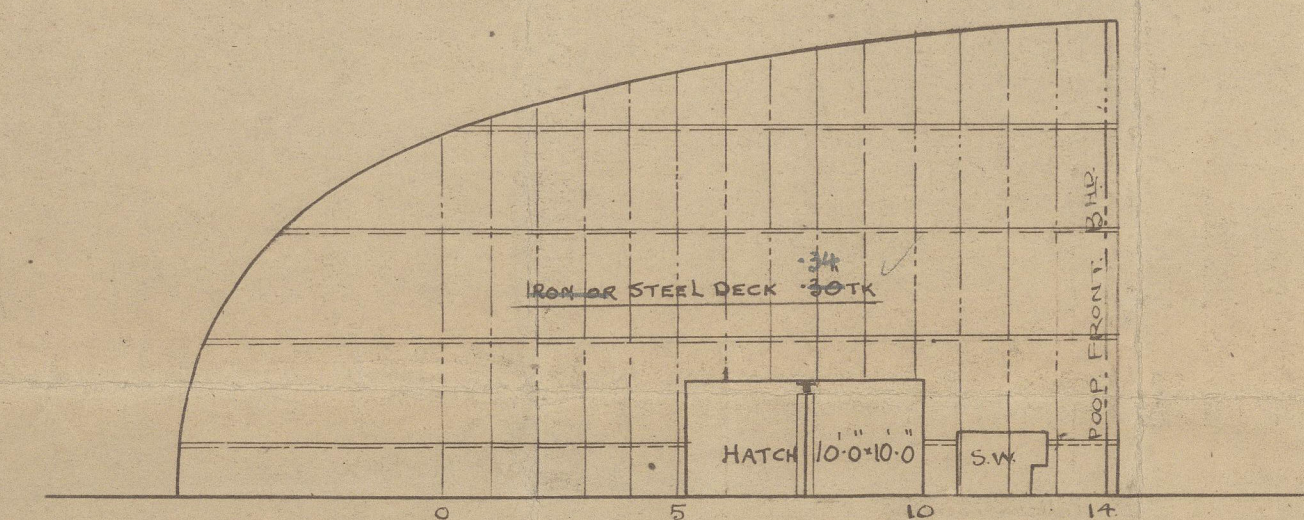

FORECASTLE

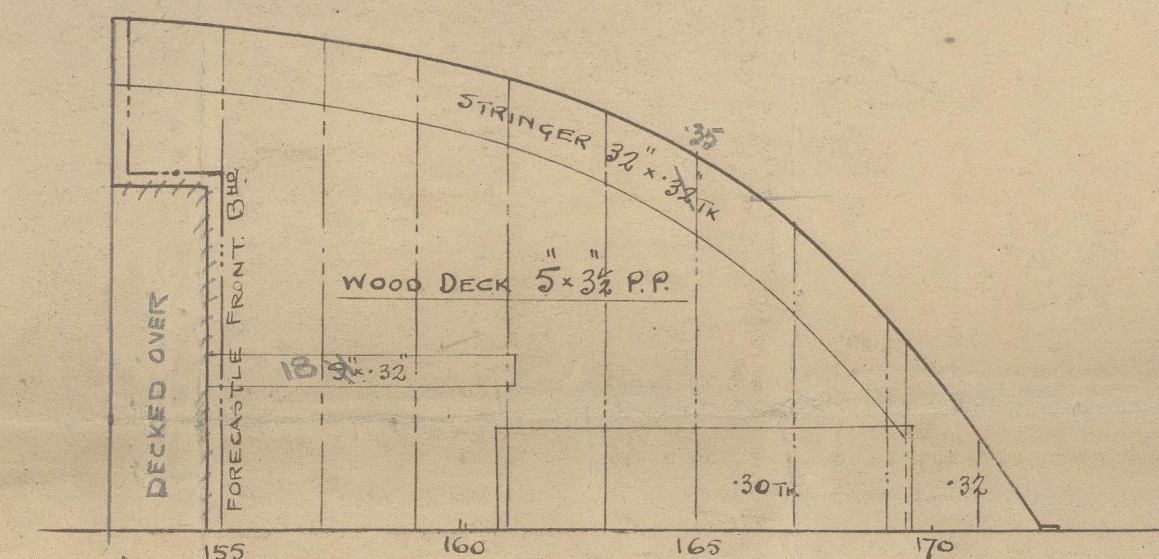

UPPER DECK

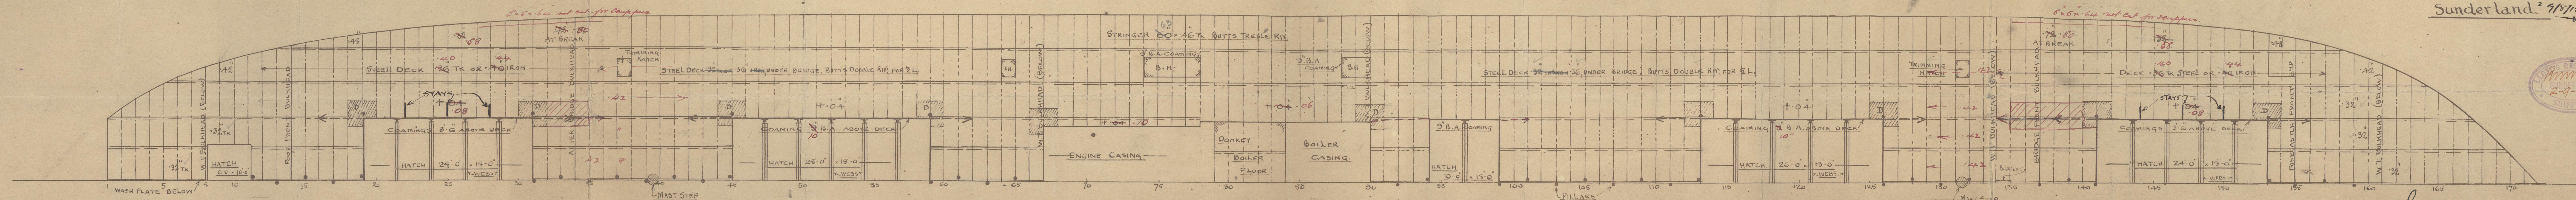

John Priestman & Co  
Shipbuilders  
Sunderland. 29/12



Extra pillaring under winches, steering gear, & windlass.

C.B.  
27.9.12



SUNDERLAND.




Deck Plan

S.S. No. 231



J. Priestman & Co.

Tul  
S.S. Ecaterini Matsouki

Sld Rpt No 25810

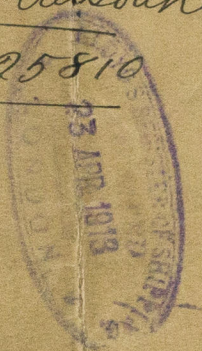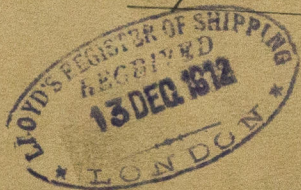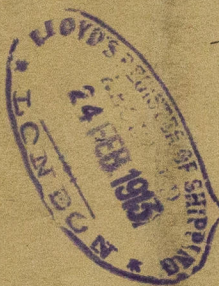

WL8-0062

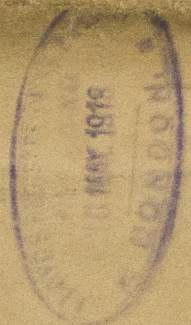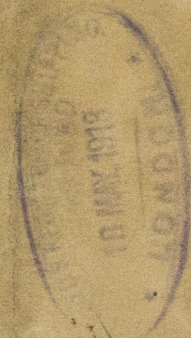

Ecaterini Matsouki



© 2020

Lloyd's Register  
Foundation