


27.9.12  
17.12.12  
28.2.13  
13.5.13

# PROFILE N<sup>o</sup> 231<sup>s</sup>/<sub>s</sub>

SCALE 1/8" = ONE FOOT

DIMENSIONS  
LENGTH B.P. .... 345'-0"  
BREADTH EV. .... 48'-0"  
DEPTH MLD. .... 23'-10"  
23-6

JOHN PRIESTMAN & Co.,  
Shipbuilders,  
SUNDERLAND.  
27/9/12

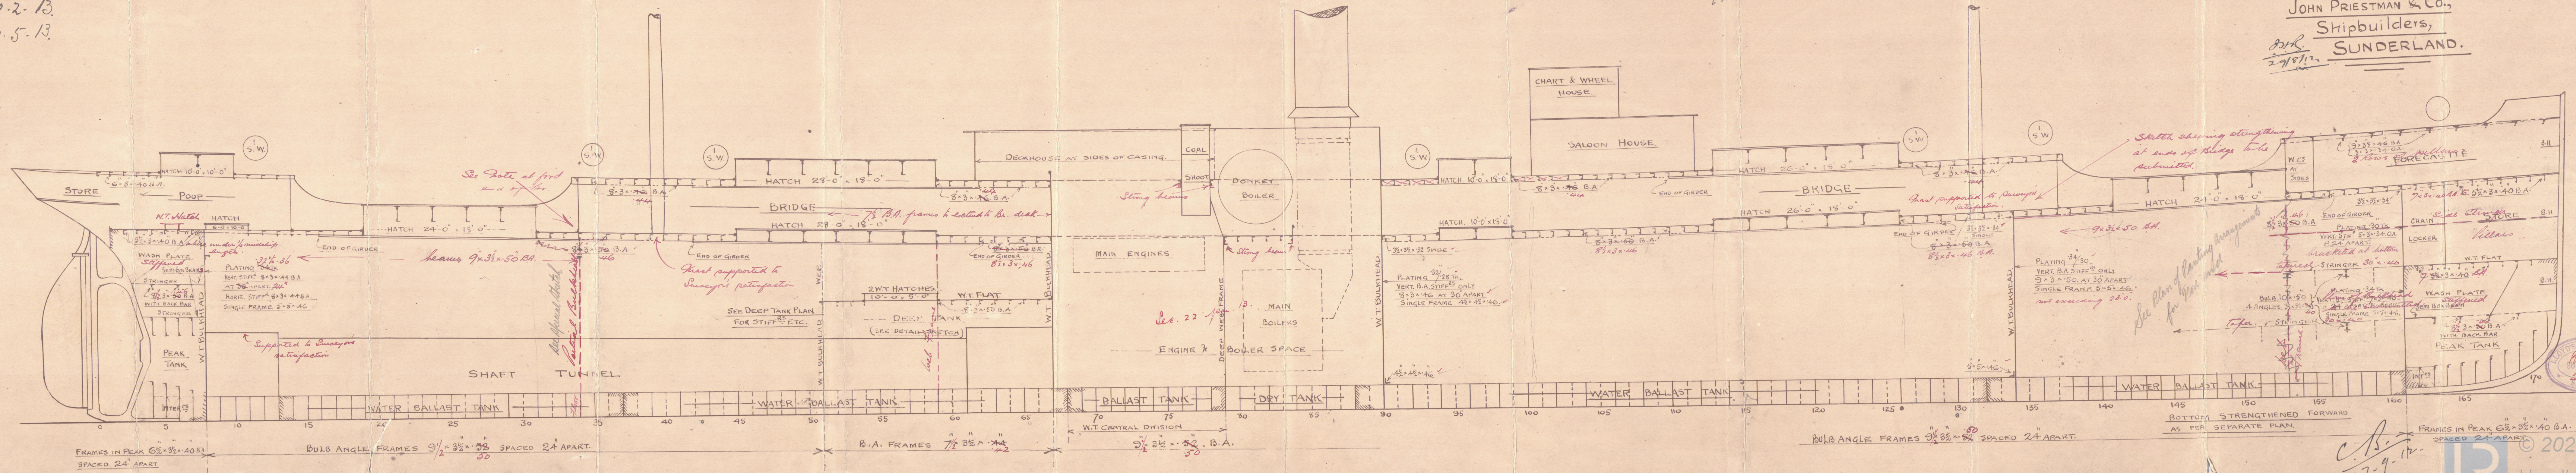



SUNDERLAND.

Eкатери́ни Матзо́нки

Profile





Nº. 231

J. Priestman & Co.

"Gine."

S.S. Eкатери́ни Матзо́нки

Sld Rpt Nº 25810

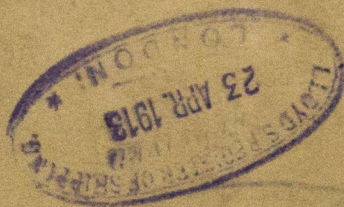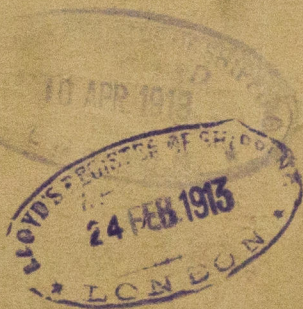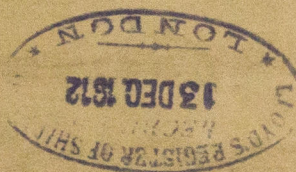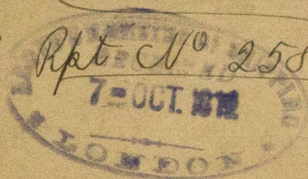

© 2020

Lloyd's Register  
Foundation

W48-0064