

S. S. ECATERINI MATSOUKI.

SCALE $\frac{1}{2}$ = ONE FOOT.

CLASS 100 A1 LLOYDS.


- DIMENSIONS -

LENGTH B.P.-----345.0 ✓
BREADTH EXT.-----48.0 ✓
DEPTH MLD.-----23.6 ✓

POOP SCANTLINGS.
BEAMS 6" 3.40 B.A. ON EVERY FRAME. ✓
STRINGER 34TK STRINGER ANGLE 3 $\frac{1}{2}$ " 3 $\frac{1}{2}$ " 34 ✓
STEEL DECK 34TK SIDE PLATING 36TK ✓
ONE ROW OF PILLARS 2 $\frac{3}{4}$ " DIAM: ✓

FORECASTLE SCANTLINGS.

BEAMS 3.3.340A) ON ALT^E FRAMES ✓
STRINGER 32.35 TK STRINGER ANGLE 32.32.54 ✓
WOOD DECK 5.32 PP SIDE PLATING .38 TK ✓
2 ROWS OF PILLARS 22 DIAM: ✓
TIE PLATE 18".32 TK ✓

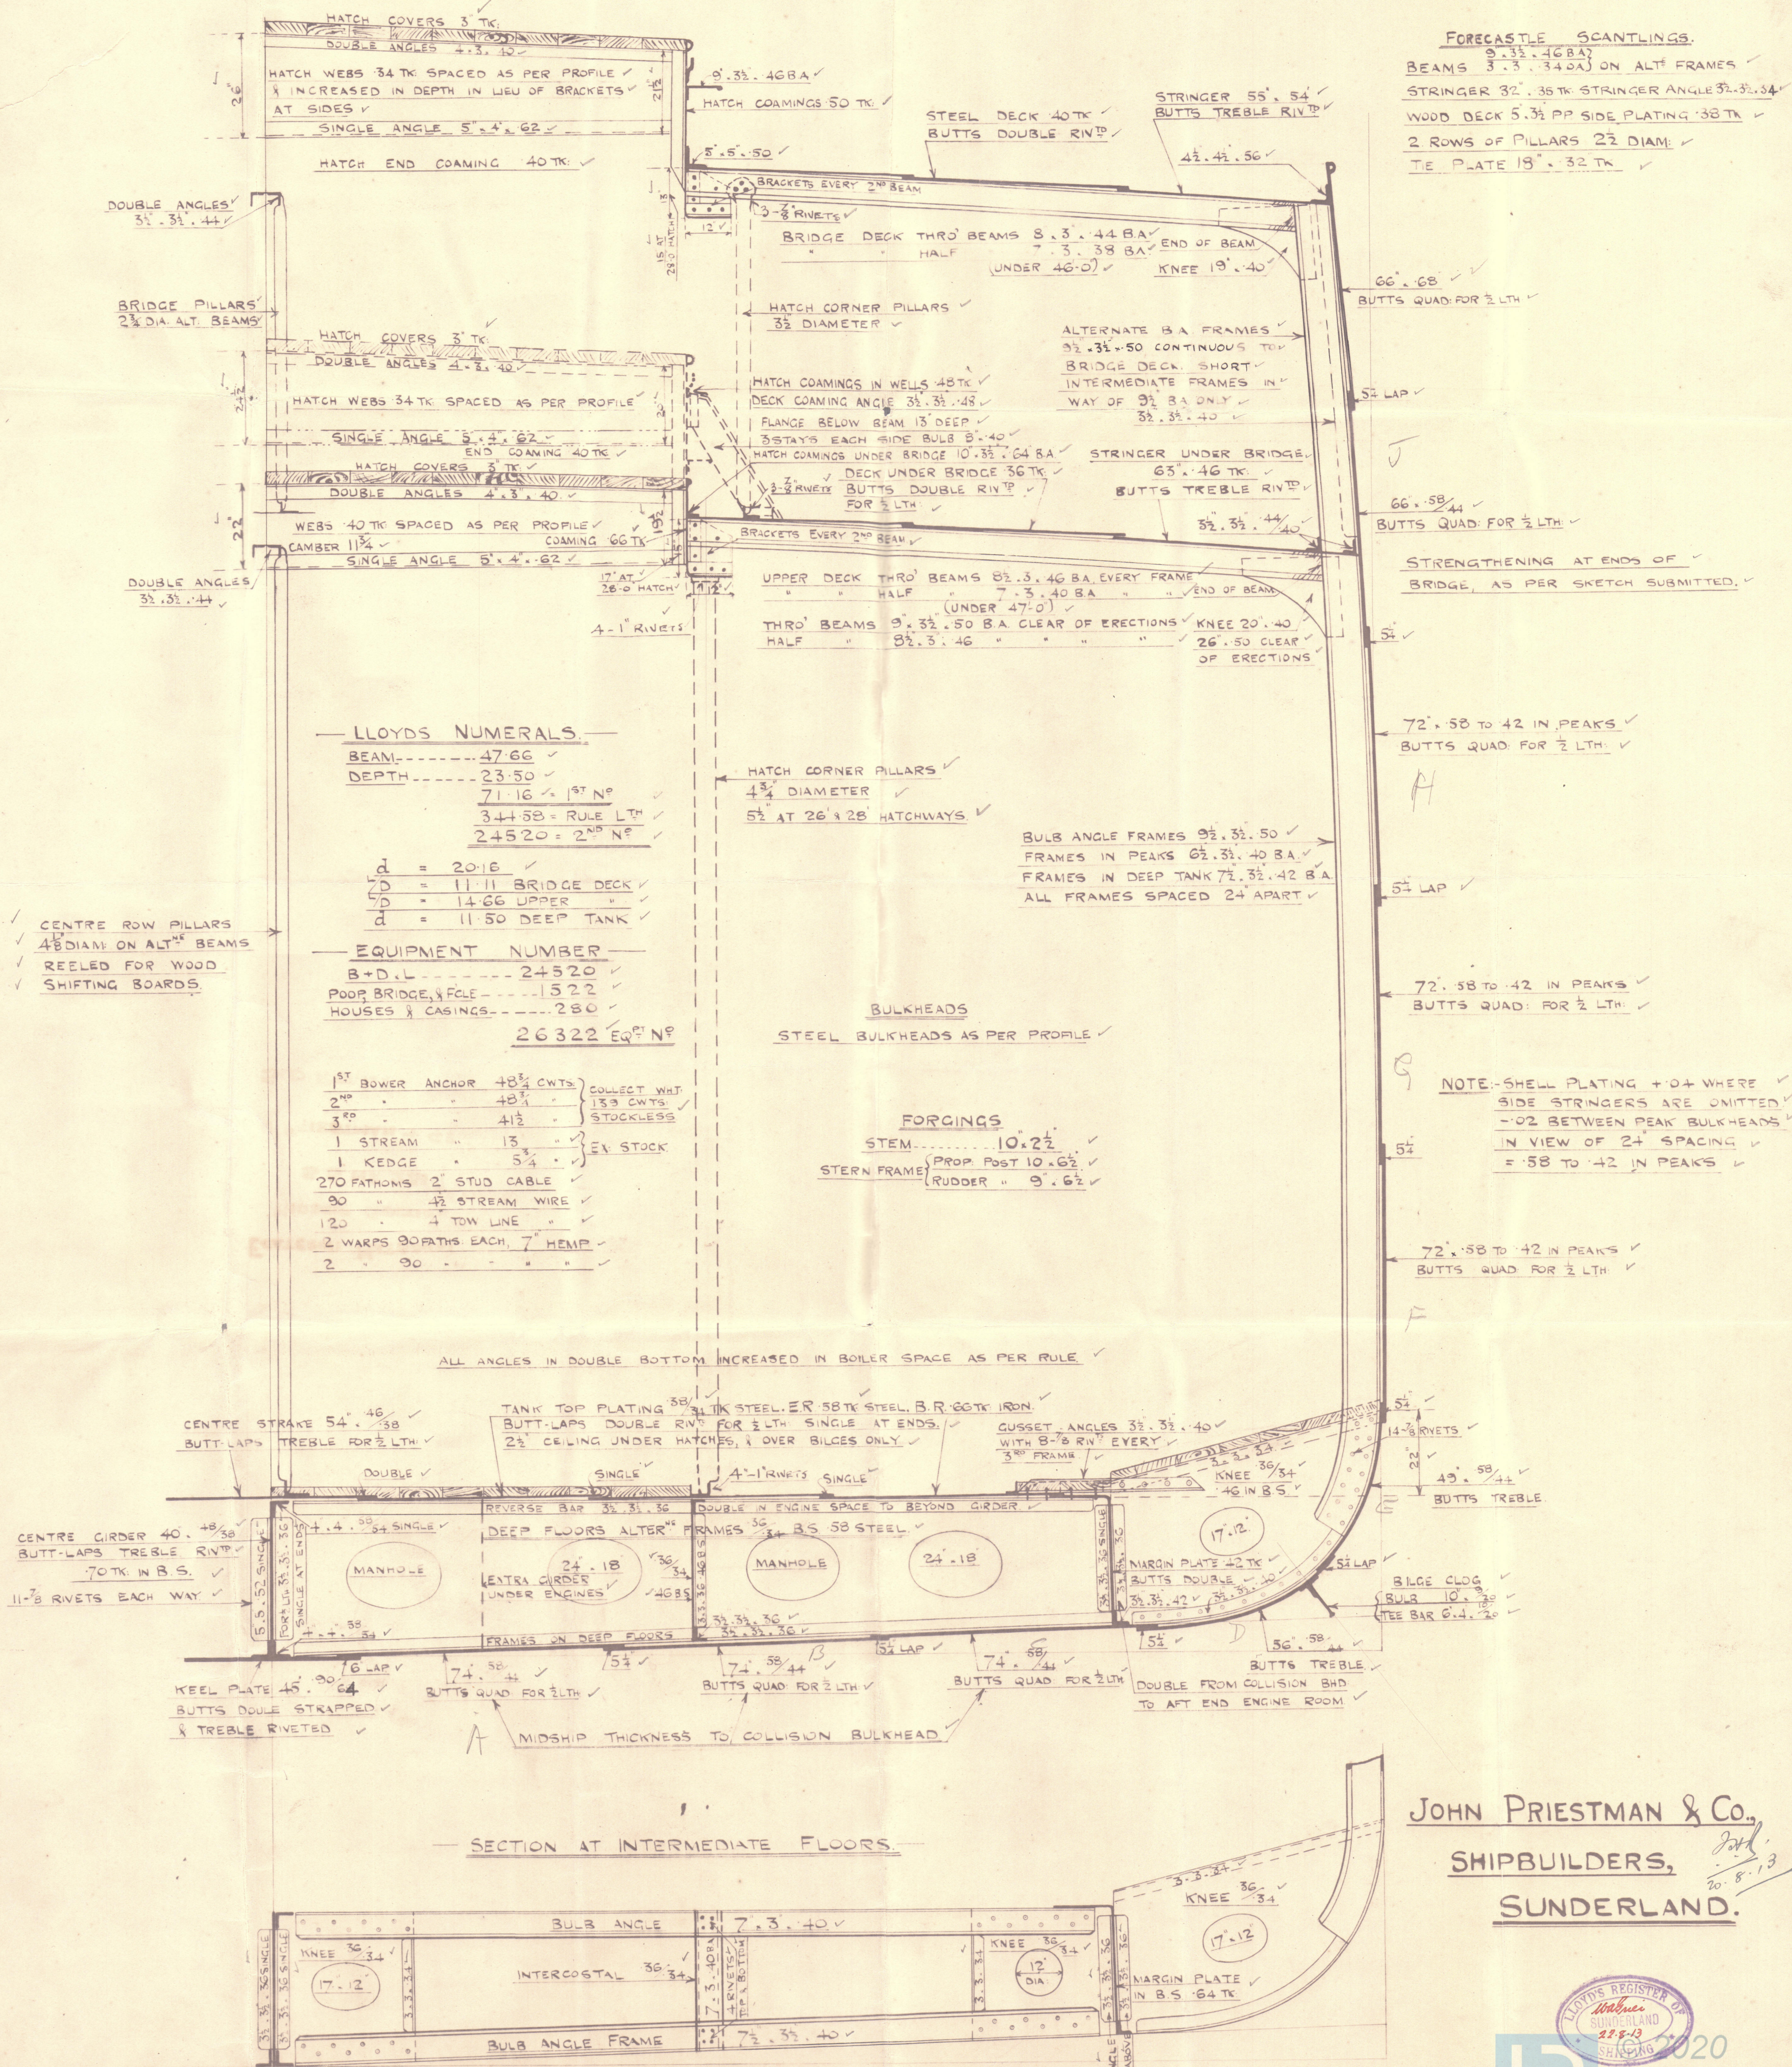

JOHN PRIESTMAN & Co.
SHIPBUILDERS,
SUNDERLAND.

Nº 231.

W48-0065

"*Paul*"
ex
"ECATERINI MATSOUKI"

MIDSHIP SECTION
(AS FITTED)
S.S. N^o 231

J. PRIESTMAN + C^o

SLO RPT N^o 25810.

W48-0065



© 2020

Lloyd's Register
Foundation