


**Nº 127** *SHIP.*

S.S. "DACAPO."

SCALE  $\frac{1}{4}'' = 1 \text{ FOOT}$

RAISED QUARTER DECK.

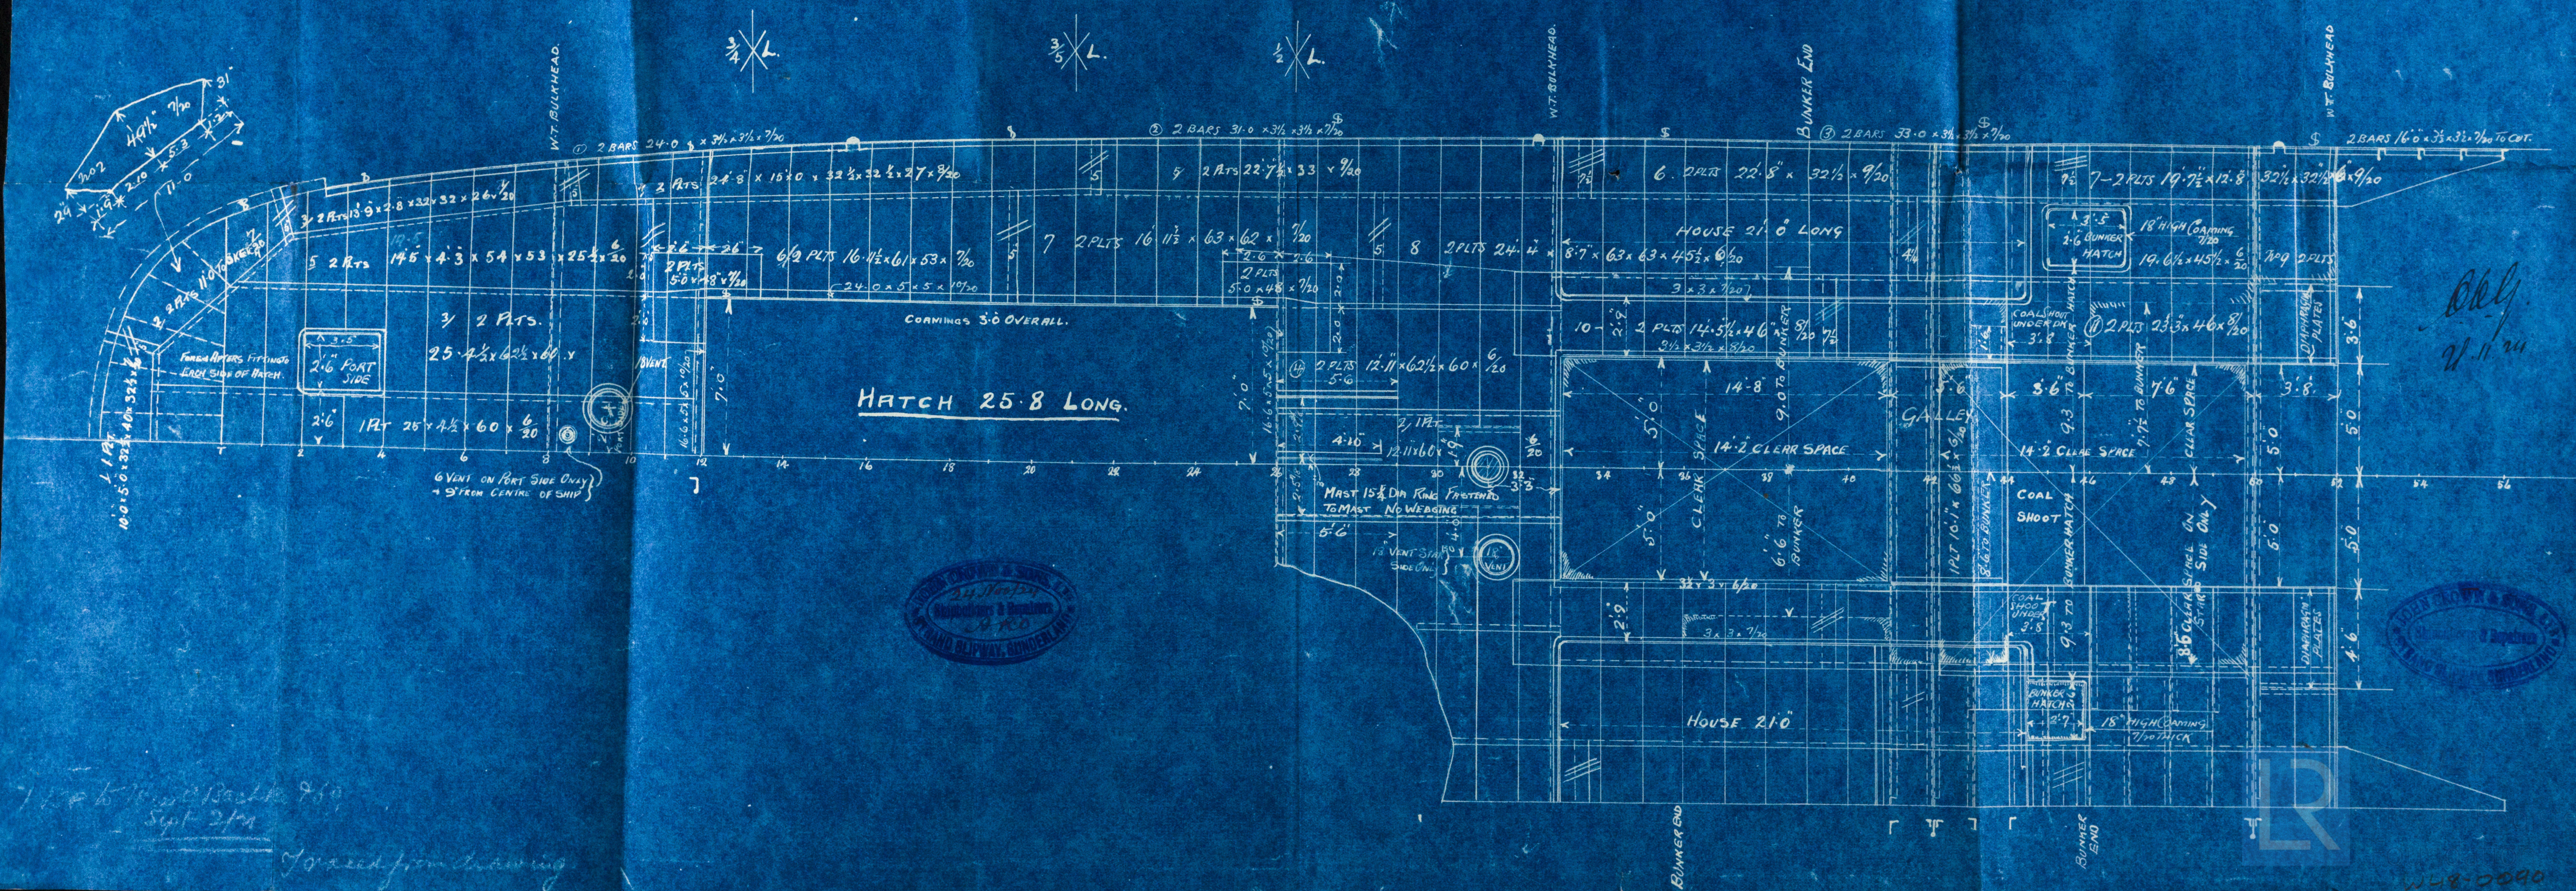





S/S "KALUA" (EX "DACAPO")

Gross 14237.

RAISED QUARTER DECK.



W48-0090

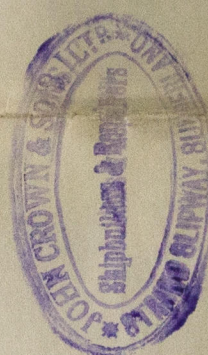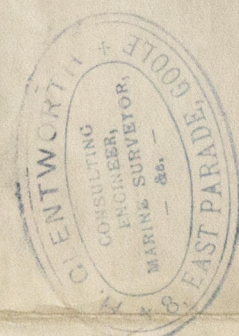

© 2020

Lloyd's Register  
Foundation