


10041  
 TO CLASS Y.A.1 - NORWEGIAN VERITAS.


# LONGITUDINAL ELEVATION S.S. No 127.

S.S. KALUA (EX DACAPO)

SCALE 1/8" = 1 FOOT.

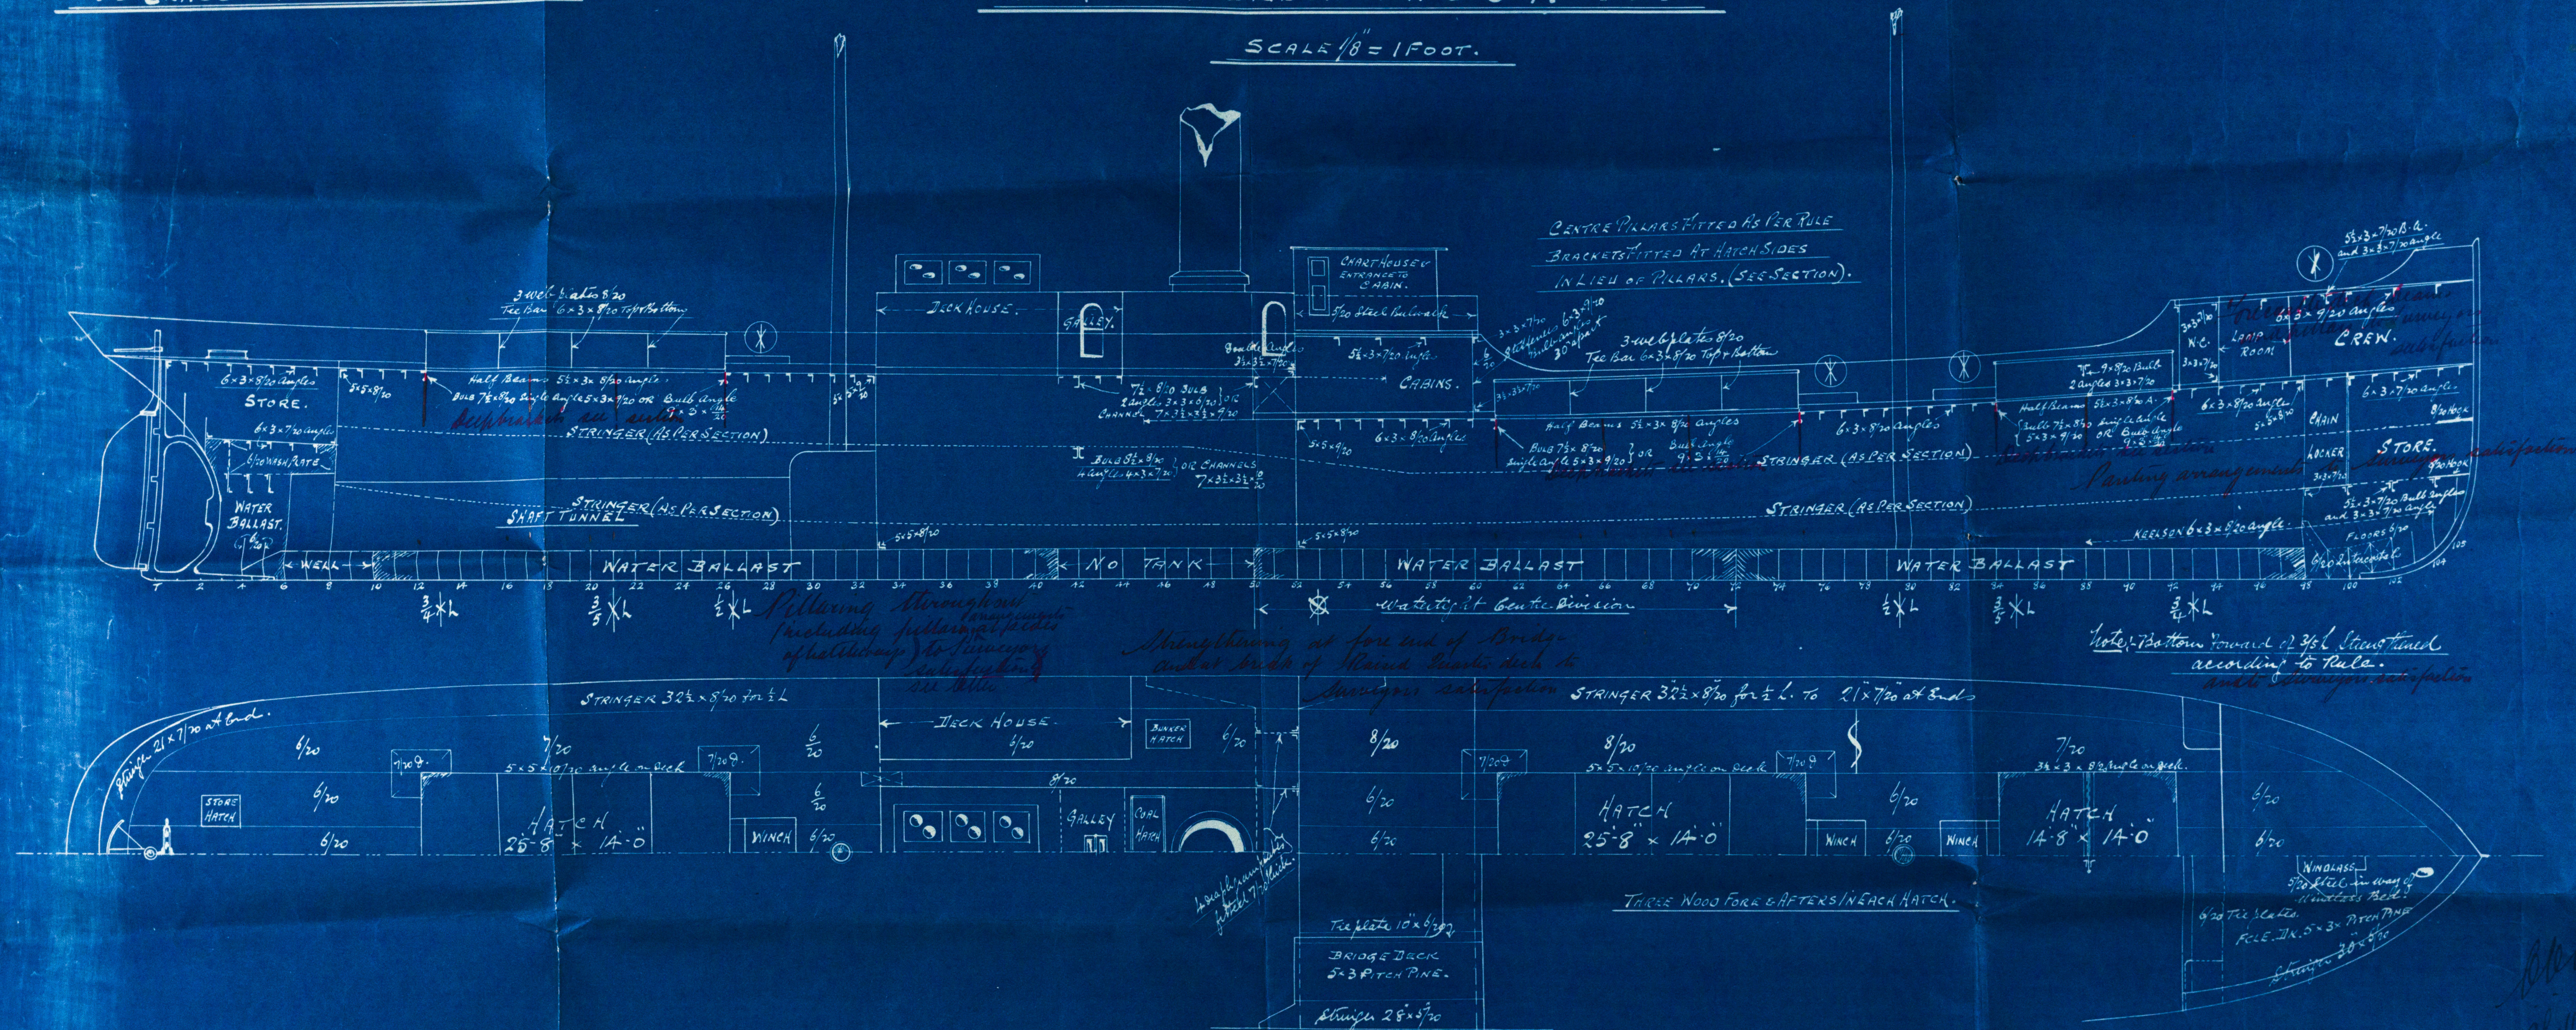

 Shipbuilders  
 Sunderland.  
 Nov. 21<sup>st</sup> 1907. als.

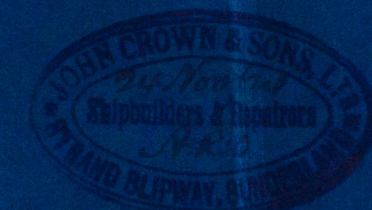

Locating as per Rule  
 See frames 3 1/2 x 3 x 6/20.



10041-8771



S/S KALUA (Ex DACAPO) Gms. 14237.

LONGITUDINAL ELEVATION

W48-0091

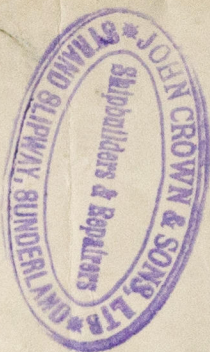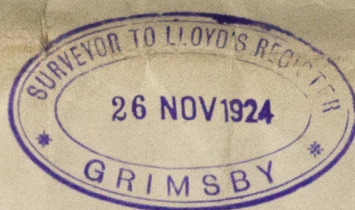

© 2020

Lloyd's Register  
Foundation