


No 127 SHIP.

1 Stream Anchor	$5\frac{1}{2}$	Bots & Stock.
1 Kedge "	$2\frac{3}{4}$	" " "
210 Fathoms	$1\frac{5}{16}$	Stud Chain Cable.
90 "	9"	Kemp or 3" Steel Wire.
Two 90 "	7"	or $2\frac{1}{2}$ " "
Two 90 "	5"	or $1\frac{3}{4}$ " "
60 "	$3\frac{1}{4}$	steel stream wire.

TO CLASS ~~XA.1~~ ~~NORWEGIAN VERITAS (STEEL)~~  
100 A1. SCALE  $\frac{1}{2}'' = 1$  FOOT.

S. S. KALUA  
EX "DACAPO."

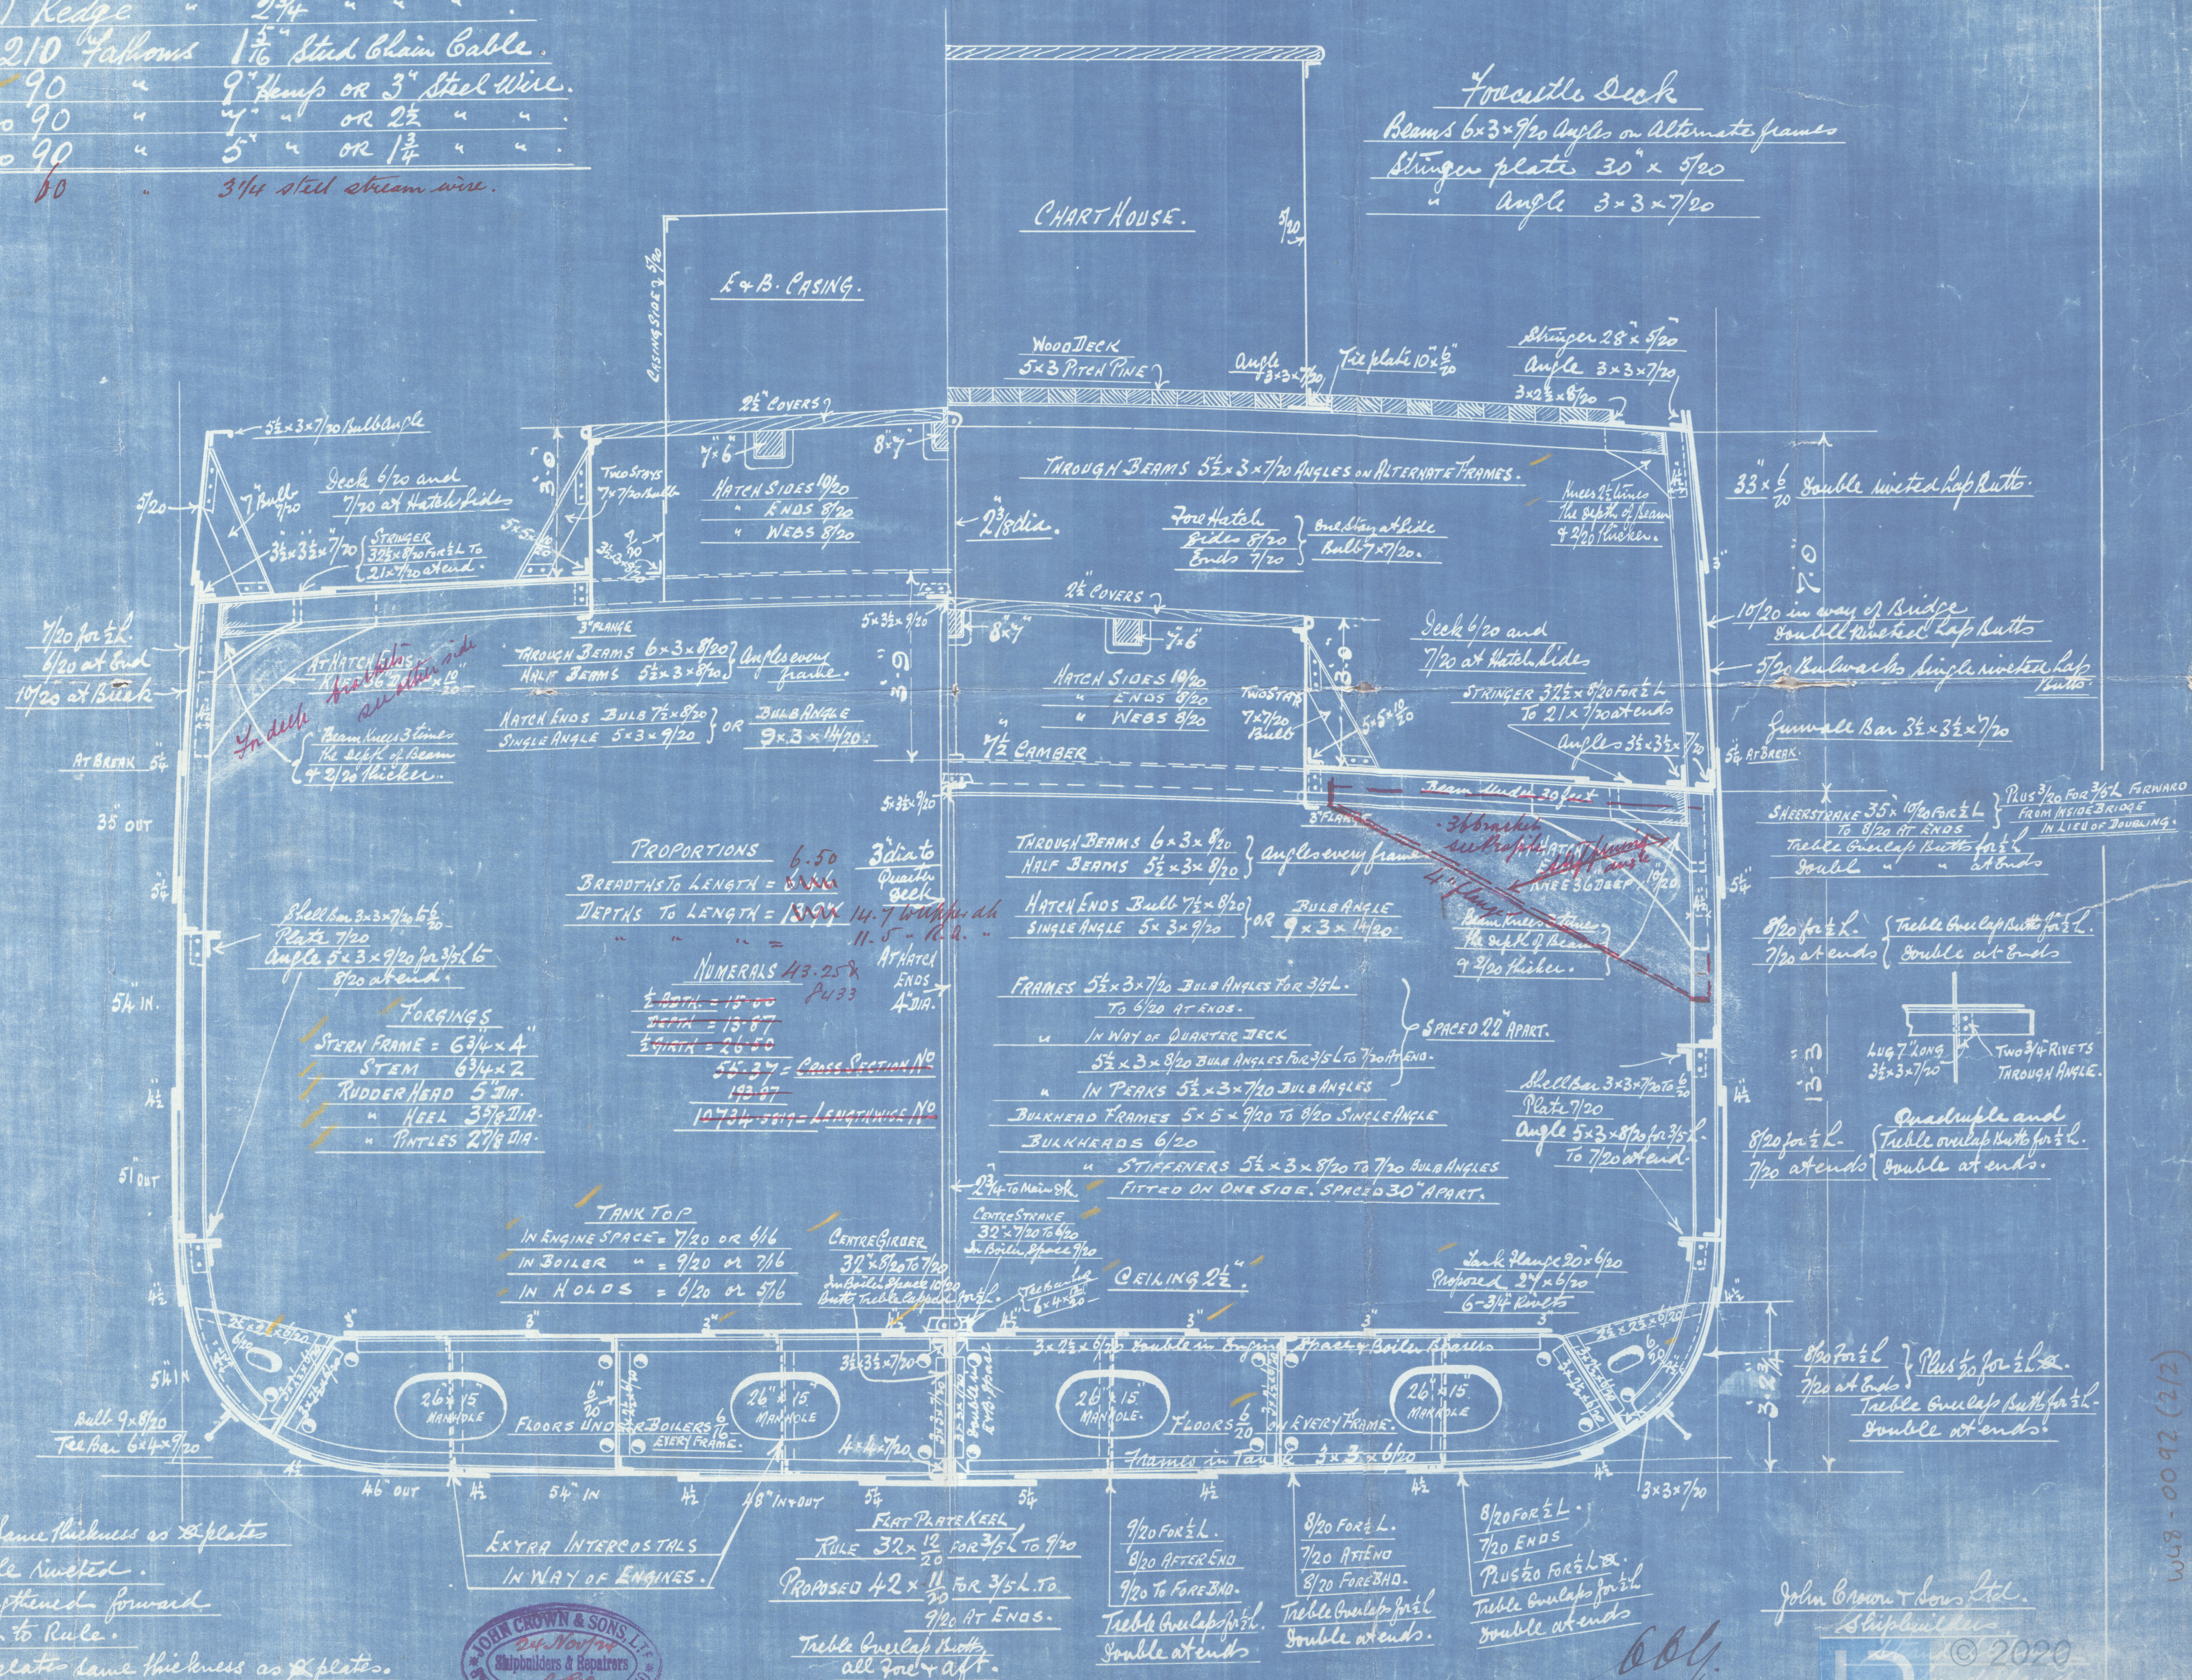

Boss plate same thickness as  $\phi$  plate  
and double riveted.  
Bottom strengthened forward  
according to Rule.  
After End plate same thickness as  $\phi$  plate.




© 2020  
Lloyd's Register  
Foundation



W48-0092 (1/2)

J. CROWN & SONS, LIMITED, SUNDERLAND.

ENCLOSURE

FOR

H. Glentworth Esq  
Marine Surveyor  
Goole.

EQUIPMENT No ~~1882~~. 9133

1 Bower 19 Cwts. Stockless

1 " 19 " "

1 " 16½ " "

Collective 54½ Cwts Stockless.

1 Stream Anchor 5½ Cwts &c Stock.

1 Kedge " 2¾ " " "

210 Fathoms 1½" Stud Chain Cable.

90 " 9" Hemp OR 3" Steel Wire.

Two 90 " 7" " OR 2½ " "

Two 90 " 5" " OR 1¾ " "

60 " 3¼" steel stream wire.

## MIDSHIP SECTION

LENGTH B. PERPS.....195'-0"

BREADTH MOULDED.....30'-0"

DEPTH MOULDED.....13'-3"

TO CLASS ~~1 A. 1~~ ~~NORWEGIAN VERITAS~~ (STEEL)

100 A1. SCALE ½" = 1 FOOT.



© 2020

CHART HOUSE

Register  
Foundation

E & B. CASING.





S/S "KALUA" (EX "DACAPO")

Gms. 14237.

MIDSHIP SECTION



W68-0092

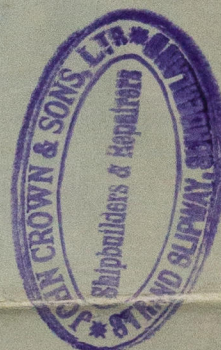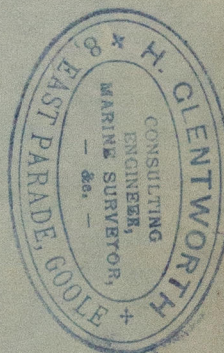

© 2020

Lloyd's Register  
Foundation