



LIST OF PIPES.

N°	PURPOSE	BORE	MATERIAL	N°	PURPOSE	BORE	MATERIAL	N°	PURPOSE	BORE	MATERIAL

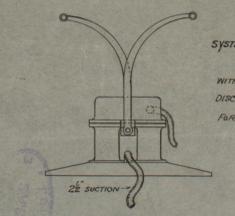

SYSTEM OF HAND PUMPING AS ARRANGED TO SUIT OWNERS
 3 PORTABLE WEEGEE HAND PUMPS
 WITH 2 1/2" FLEXIBLE SUCTIONS, AND OVERBOARD
 DISCHARGES, AS PER SKETCH
 FOR PUMPING OUT HOLDS THROUGH HATCHES

19/4/13

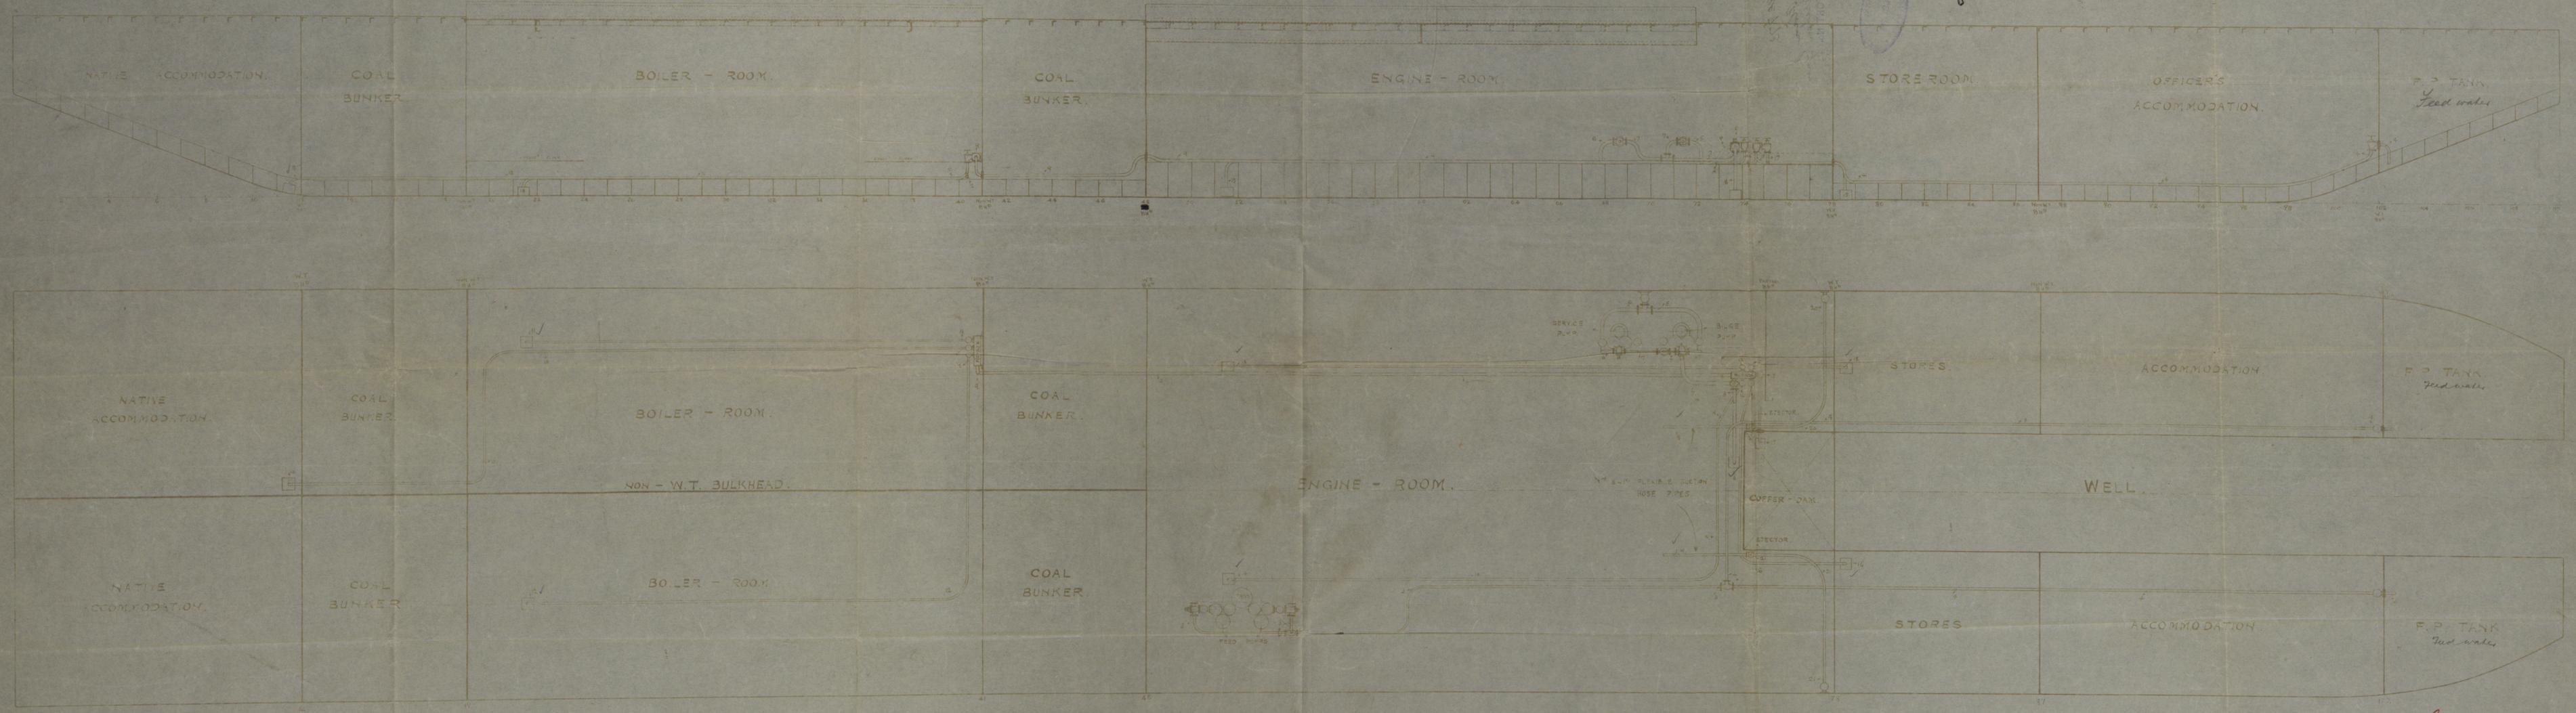

BILGE PUMPING ARRANGEMENT N° 773.

SCALE 1/4" = ONE FOOT.


LOHNITZ & CO. LTD. LONDON
 No. 773

Handwritten signature and date:
 16.7.13

Lobnitz & Co. No 773.

Pumping "Plan Lynn"

GLASGOW REPORT No. 33440

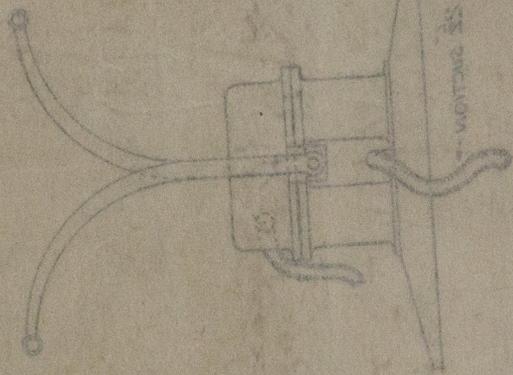


W480-0037

RECEIVED



© 2020

Lloyd's Register
Foundation