


SCALE = $\frac{1}{8}" = 1 \text{ FOOT.}$

 

SUNDERLAND

MESS^{RS} BARTRAM & SONS L^D


PROFILE (AS BUILT)

No. 236

S.S. "HARTFIELD"

L^D. REPORT No. 26442

RETAIN

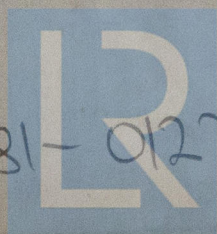

© 2020

W481-0123 Lloyd's Register
Foundation