



S.S. No 263
PROFILE & DECK PLAN

CLASS - 100 A1 LLOYDS


SCALE ~ $\frac{1}{4}" = 1 \text{ FOOT}$

<u>DIMENSIONS</u>		
LENGTH	B.P	162' 0"
BREADTH	M.L.D	25' 6"
DEPTH	"	12' 0"


See also plan approved 28/7/14 -

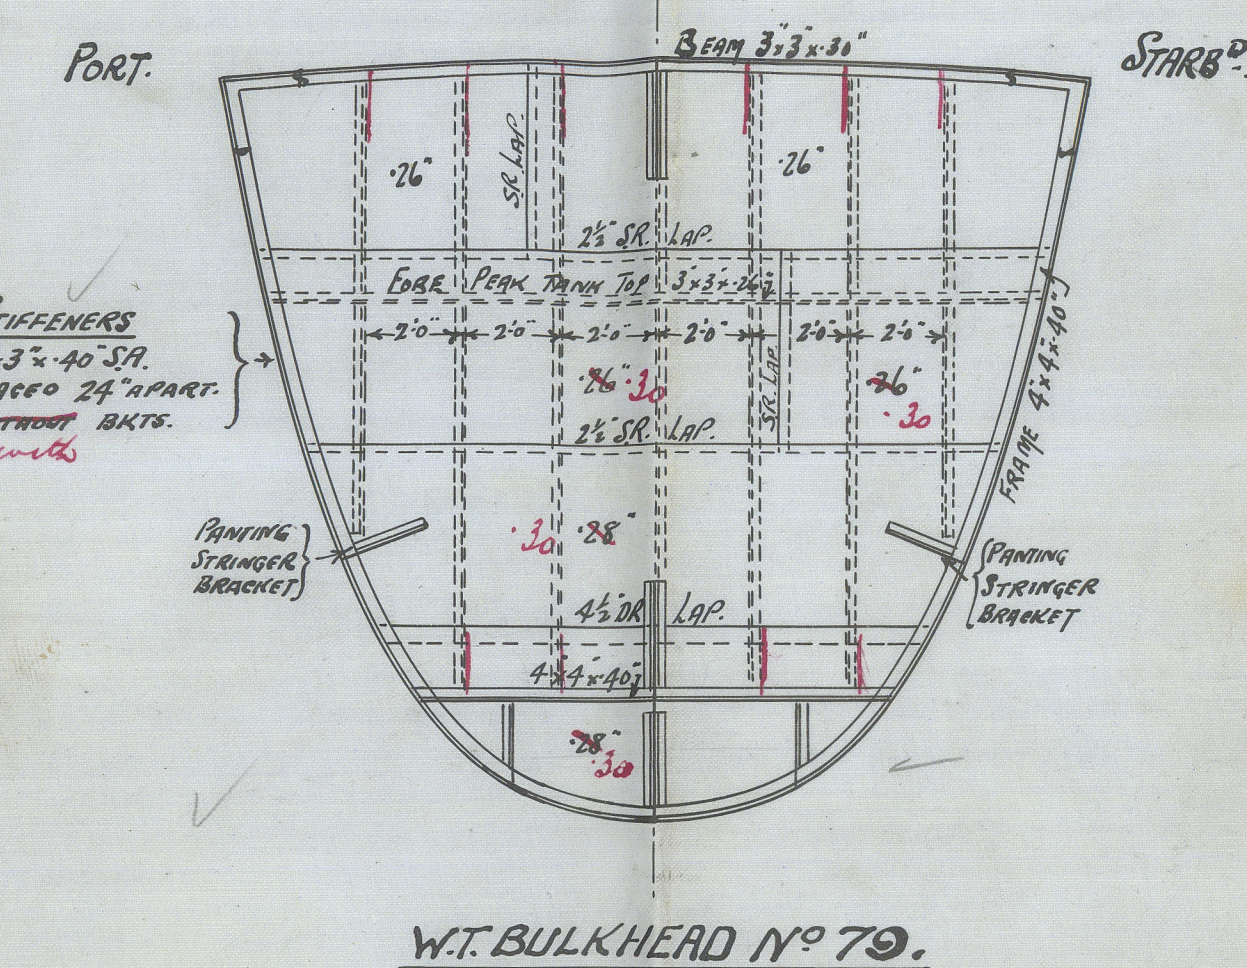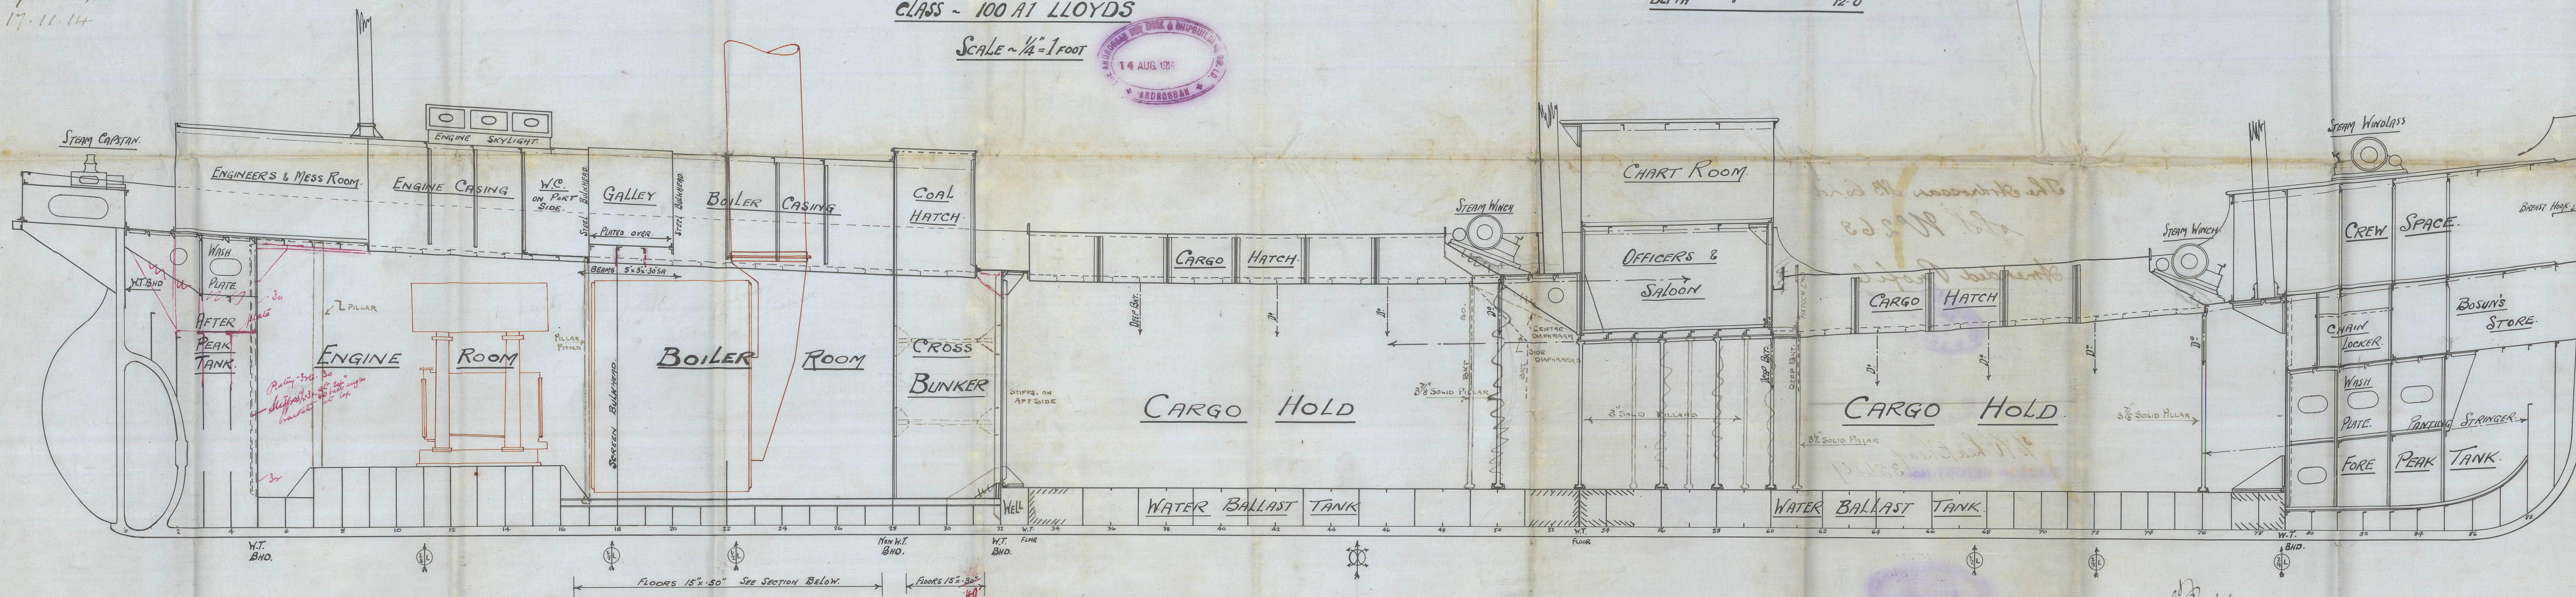


QUARTER DECK.

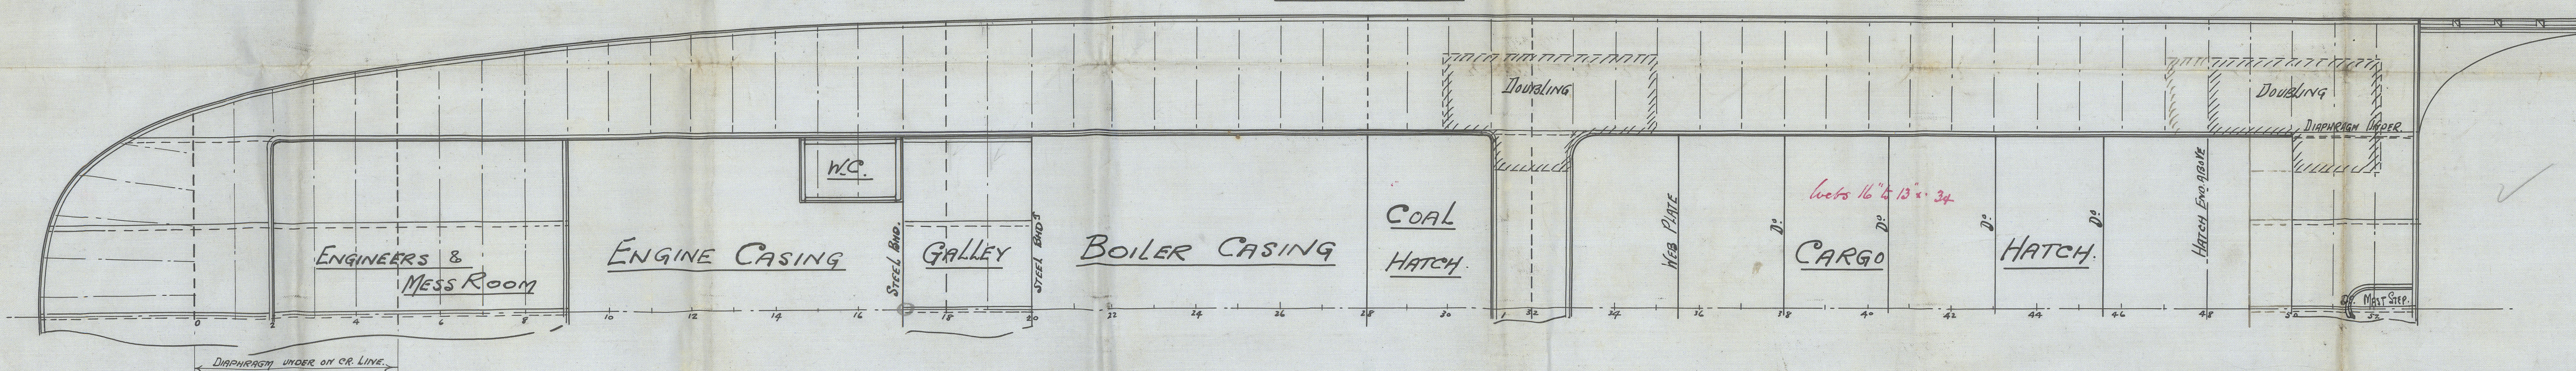


BRIDGE DECK.

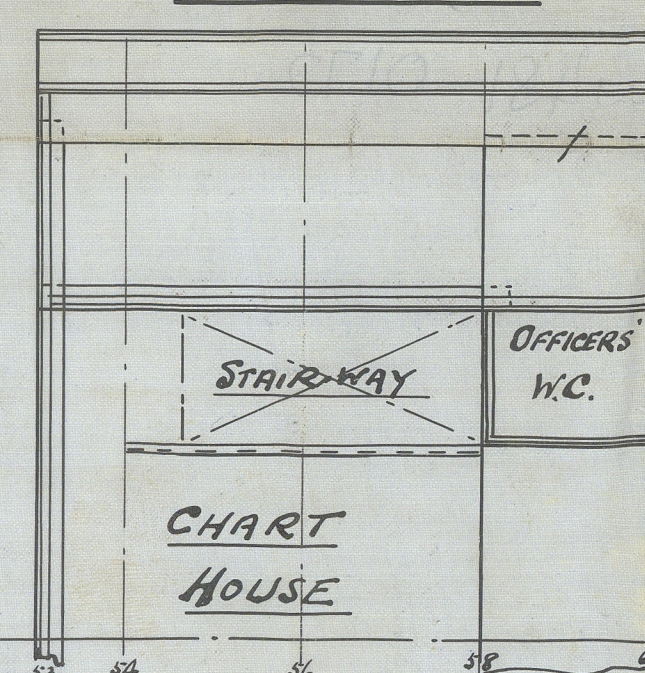


FORECASTLE DECK.

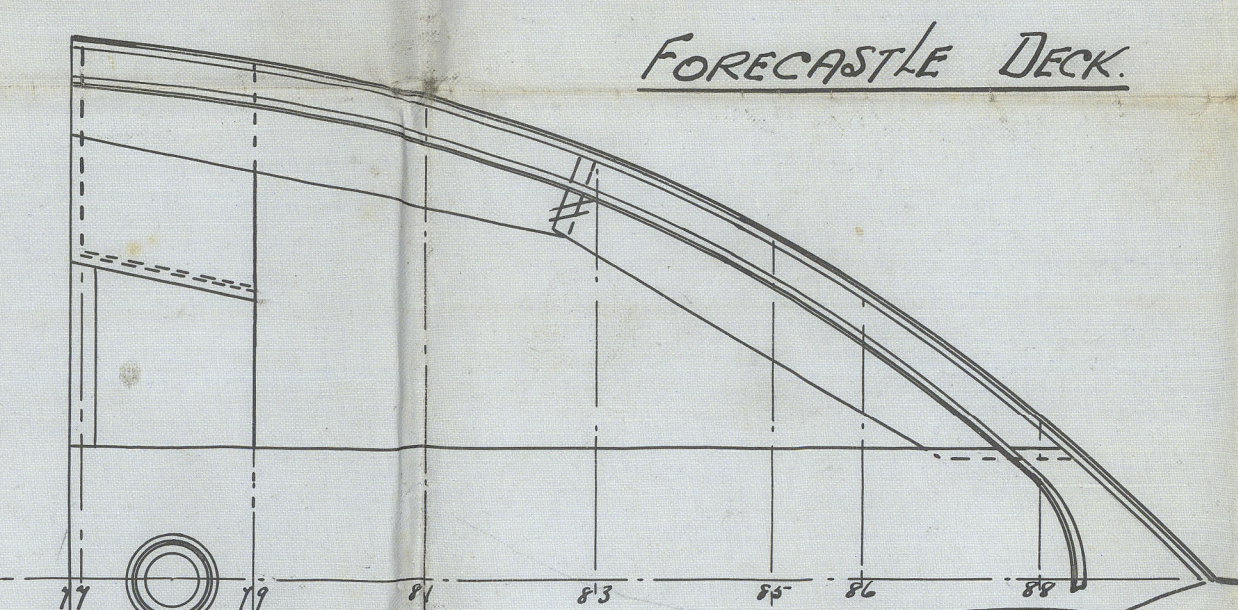

MAIN DECK.

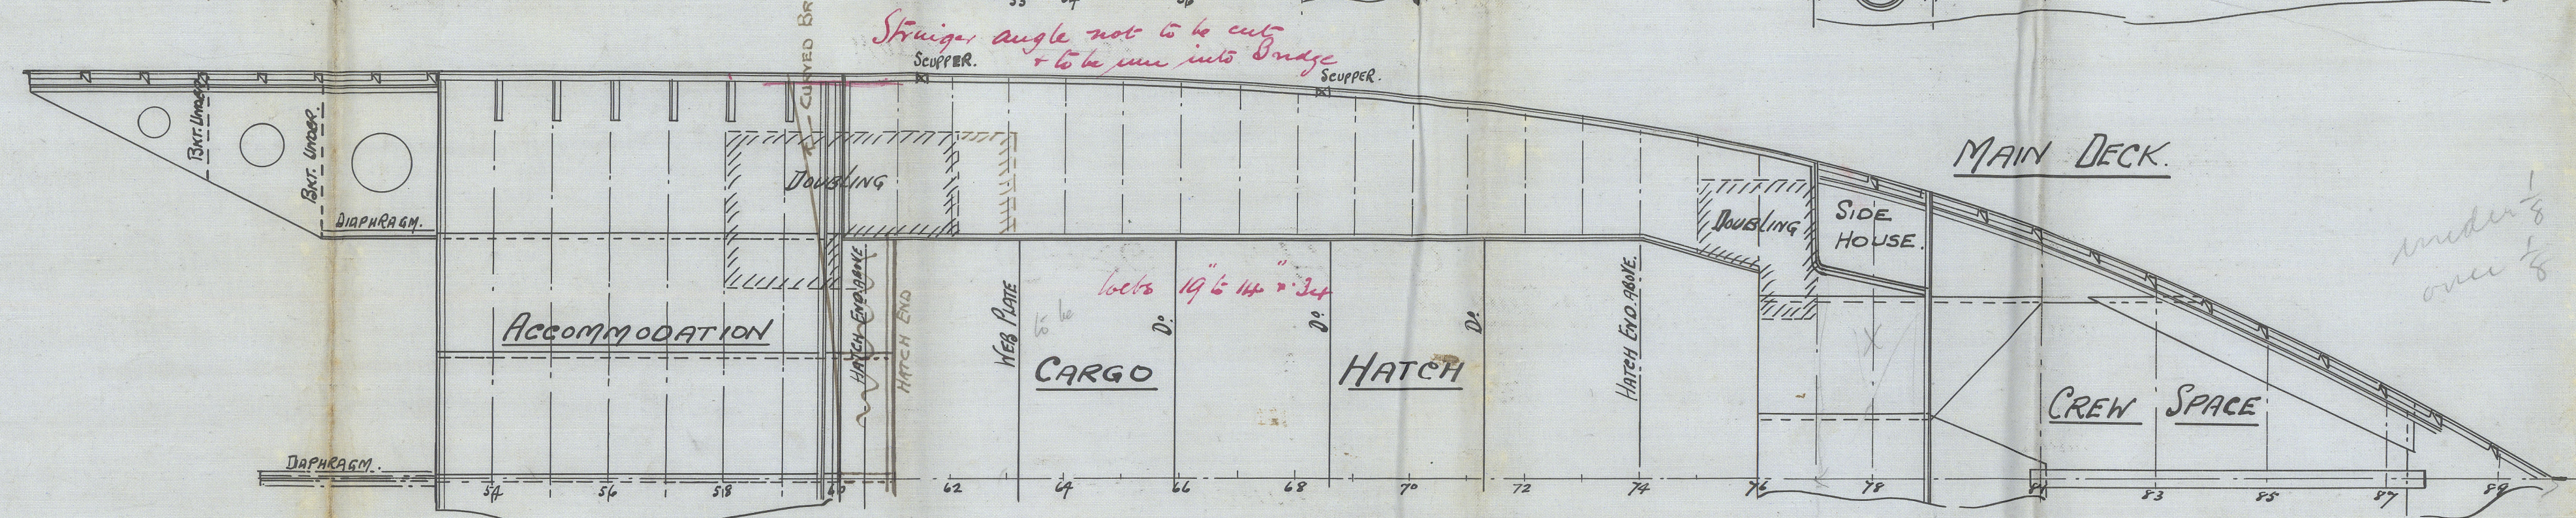

FORE PEAK TANK TOP.

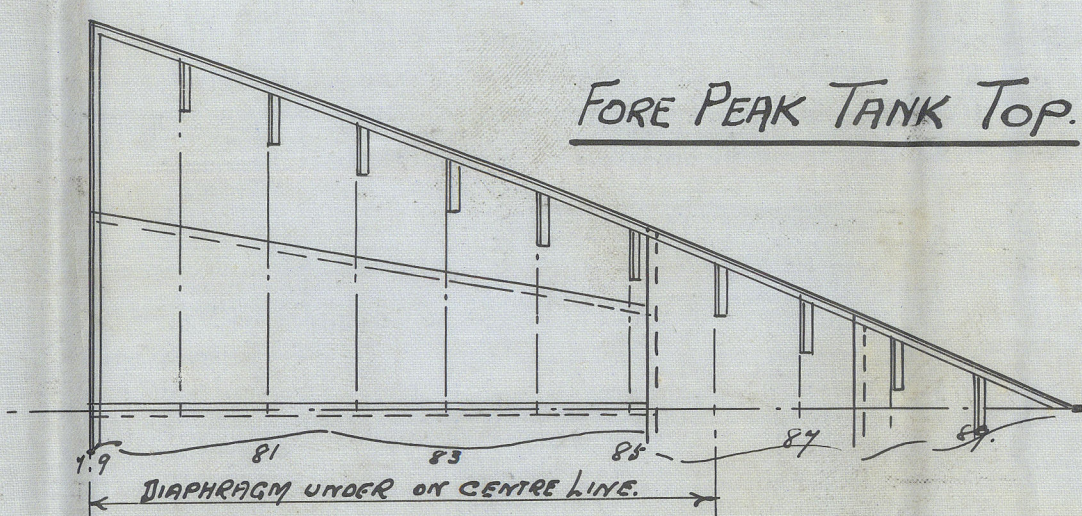


SECTION IN WAY OF BOILER ROOM



The Ardrossan S.B. Co. Ltd.

S.S. W^o 263

Amended Profile.

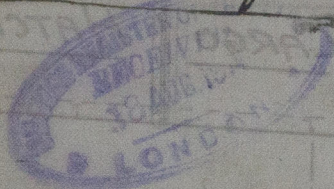

Wheatheaf
GLASGOW REPORT No. 35489



© 2020

Lloyd's Register
Foundation

w481-0172