


COCHRAN PATENT VERTICAL MULTITUBULAR BOILER.

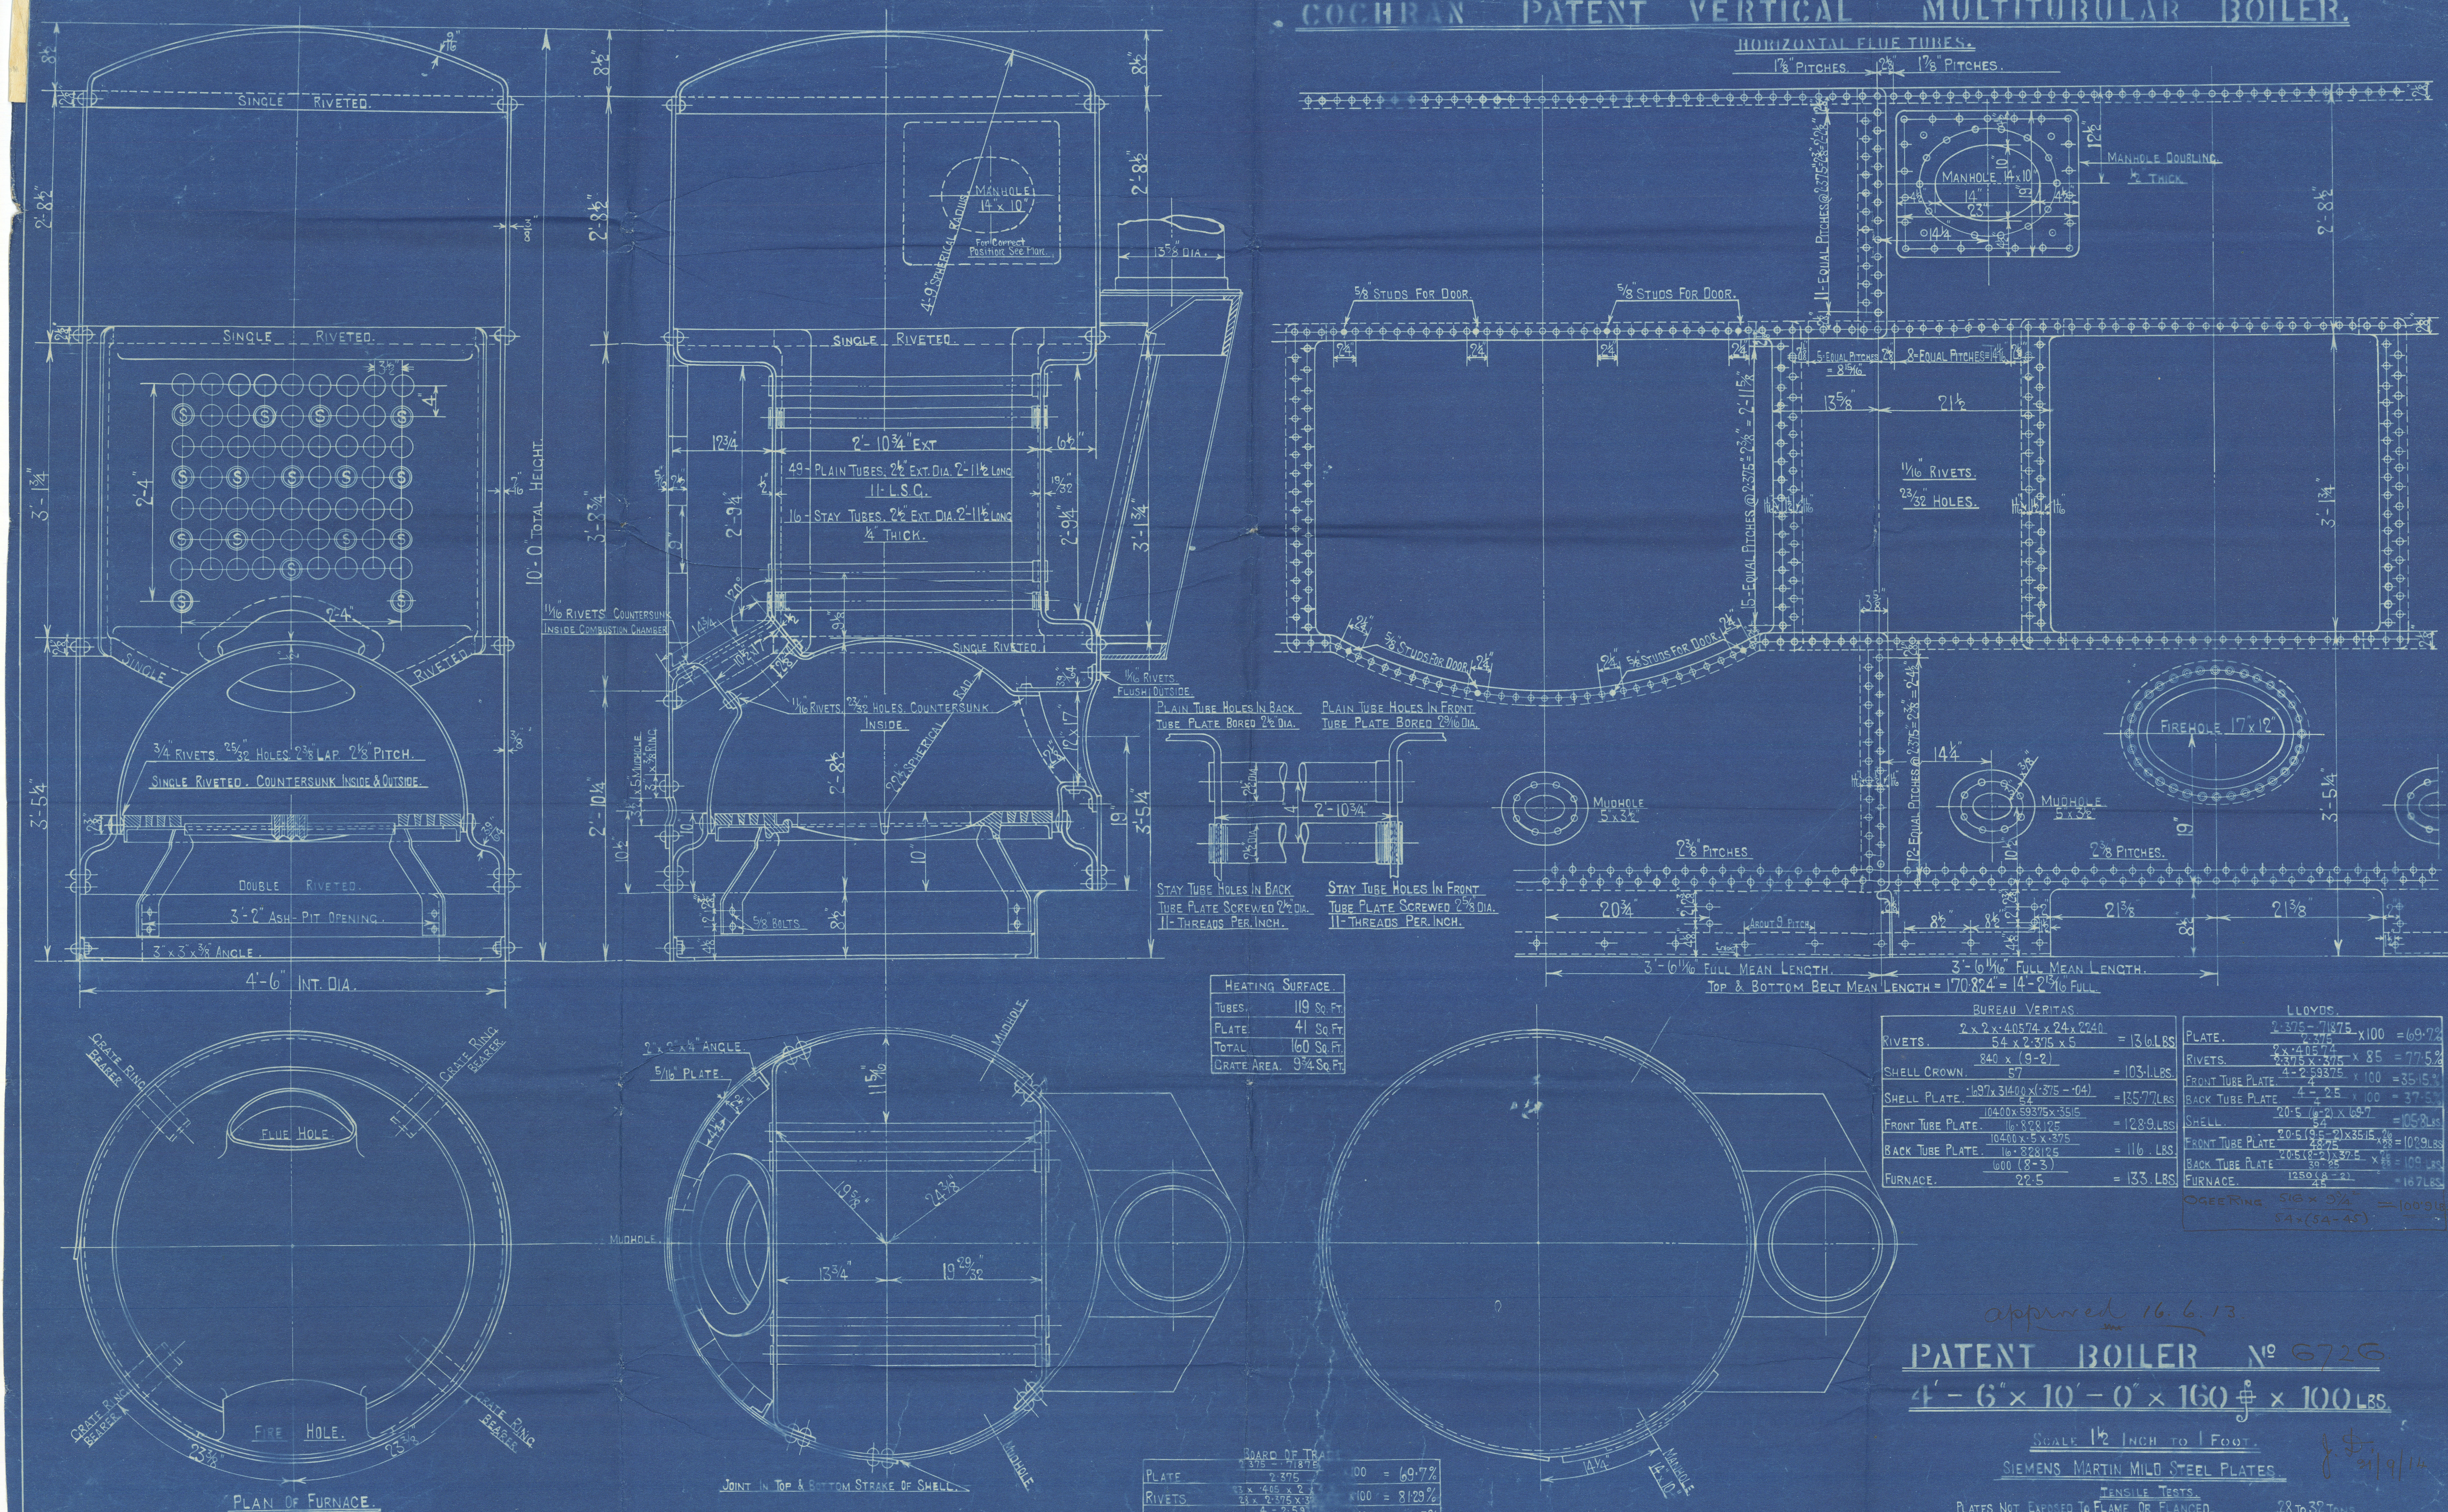

PATENT BOILER N^o 6726

$$\frac{4' - 6'' \times 10' - 0'' \times 160 \frac{\text{lb}}{\text{ft}^2} \times 100 \text{ LBS}}{}$$

SCALE 1 1/2 INCH TO 1 FOOT

SIEMENS MARTIN MILD STEEL PLATES

TENSILE TESTS.

PLATES NOT EXPOSED TO FLAME OR FLANGED ----- 28 to 32 TONS.

PLATES EXPOSED TO FLAME OR FLANGED EXCEPT FOR CROWN 26 to 30 TONS.

1. FURNACE CROWN ----- 26 to 29 TONS.

COCHRAN & CO ANNAN LD

ENGINEERS & BOILERMAKERS

ANNAN, SCOTLAND.

DRAWING N° 9554

STANDARD.
SURVEY - LLOYDS.

W 481-0174(112)

COCHRAN & CO., ANNAN, LTD.

Enclosure.

FOR

Messrs...

Lloyd's Register
III III


DR No 9554

Cochran & Co., Annan, LD.


Donkey Boiler No. 6426.

Drawing No. 9554

Anderson Dry Dk & S. B. Co

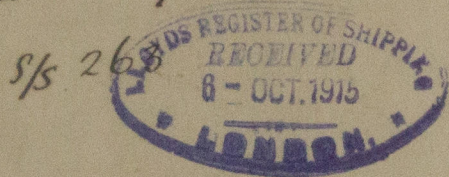

GLASGOW REPORT No. 34820

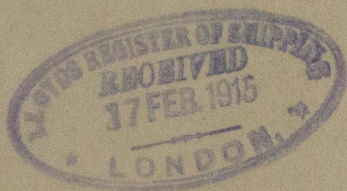

S/ W. Heathcote

GLASGOW REPORT No. 35489

W481-0174 (212)

RETAIN



© 2020

Lloyd's Register
Foundation