

N. I. CLASS.

DETAIL PLAN OF STERNFRAME.

7520


SCALE $\frac{1}{2}$ "=1FOOT.

CAST STEEL.


TO PASS LLOYDS TESTS & REQUIREMENTS OF B. CORPORATION.

NOTE:- CENTRE LINE OF GUDGEONS TO BE IN A
PERFECTLY STRAIGHT LINE.


DETAIL OF STOPPERS.
SCALE 3"=1FOOT.

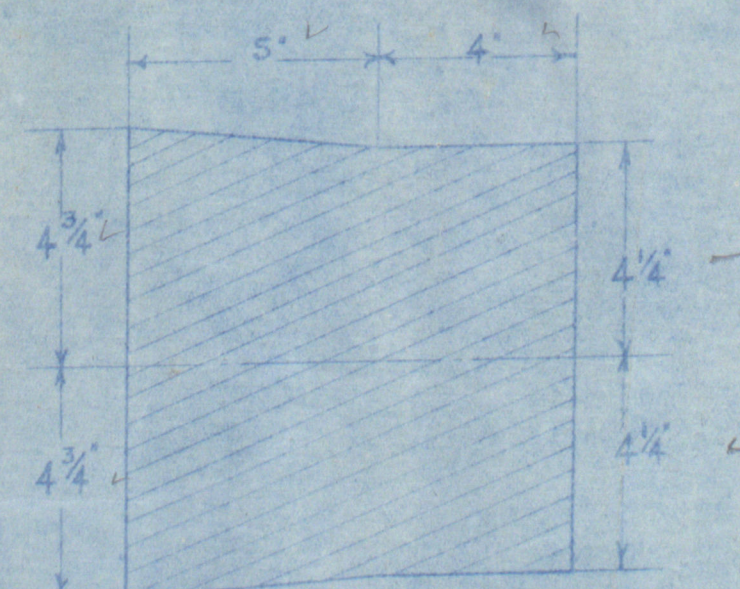

DETAIL OF GUDGEONS MARKED A.
SCALE 3"=1FOOT.

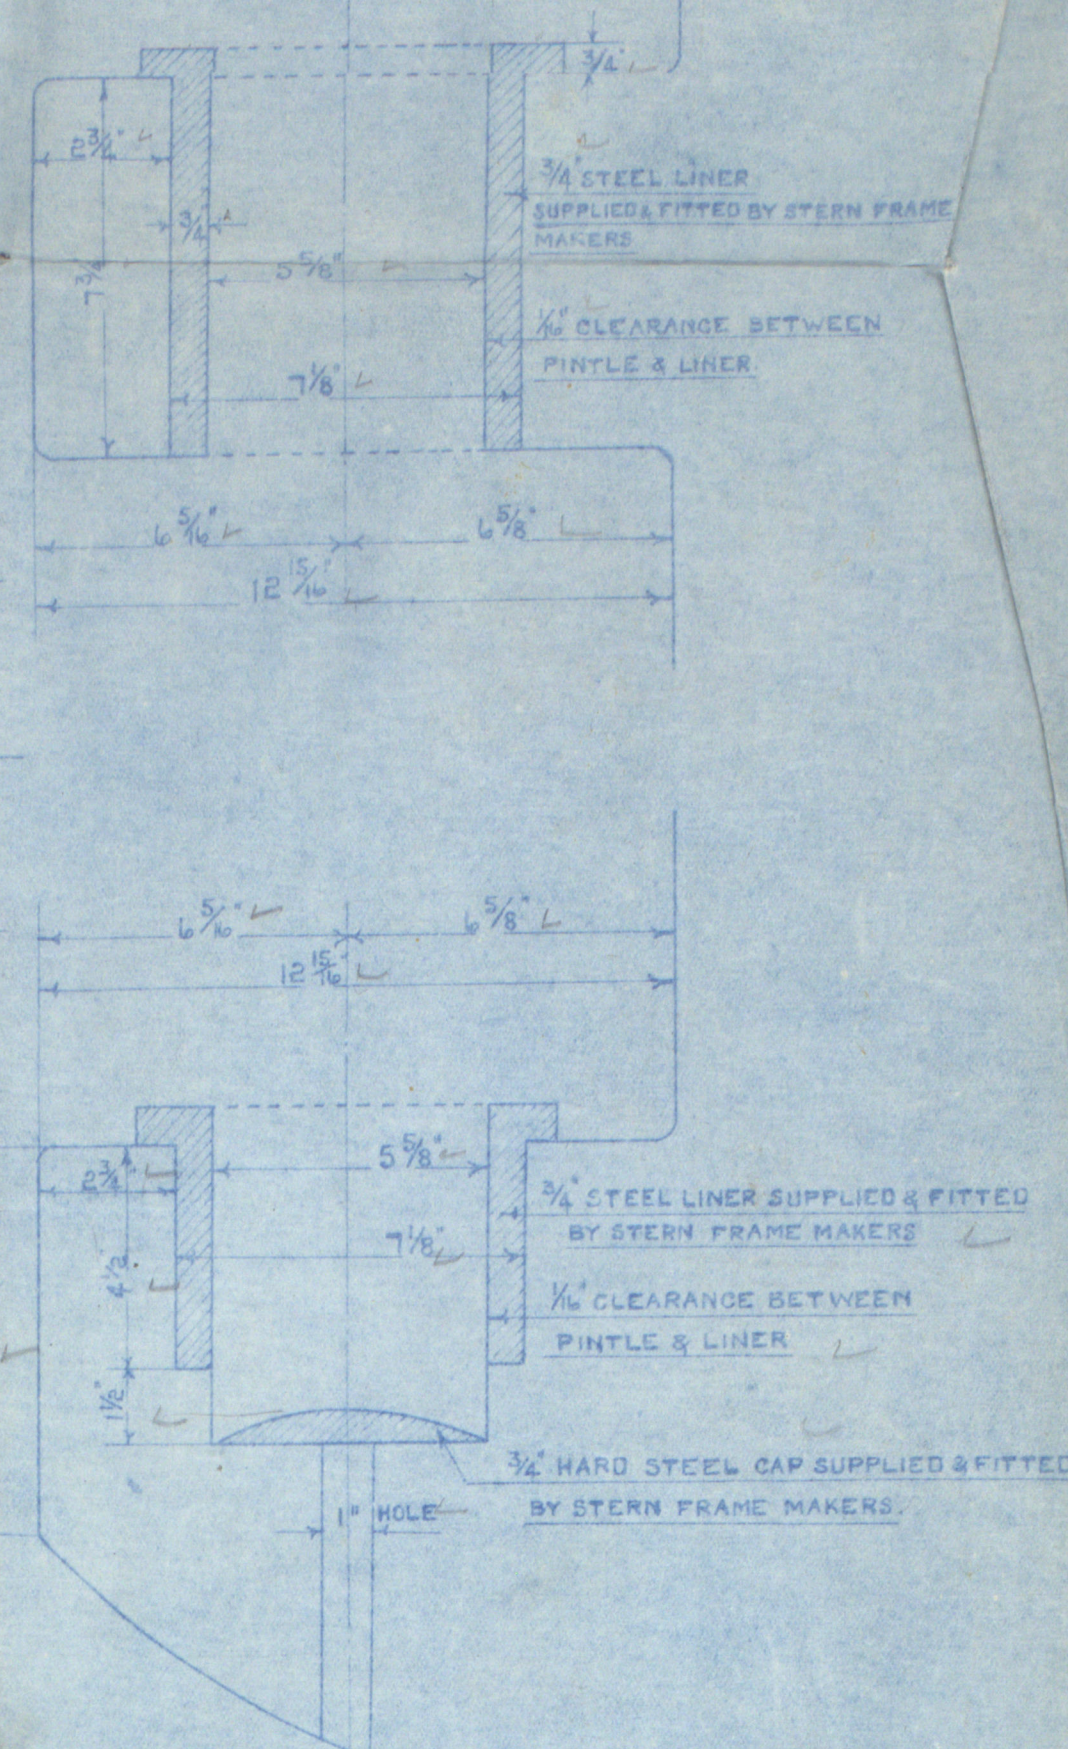

DETAIL OF BOTTOM GUDGEON
MARKED 'B'
SCALE 3"=1FOOT.

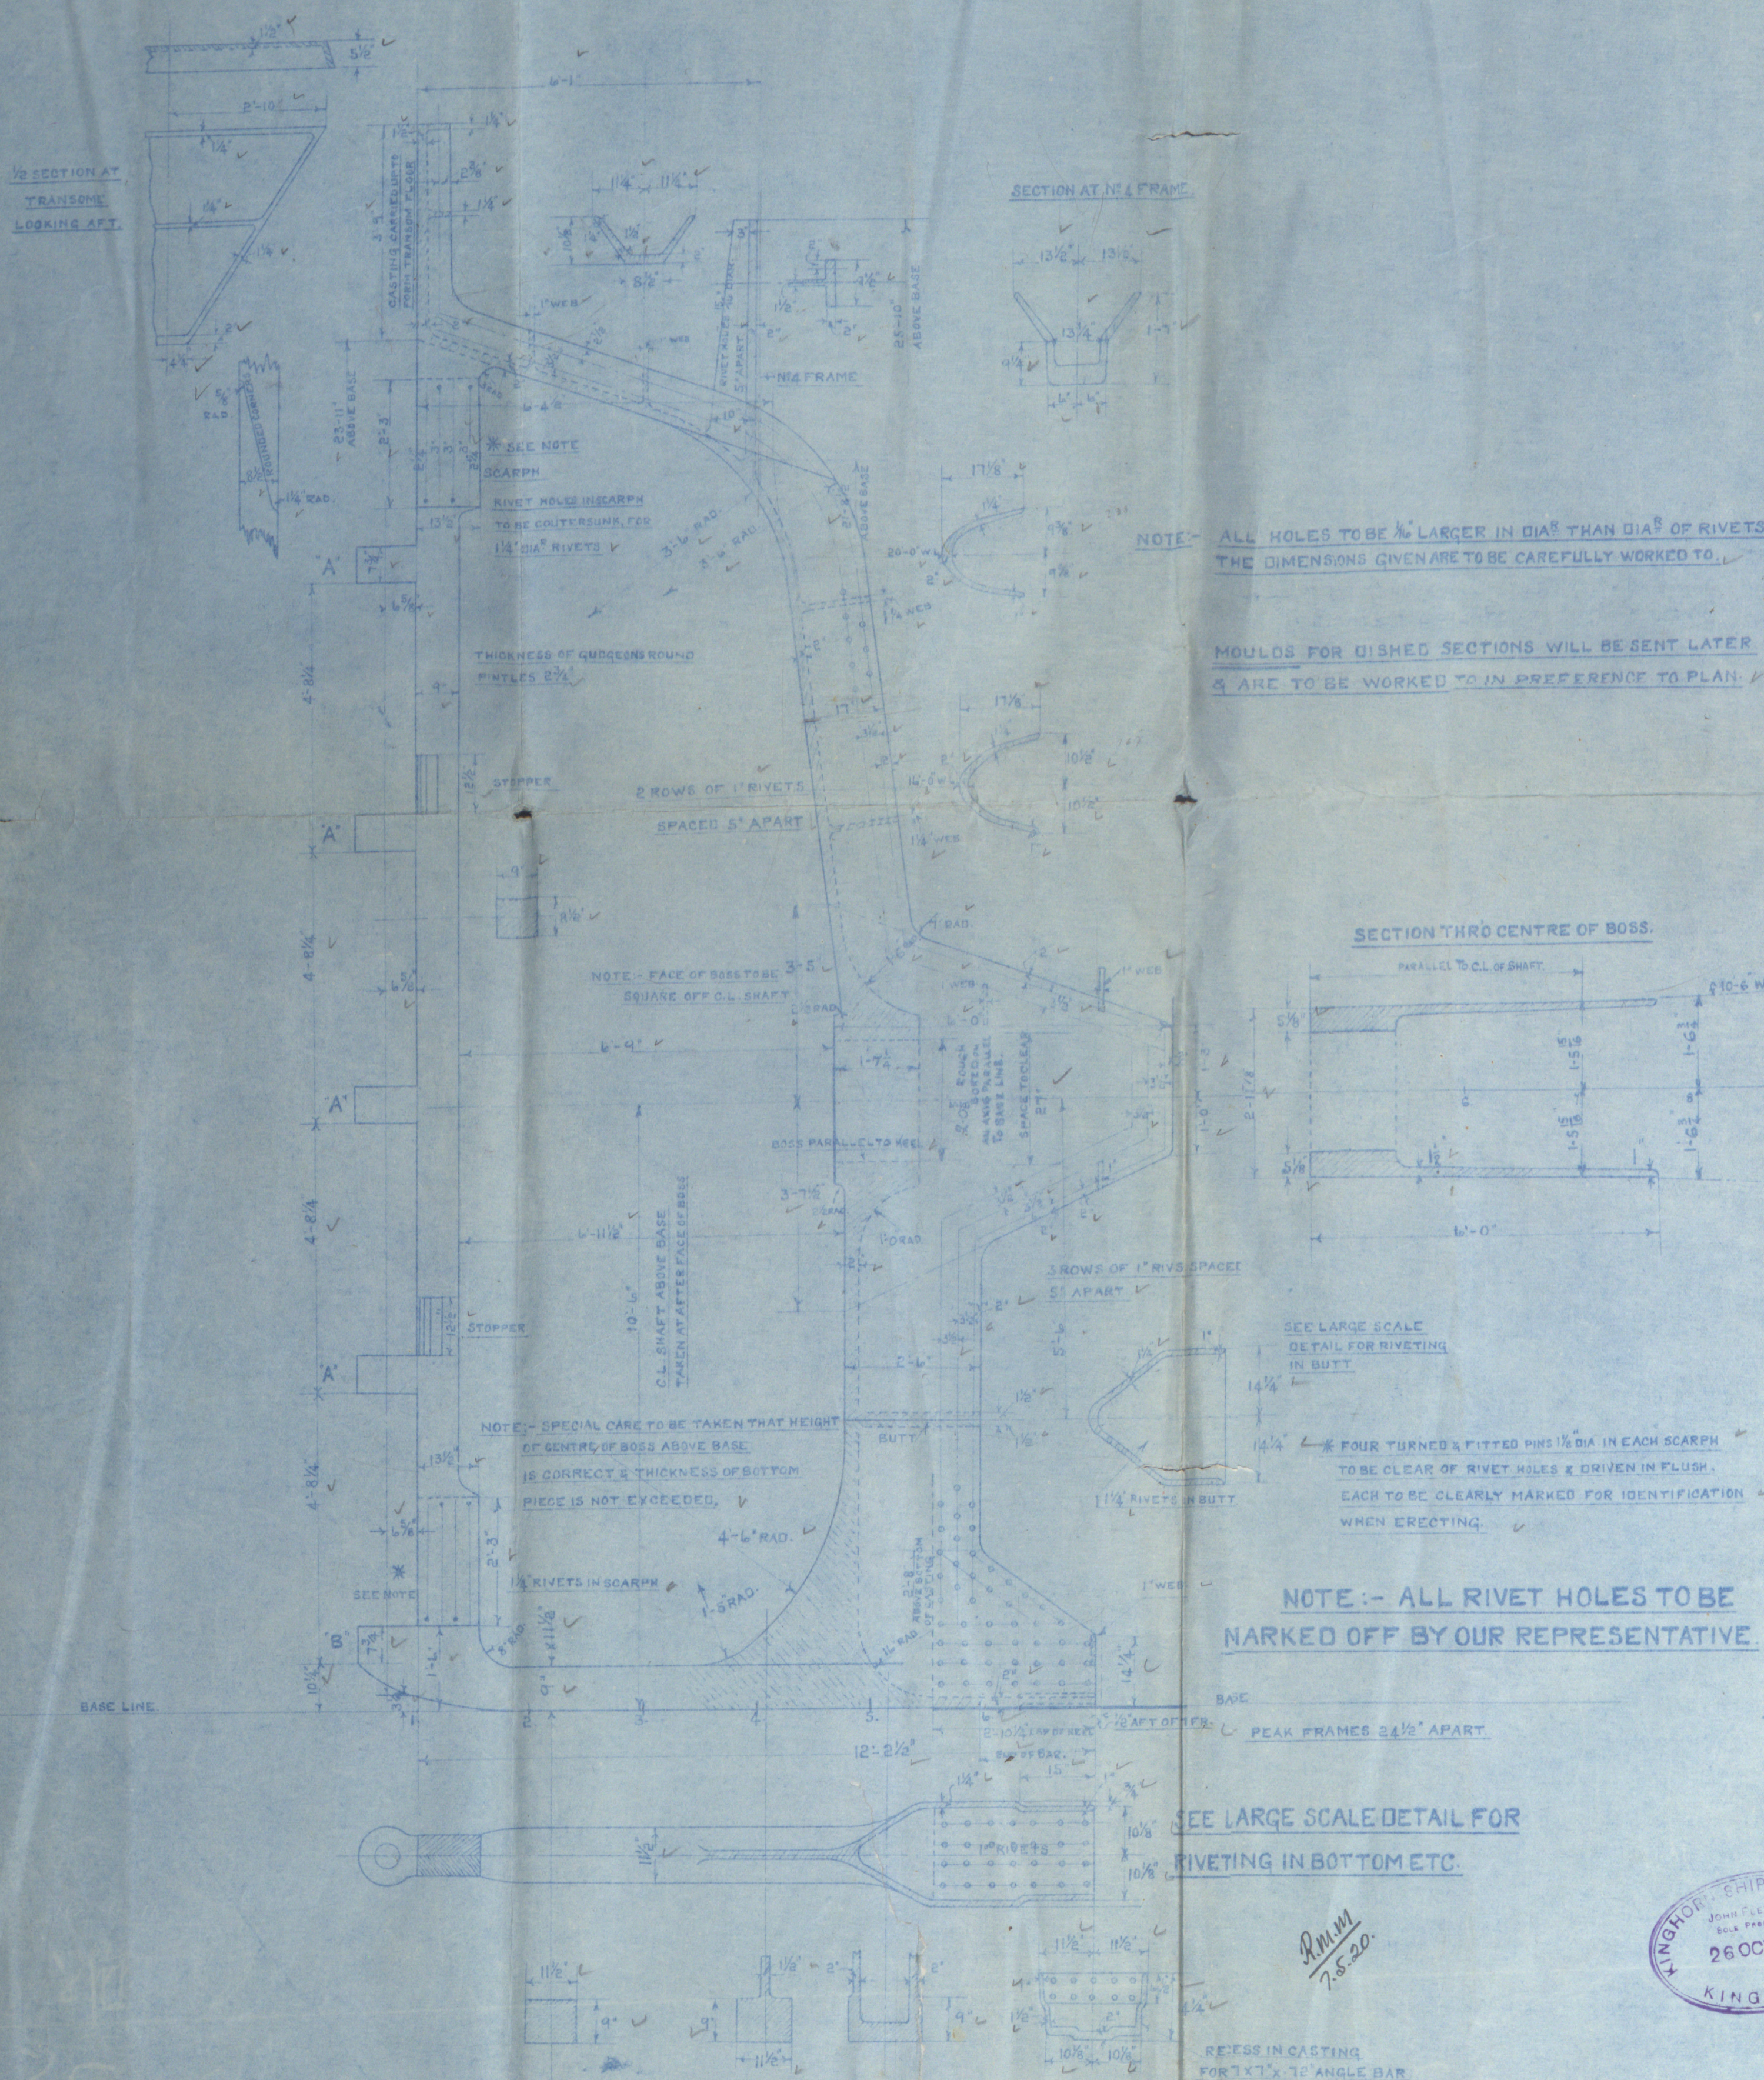

7520



21-MARCH 1918
563
N.I. CLASS.

W482-0243
6/3/2019
Lloyd's Register Foundation


Q /



© 2019

Lloyd's Register
Foundation

1 A + 2

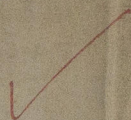

Plan of Sternframe

The Kinghorn S. Co.,
Kinghorn.

Reba Mungell

RETAIN

W482-0243



© 2019

Lloyd's Register
Foundation