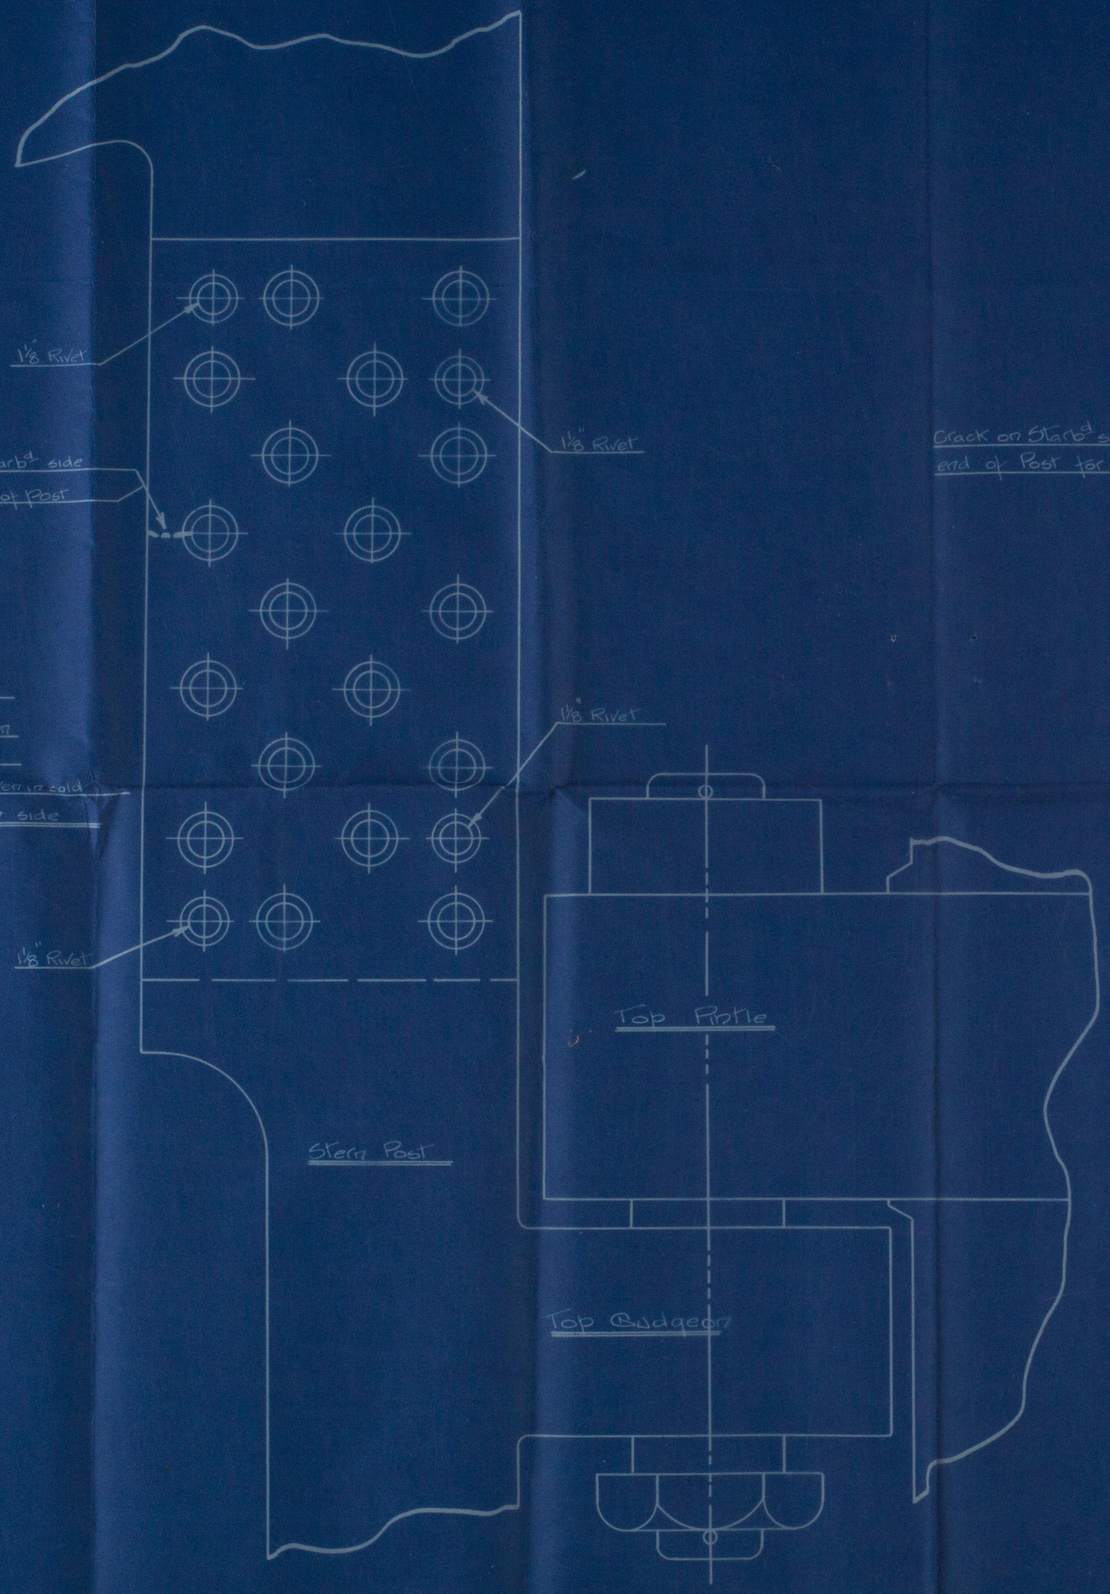

all rivets renewed
4 - 1⅛" rivets as shewn
all other rivets 15/16" Full
all rivets tapped and driven in cold
Holes C.S.K on each side

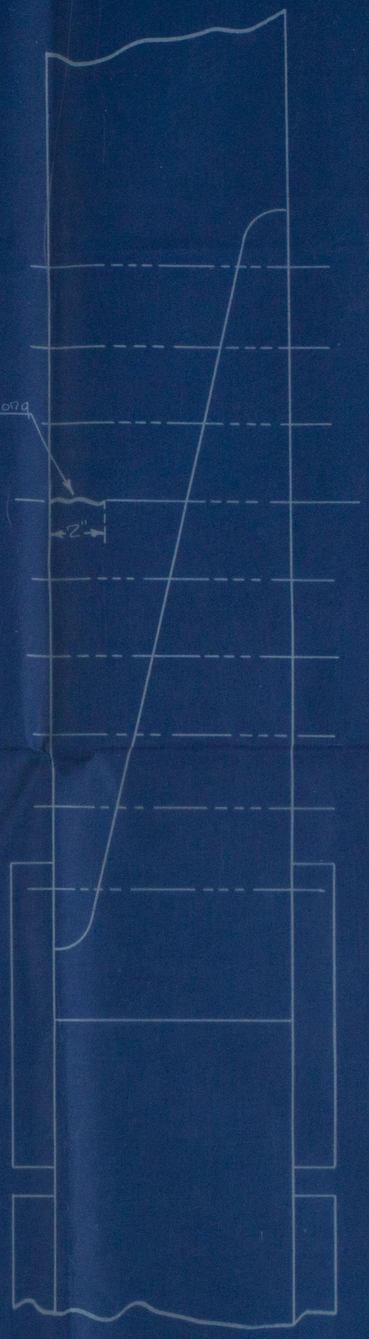

RENEWING SLACK RIVETS IN UPPER SCARF OF STERN FRAME

S.S. "KINGHORN"

Scale 3" = ONE FOOT

20-2-1925
Melbourne Steamship Co. Ltd
Williamstown

W423-2965