




S. S. "Benefactor"

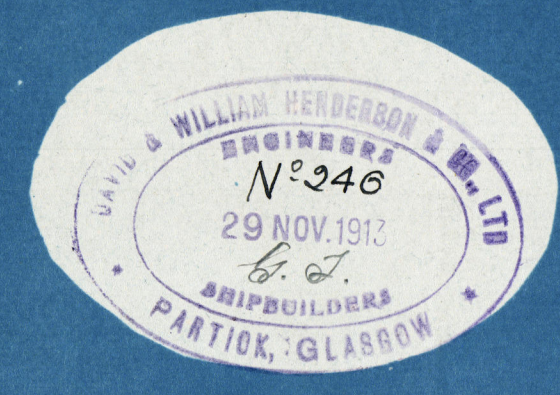

D. & W. H. & Co., Ltd.
Enclosure for
Mr. Richardson
2/2

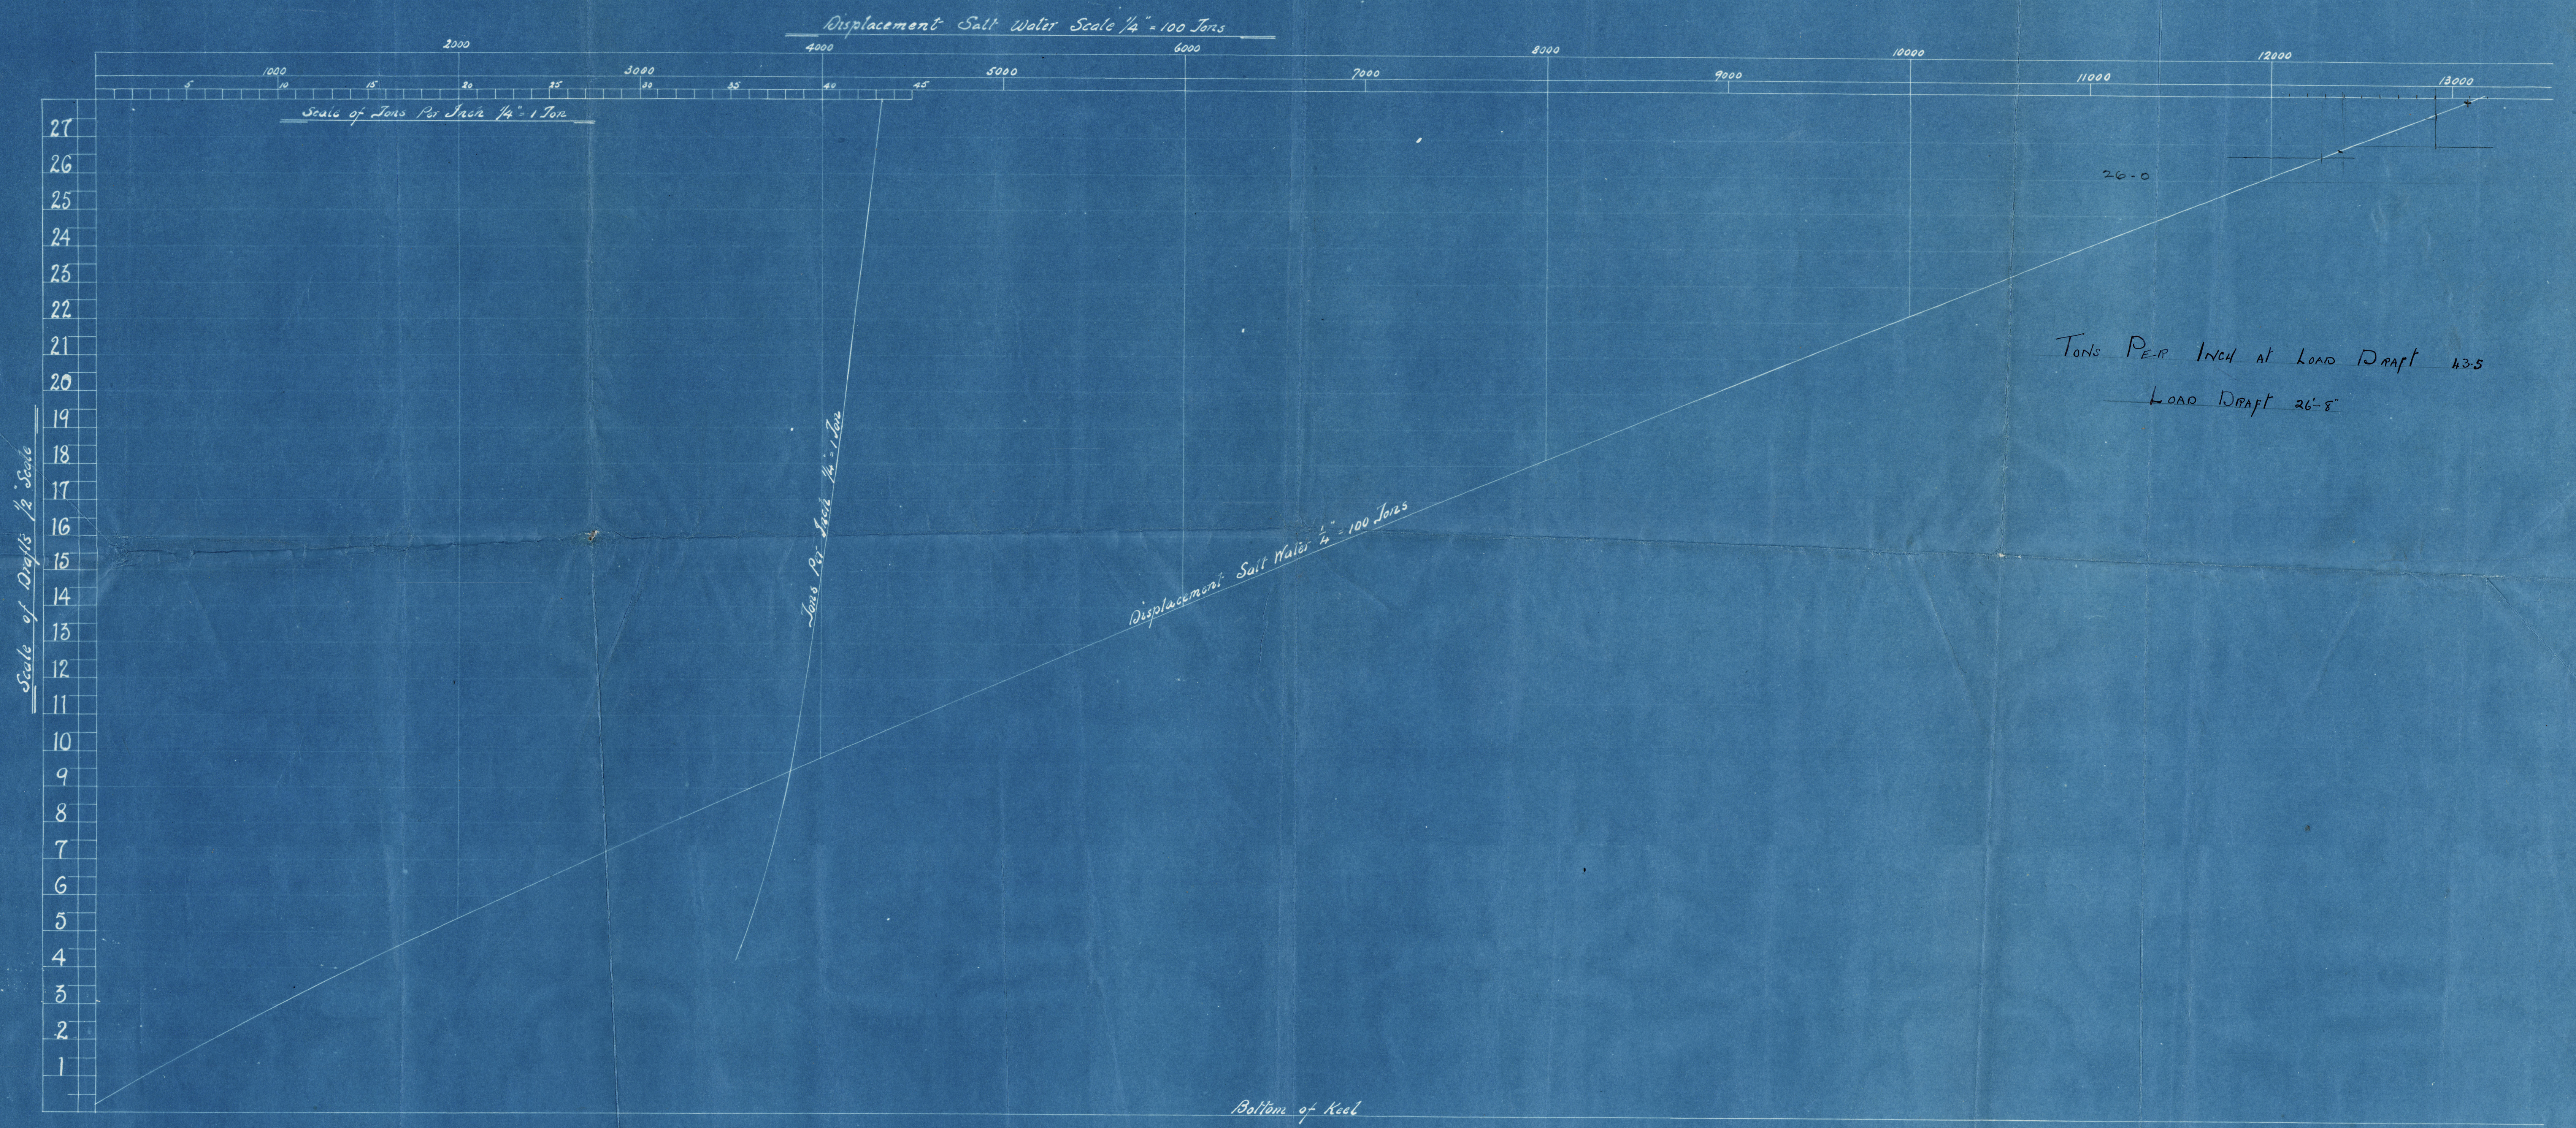

Remuneration

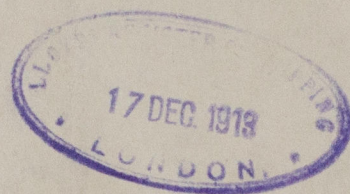

RETAIN

W485-0101



© 2019

Lloyd's Register
Foundation