

DAVID & WILLIAM HENDERSON & CO. LTD.
ENGINEERS
8225
22 SEP. 1917
SHIPBUILDERS
GLASGOW

AUXILIARY BOILER.


N° 478.

SCALE 1" = 1 FOOT.

$\frac{3}{5}$ Benefactor
D. W. Henderson & Co Ltd 448

{ Auxiliary Boiler }
{ Amended Plan }

W.P. 215 lbs^a.

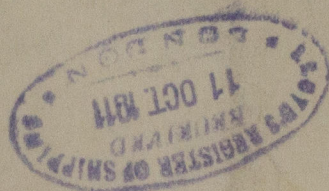

No 11487.
Lloyds Test
430 lbs^a
H.C. 18-3-12

$\frac{3}{5}$ "Benefactor"

GLASGOW REPORT No. 31511



RETAIN



© 2019

Lloyd's Register

Foundation