


1/5 Benefactor
Solo Henderson & Co Ltd 478
Amended Plan Main Boilers
W.P. 215 lbs^{sq}.

no 11476
Lloyds Test
430 lbs
H.C. 13.3.12.

1/5 Benefactor
GLASGOW REPORT No: 31511.

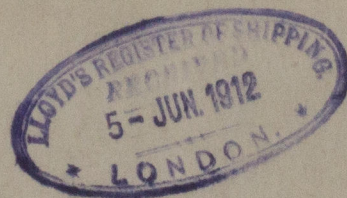

© 2019
W485-0106

Lloyd's Register
Foundation