

Date 29.4.11

Builders, Owners & Yard No.:

Hercules IV Ship Transfer

Class and Type:

1000.1

Rule Dimensions:

127.16 x 21.92 x 12.93 upn 14.08 to RQ

Scantling Numbers:

1631 - 4406

Proportions: $\frac{L}{D} =$

9.91 to upn deck; = 9.04 to RQ deck.

d =

Draft:

Copies kept?

Equipment No.

Similar Ships:

Cruiser stern?

15.70% Covered.

ITEM.	RULE.	PROPOSAL.
No. & extent of W.T. bulkheads		4
Frame spacing:	21.91	20
Frames: <i>Rules upn RQ</i>	<p>178 } c 20</p> <p>228 } c 20</p> <p>296 + 636 + 134m } c 20</p>	<p>21</p> <p>22</p> <p>23</p> <p>100</p>
<p>100</p>
For determining "d"		
Height of tank side brackets:		
Beam knees:		
DOUBLE BOTTOM.		
Breadth of inner bottom:		
Centre girder:		
Side girders:		
Margin:		
Floors—thickness and spacing:		
Inner bottom plating:		
Margin connections:		



© 2019

Lloyd's Register Foundation

W486-0007

Committee's Minute

15/10/11

Equipment Rule 1 c 5 3/4
 1 c 5 3/4
 Sheen 2 1/2
 13 3/4

165 p m e 14
 76

Shen 45 p m e 2 1/2 SW

Towls 75 p m e 6 1/2 hump or 2 1/4 SW

Hansen 90 p m e 4

Shops 1 5 3/4
 1 5 3/4
 1 3
 14

105 c 1 1/6 - practically Rule
 Weight

None.

None

Hansen 60 c 6"
 60 c 5"

11000 0 4407

9.95
 9.95

ITEM.	RULE.	PROPOSAL.
Pillars & Girders:		
Present Rules Beams: Sy 21.5	40 1/2 35.4 x 42 = 1486	5 x 2 x 3 = 2.55
Side Stringers:		
Keel: <i>Farbus</i>	888 - 315	5 x 2 x 3 1/2 1 c 4 1/2 2 c RQ
Bottom Plating:	328 - 288	.50
Side Plating:	019 Spig	375 x 44 - alternately
Topsides:	31 - 27	
<i>Upper</i>	10 x 32 20 x 32 42 x 34 - 42 x 34	7 x 37 26 x 37 1/2 34 x 62 - 37 1/2
<i>RQ.</i>	10 x 30 18 x 30 42 x 32 - 42 x 32	7 x 37 26 x 37 1/2 42 x 62 - 37 1/2

Special Riveting:

Submission of Plans: { Superstructures
 These plans should, where applicable, include { Arrangement to prevent Panting
 Pillars and Girders
 Construction of Bottom Forward

Initials and Date

Reference to Work Book

Indexed

© 2019

Lloyd's Register

W486 - 0007 2/2 Foundation

Equip

$$R.O. \text{ Due} = 51 \times \frac{1.25}{3.18} = \frac{20}{12.116} = 18.7070$$

Rem - Motion

Scuttle

Halter Coaming

Basis

Framing

Rem - 55

Framing

Depth - 110

Vess - 110

Parting - 110

St of bottom

$$d \text{ at } \text{upth} = \frac{12.79}{1.13} = 11.32$$

$$\frac{1}{2} H = \frac{11.32}{2} = 5.66$$

$$R.O. \text{ Due} = \frac{12.02}{1.13} = 10.64$$

Shen

$$R.O. \text{ Due} = 1.09 \times \frac{20}{21.0} = 1.73$$

Towin

$$\text{upth} = 2.83 \times \frac{20}{21.0} = 2.68$$

Hawse



$$R.O. \text{ Due} = 3.24 \times \frac{20}{21.0} = 2.06$$

$$\text{Clath upth} = 3.5 \times \frac{20}{21.0} = 1.92$$

$$R.O. \text{ Due} = \frac{3.42}{2} = 1.71$$

$$R.O. \text{ Due} = 2.1 \times \frac{20}{21.0} = 2.06$$

$$R.O. \text{ Due} = 4.2 \times \frac{20}{21.0} = 4.0$$

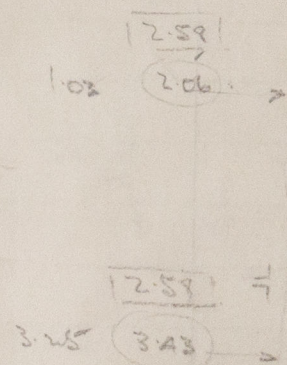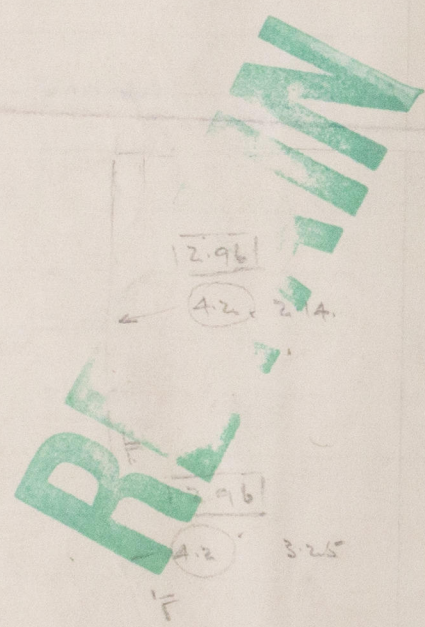

○ 1921 Rub

□ Preset

Framing



© 2019

Lloyd's Register Foundation

gested R

e of Com

Committee