


PROFILE & DECKS

N^o 414-416-417

DIMENSIONS LENGTH 389'-6" x 53'-2" MLD x 31'-6" MLD.

CLASS 100 A.I. LLOYDS.

SCALE 1/8" = 1 FOOT.

 

PLAN N° 414

SHORT BROTHERS LIMITED
SUNDERLAND

© 2020

Lloyd's Register

37 Foundation


Profile
(as built-)

N^o 417

Messrs Short Bros & Co
Sunderland
" S. S. KAFIRISTAN "

SUNDERLAND RPT. NO. 28901

RETAIN

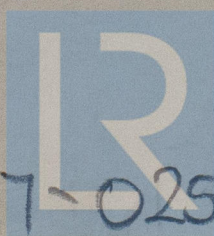

© 2020

Lloyd's Register
Foundation

W487-0255