

FRI. APR. 25. 1913

64089

Rpt. 11b.

96 1/9/32

Palmer's P. B. Co. P. S. No. 825.

# Lloyd's Register of British & Foreign Shipping.

## SURVEYS FOR FREEBOARD.—STEAM SHIPS.

PARTICULARS RELATING TO ALL STEAM SHIPS EITHER FLUSH DECKED, OR WITH TOP GALLANT FORECASTLES, SHORT POOPS AND BRIDGE HOUSES DISCONNECTED, OR WITH TOP GALLANT FORECASTLES HAVING LONG POOPS OR RAISED QUARTER DECKS CONNECTED WITH BRIDGE HOUSES, OR OTHERWISE.

Port of Survey Newcastle  
Date of Survey 23<sup>rd</sup> April 1913  
Name of Surveyor A. R. Sweeney

City of Khartoum

Ship's Name. ex 'KARROO'  
Number in Register Book 694 Supp.  
Port of Registry and Nationality. U. S. S. S. British  
Official Number. 133310  
Gross Tonnage. 5848.55  
Date of Build. 1913  
Particulars of Classification. + 100 A. 1. (Class Contemplated)

Registered dimensions from Ship's Register.  
LENGTH. 430.8  
BREADTH. 54.1  
DEPTH. 31.25  
UNDER DECK TONNAGE. 5848.55  
Length on 430.2  
Frame Depth 11  
Rule 6 1/2  
Ceiling +20  
Peak Peak  
Sheer +69  
Fanks Fanks

Moulded Depth as measured 33-7"

NOTE.—If the depth is measured when vessel is afloat, the details of measurement should be reported.

## CORRECTION FOR LENGTH.

Length of Ship on Leadline..... 430.2  
Length in Table ..... 403.0  
Difference ..... 27.2  
Correction for 10ft., Table A. .... 1.7 Table C.  
× Difference divided by 10 ..... 4.62 (if required.)  
If  $\frac{1}{10}$ ths length covered divide by 2 2.31 + 2 1/4

## CORRECTION FOR IRON DECK.

Proportion covered, if less than  $\frac{1}{10}$ ths length covered ..... 657  
Thickness of usual wood deck, less stringer ..... 3 1/2 - 2 3/4  
3.56 = 2.84

## CORRECTION FOR ROUND OF BEAM.

Breadth at Gunwale amidships..... 52.10  
Round of Beam ..... 13 1/4  
Normal round..... 13 1/4  
Difference ..... ÷ 2 =  
Proportion of Deck uncovered (Para. 19) .....

NOTE.—The round of beam should be reported on the full breadth of vessel at the gunwale.

Freeboard, Table A ..... 8-11.92  
Correction for Sheer ..... 6.29  
8-5.63  
Correction for Length ..... + 2.31  
8-7.94  
Allowance for Deck Erections ..... 1-2.30  
7-5.64

Correction for Round of Beam.....  
Correction for fall in Sheer (if any).....  
Correction for Iron Deck (if required) ..... 2.94  
7-2.70  
Additions for non-compliance with provisions of Para. 11 (d) and (e) † .....  
Other Corrections (if any) .....

Winter Freeboard ..... 7-2.40  
Summer Freeboard ..... 6-8.52 - 6 1/4  
Indian Summer Freeboard ..... 6-2.34  
N. A. Winter Freeboard .....

Correction necessary because clearside amidships, measured in accordance with the Statute is not taken at the intersection of the wood or iron deck with side. 13 1/4

Winter Freeboard from deck line ..... 7-5 1/4 1/2  
Summer " " " " ..... 6-10 3/4 1/4  
Indian Summer " " " " ..... 6-4 3/4  
N. A. Winter " " " " .....

Amended Tables March, 1906. 6 1/2  
6 1/2  
6 1/2  
6 1/2

† State dimensions of freeing port area on back of this form.

† The Surveyor should state whether the fall in sheer as reported is measured relatively to the straight line of keel or to the water line. If measured relatively to water line the vessel's draft at time of survey, and also the usual load draft forward and aft, should be reported.

787  
02 Cor. D. Bottom  
77.76

165 ÷ 2 = 82.5 ... Mean  
Stem 57 1/2  
Sternpost 28 1/2  
86 ÷ 2 = 43 ... Mean  
78.18 ÷ 55 = 78.18  
Table, Para. 18] ..... 53.02 Correction  
Difference ..... 25.16 ÷ 4 = -6 1/4  
8 (f) ..... 6.29

front of bridge house.....  
after end of forecastle .....  
÷ 2 =  
Correction

ALLOWANCE FOR DECK ERECTIONS:—  
5-10.33  
if required (Para. 12, 13, and 14) .....  
8-5.63  
corrected for sheer, and for length, }  
and (Para. 12, 13, and 14) }  
2-4.30  
2-8 7/2  
45.70  
14.3

if engine and boiler openings not house (Para. 11) .....  
ations ..... - 14 1/2

Length. Length allowed. Height.  
42.5 ..... 42.5 ..... 8.0  
71.0 ..... 168.75 ..... 8.0  
71.5 ..... 71.5 ..... 8.0  
285.0 ..... 282.75 ..... 6.57  
430.2 ..... 430.2

ommended amidships from centre of Disc to top of Statutory Deck Line, Wood (Iron) Deck:—  
Fresh Water Line above centre of Disc .....  
Indian Summer Line " " " .....  
Winter Line below " " " .....  
Winter North Atlantic Line " " " .....

the frames, skin planking, or ceiling are of unusual thickness the breadth of vessel to inside of ceiling should be reported if possible.  
† In vessels obtaining an allowance for deck erections under Para. 11 where the sheer drops abaft amidships the height of the R.Q.D. is to be taken from the level of the top of the amidship beam.  
† In flush-decked vessels the total standard mean sheer means the sheer measured at the stem and stern-post. In vessels having poops and forecastles, it means the sheer measured at points distant one eighth of the vessel's length from stem and stern-post.

8.13. T.

ms B & S 25/4/13.

RECEIVED 18 MAY 1927

RECEIVED 30/4/13.

Lloyd's Register Foundation

8810-8841



Do all the Frames extend to the top height in the Poop? *Yes* Raised Quarter Deck? *Yes* Bridge House? *Yes* Forecastle? *Yes*

To what height do the Reverse Frames extend? *Bull ruff, framing*

Has the Poop or Raised Quarter Deck an efficient Iron Bulkhead at the fore end? *Yes*

Give particulars of the means for closing the openings in Bulkhead *Slifting boards full height in rivetted channels*

Is the Poop or Raised Quarter Deck connected with the Bridge House? *No* Has the Bridge House an efficient Bulkhead at the fore end? *Yes*

Give particulars of the means for closing the openings in Bulkhead *Hinged iron watertight doors*

What is the thickness of the Bridge Front plating? *.40* and Coaming plate? *.44*

Give scantlings and spacing of the Stiffeners *8 x 3 1/2 x 64 B.A.S. Space 30" apart*

Are bracket plates fitted at each end of the Stiffeners? *Yes* Are horizontal brackets fitted connecting Bridge Bulk'd. with Bulwarks? *Yes*

Has the Bridge House an efficient Iron Bulkhead at the after end? *Yes*

How are the openings closed? *Slifting boards full height in rivetted channels*

Is the Forecastle at least as high as the main or top-gallant rail? *Yes* Has the Forecastle an efficient Iron or Wood Bulk'd. at after end? *Yes*

Are the Engine and Boiler openings covered by a Bridge, Poop, Raised Quarter Deck, or enclosed by a Strong Iron or Steel Deckhouse? *Covered by a Bridge*

If the openings are not so protected are the exposed parts of the Casings efficiently constructed? *Yes*

Give thickness of plating; scantlings and spacing of Stiffeners

What is the height of the exposed Casings? *Yes* Are suitable means provided for closing all openings in them in bad weather? *Yes*

Are the Weather Deck Hatchways efficiently constructed and at least equal to the requirements of Section 28 of the Rules for 1904-5? Give particulars below:—

Position and Size.	29'3" x 16'0"		27'0" x 16'0"		18'0" x 12'0"		15'0" x 16'0"		23'0" x 16'0"		24'0" x 16'0"	
Item.	Ship.	Rule.	Ship.	Rule.	Ship.	Rule.	Ship.	Rule.	Ship.	Rule.	Ship.	Rule.
Height above top of DECK	30"	30"	30"	30"	18"	18"	18"	18"	30"	18"	30"	18"
COAMING Thickness	Sides .54 Ends .40	.54 .40	.60 .40	.60 .40	.44 .40	.44 .40	.50 .36	.50 .36	.56 .40	.60 .40	.60 .40	.60 .40
SHIFTING BEAMS OR WEB PLATES	3 webs + 3 B.T.S. <i>as fitted</i>	<i>as fitted</i>	2 webs + 3 B.T.S. <i>as fitted</i>	<i>as fitted</i>	1 web + 2 B.T.S. <i>as fitted</i>	<i>as fitted</i>	2 B.T.S. <i>as fitted</i>	<i>as fitted</i>	2 webs + 3 B.T.S. <i>as fitted</i>	<i>as fitted</i>	2 webs + 2 B.T.S. <i>as fitted</i>	<i>as fitted</i>
Material	Double bottom 3 x 4 x 40 B.T.S. 12 x 6 1/2 x 46		Double bottom 5 x 4 x 50 B.T.S. 12 x 6 1/2 x 46		Double bottom 5 x 4 x 50 B.T.S. 12 x 6 1/2 x 40				Double bottom 5 x 4 x 50 B.T.S. 12 x 6 1/2 x 50		Double bottom 5 x 4 x 50 B.T.S. 12 x 6 1/2 x 50	
* FORE AND AFTERS	Number . . . . . Section and Scantlings . . . . . Material . . . . .	None.	None.	None.	None.	None.	None.	None.	None.	None.	None.	None.
HATCHES Thickness	3"	3"	3"	3"	3"	3"	3"	3"	3"	3"	3"	3"
Remarks												

\* When the Fore and Afters are of wood the depth should be stated from the underside of the hatches.

(If the sill of the lowest side scuttle will be less than 6 inches above the Indian Summer Load Line if assigned under the tables, state vertical distance from top of deck at side amidships to lower edge of lowest side scuttle.)

The following information is to be given in all Cases of vessels dealt with under Paras. 11, 12 (under 15 feet Moulded depth) and under Shelter Deck Rules.

What is the thickness of the Bridge Sheerstrake? *Strake between Main and Bridge Sheerstrakes?*


Delete the words { The Crew are, are not, berthed in the bridge house.  
that do not apply { The arrangements to enable them to get backwards and forwards from their quarters are, are not satisfactory.

Length of Bulwarks in well

Area of Freeing Ports required by Para. 11 (e) each side of vessel = Sq. ft.

Ft.	Tenths.	Ft.	Tenths.	No.	Freeing Ports (each side of vessel)	=	Sq. ft.
x	x	x	x				
x	x	x	x				

Total deficiency or excess = Sq. ft.

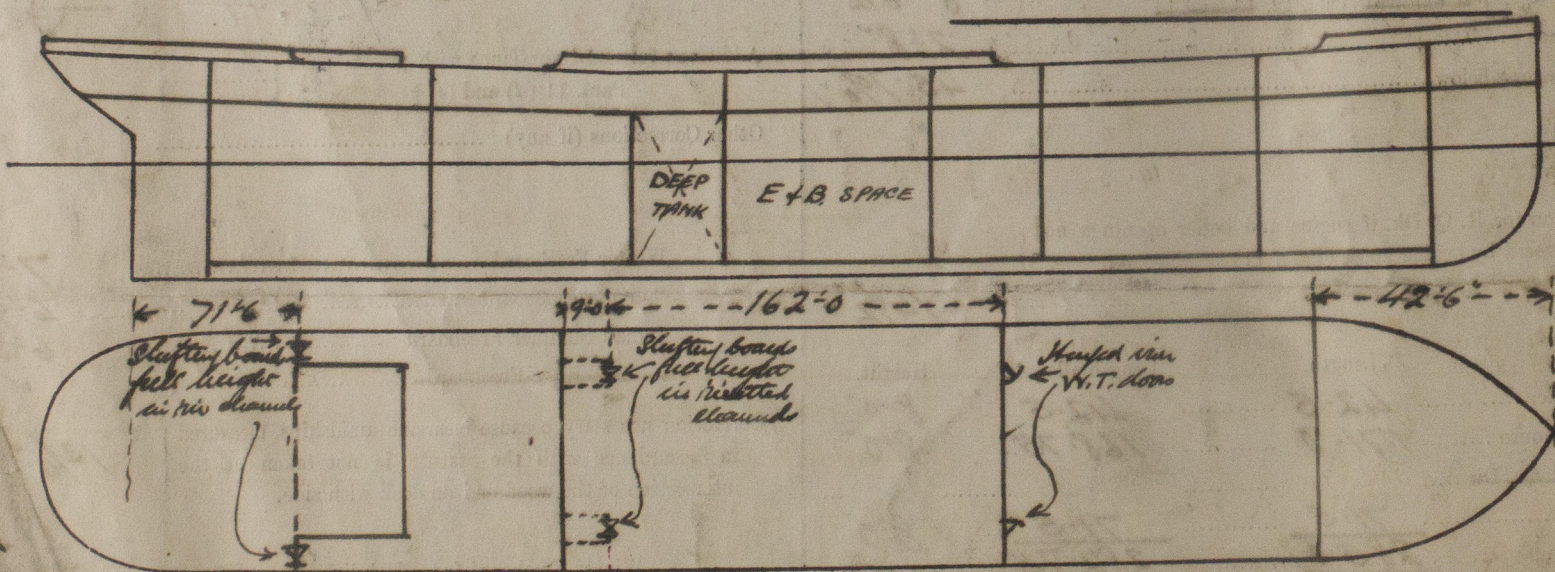

Show hereon line of Floors or Tank Top with position of any Breaks in same; also height of Peak Tank tops, &c., &c.

State any special features in the construction of the Vessel *This vessel is built in accordance with the approved plans forwarded herewith (3 in 10)*

*A fullboard request form is attached hereto. Longitudinal framing is fitted in the usual manner in the forward upper hold, & twelve decks, & with*

Owners

Address

Fee £

Received by me