



FRACTURES IN CYLINDER HEAD
M.S. "KOLL"

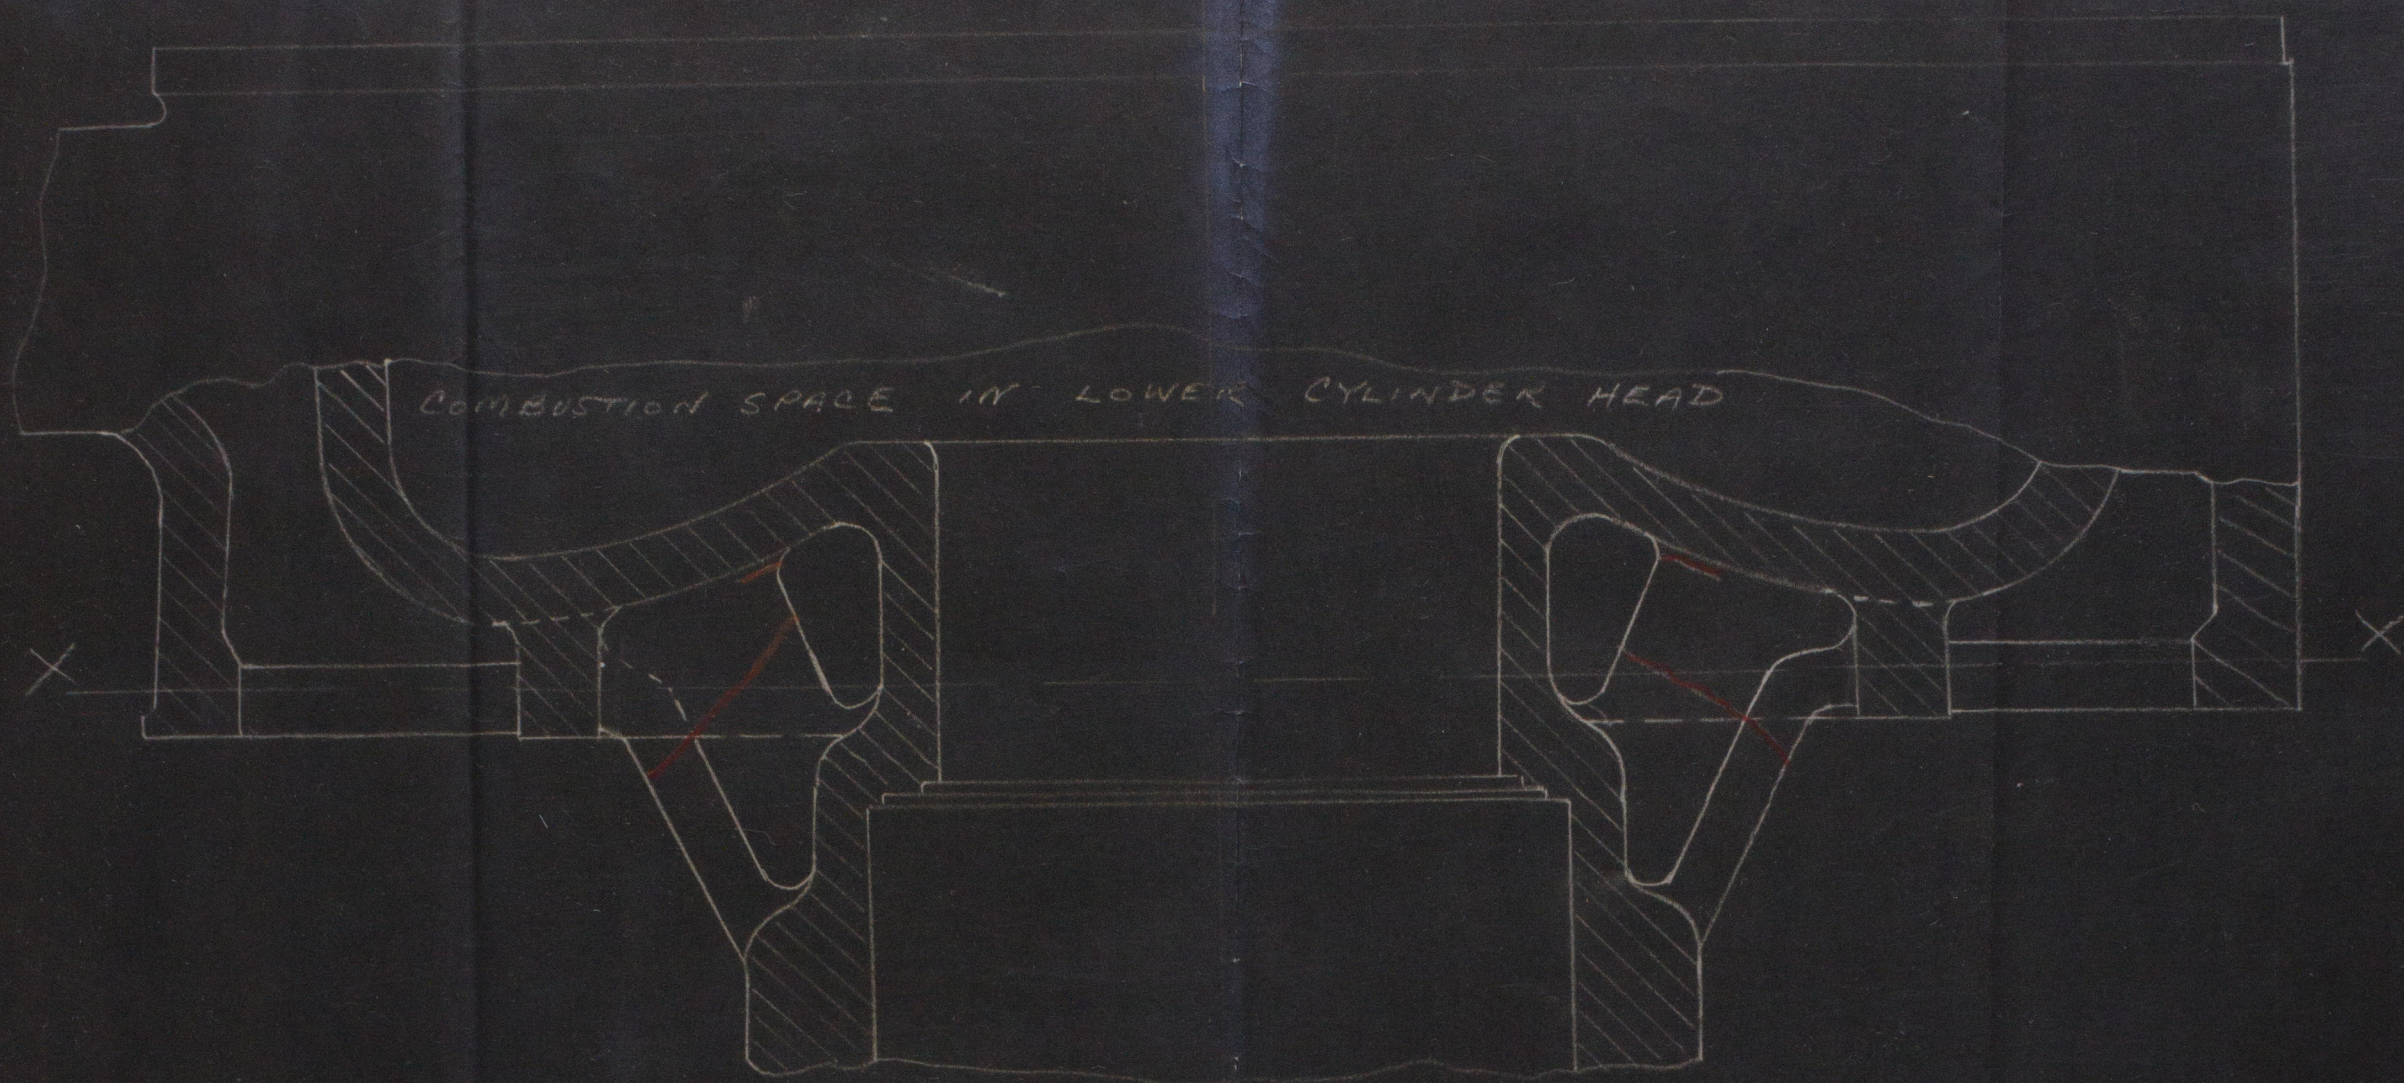

SECTION THRO' XX

M.S. KOLL.

Nyk. 35134

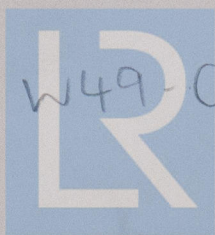

W49-0062

© 2020

Lloyd's Register
Foundation