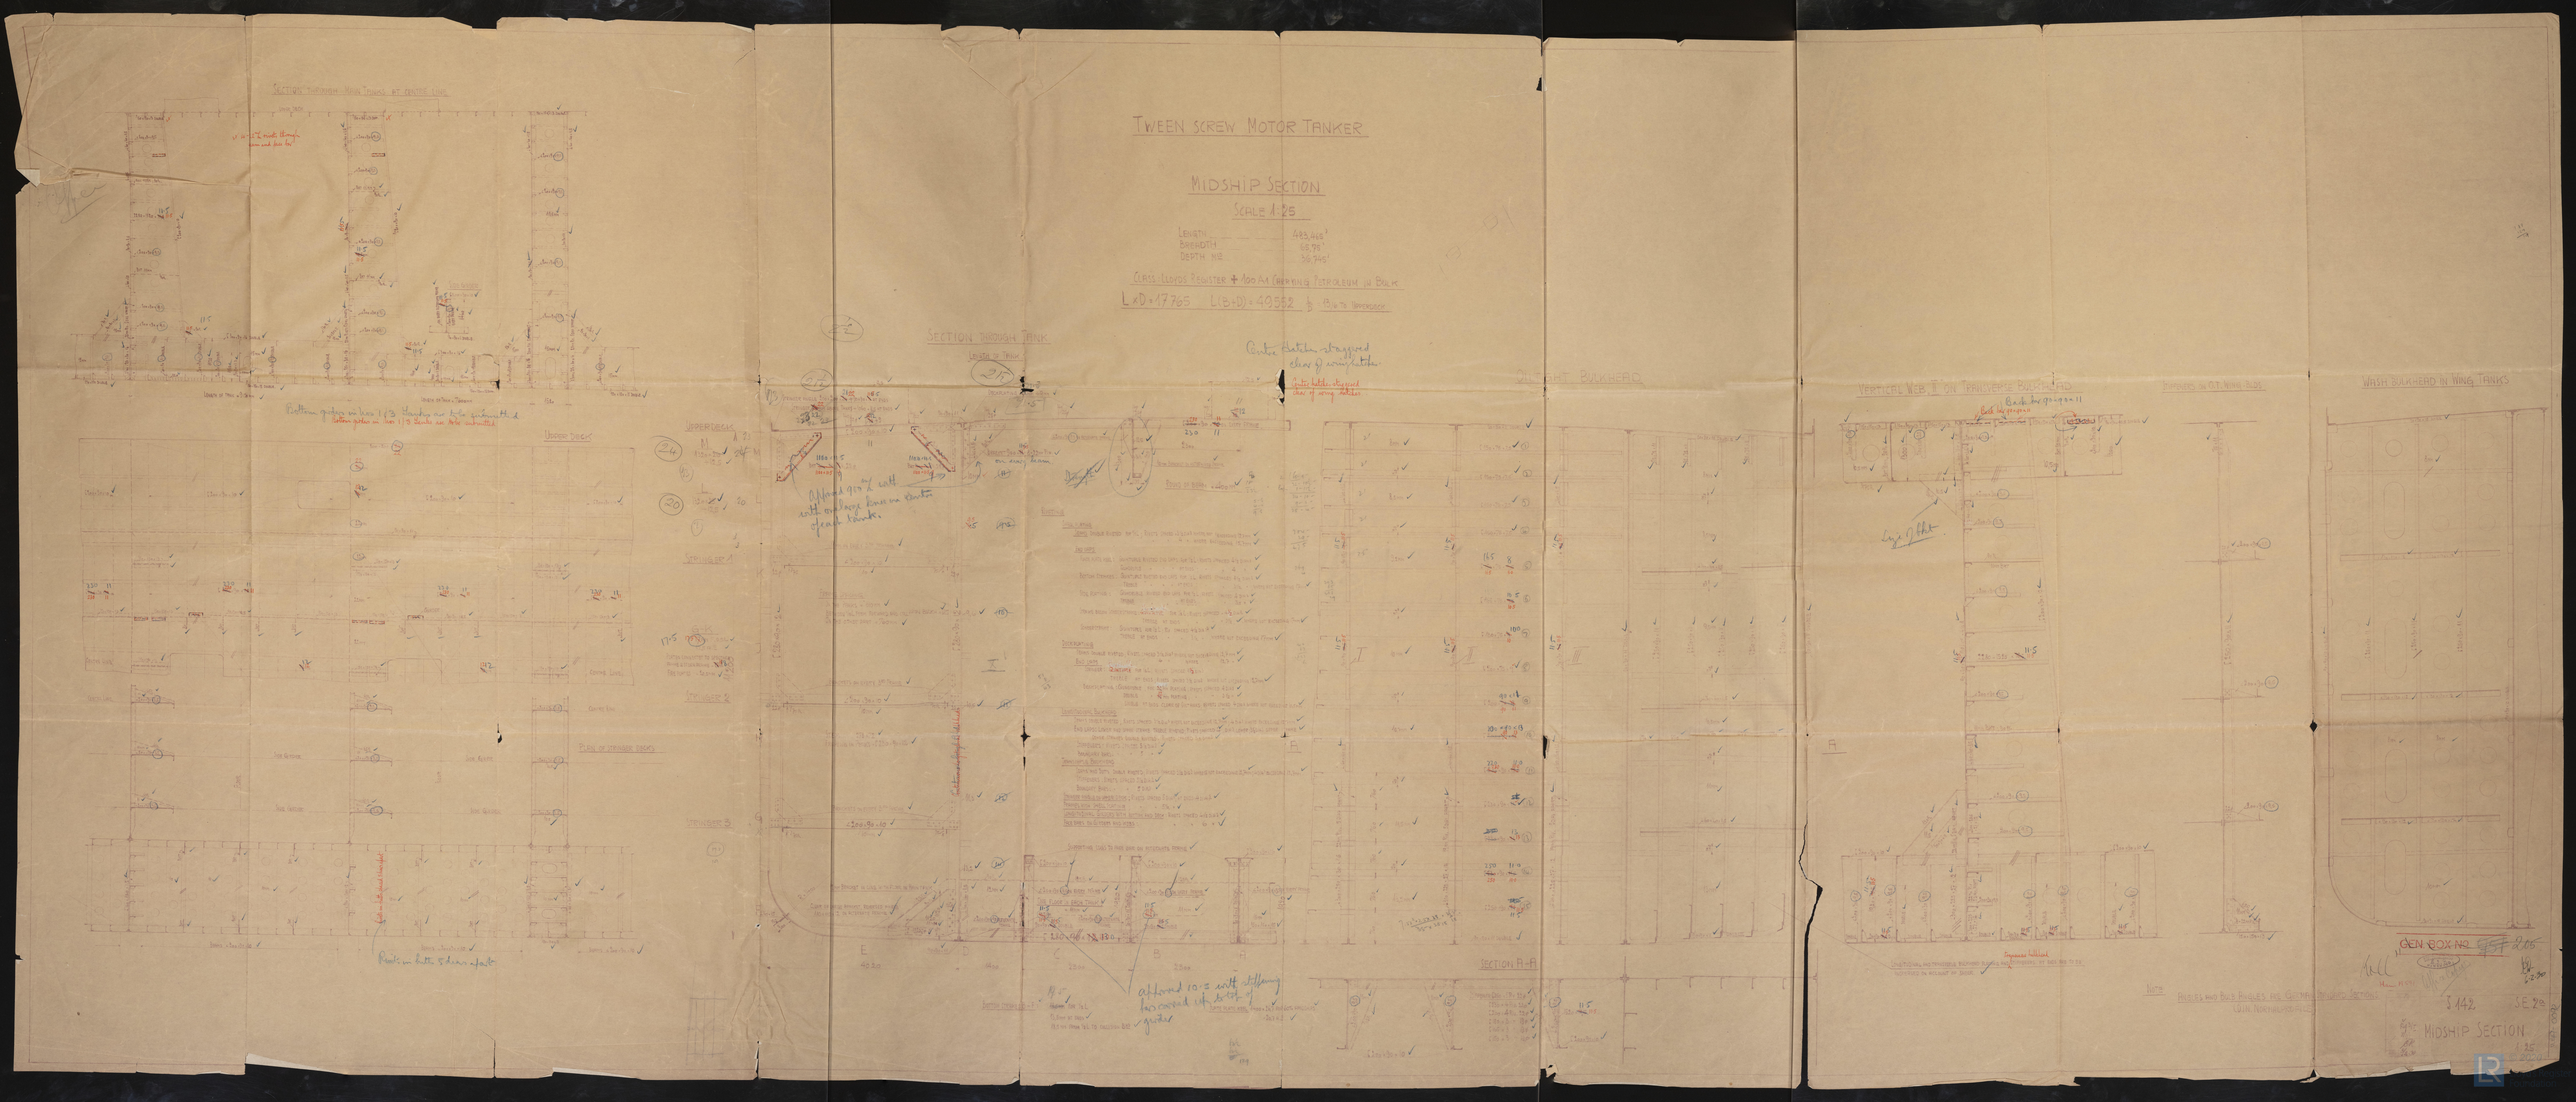
TWEEN SCREW MOTOR TANKER
MIDSHIP SECTION
SCALE 1:25
LENGTH 483,465'
BREADTH 65,75'
DEPTH MLD 36,745'
CLASS LLOYDS REGISTER + 100 A1 CARRYING PETROLEUM IN BULK
L×D = 17765 L(B+D) = 49552 B/D = 13/6 TO UPPERDECK
SECTION THROUGH TANK
OILTIGHT BULKHEAD
VERTICAL WEB II ON TRANSVERSE BULKHEAD
WASH BULKHEAD IN WING TANKS
UPPER DECK
STRINGER 1
STRINGER 2
STRINGER 3
PLAN OF STRINGER DECKS
SECTION A-A
GEN BOX NO 205
S 142
SE 2a
MIDSHIP SECTION
1:25