


STEEL SCREW STEAMERS.
DIMNS:-175'-0" B-P x 29'-0" EX x 13'-6" MLD

1/4" SCALE

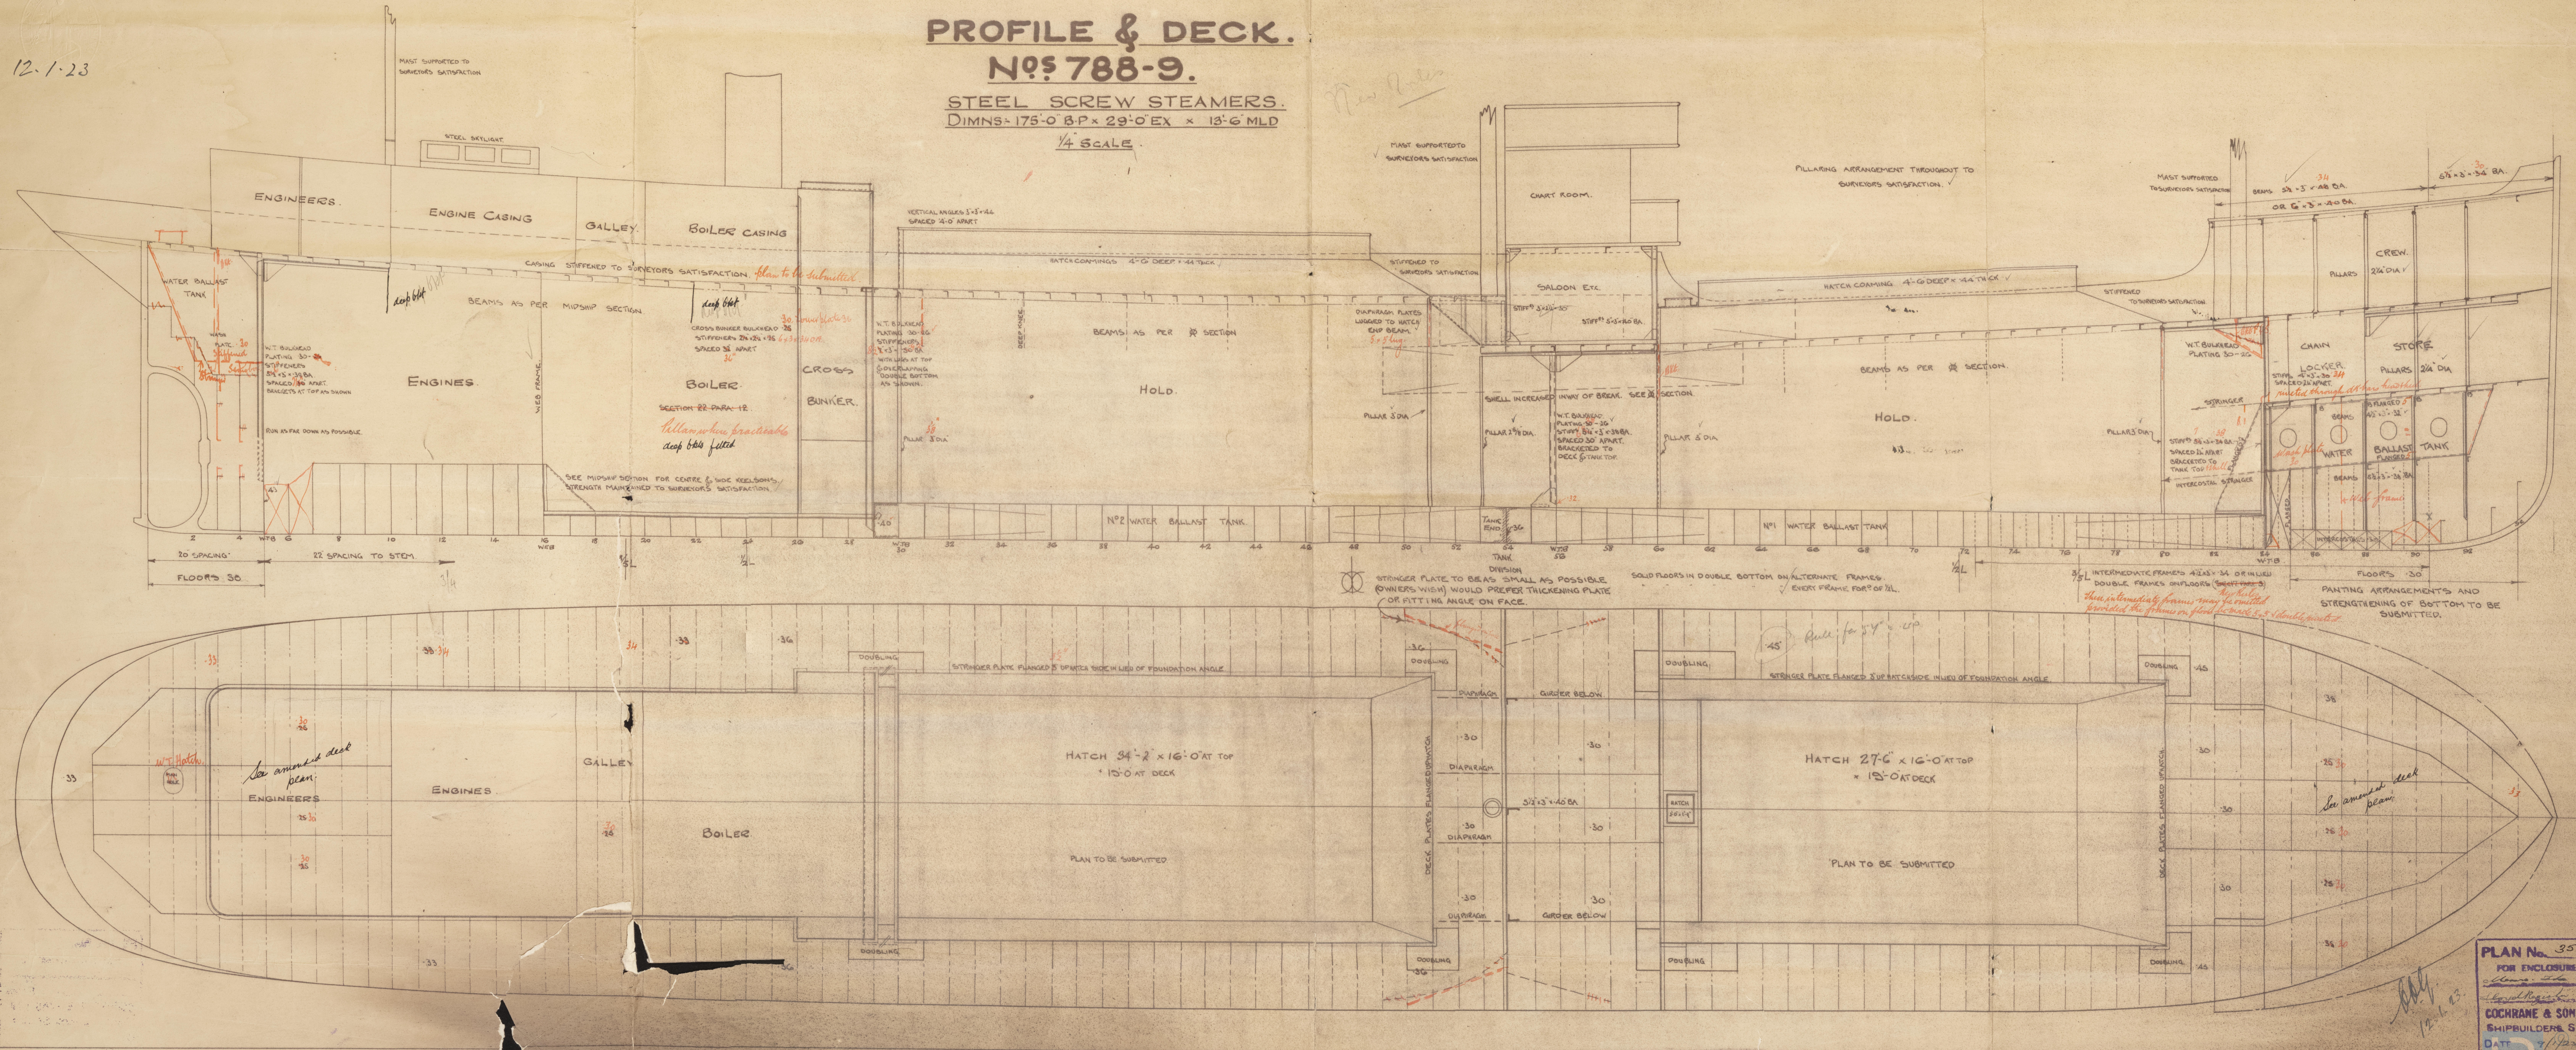

Profile & Decks


Cochrane's

No 488. 9

New Rules

Is Malux Hall Rpt No. 34386

Lesrix - - - 34905

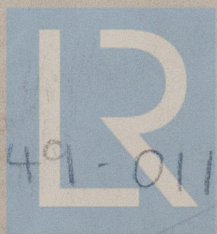

© 2020

W49-0112

Lloyd's Register
Foundation