


2 BOWERS STOCKLESS	16 3/4 CWTs	✓
1 " " "	14 1/2	✓
1 STEAM ANCHOR (EX STOCK)	4 3/4	✓
1 KEQGE " (" ")	2 1/4	✓
210 FMS STUD LINK CABLE	1 1/16	✓
60 " 3" STEEL WIRE V		
75 " 2 3/4 " " ✓		
90 " 2 1/4 " " ✓		
90 " 2 1/4 " " ✓		

SCALE $\frac{1}{2} = 1$ FOOT

New Rules

RINGS THRU FRAMES TO SHELL 7 DIAS APART EXCEPT IN WAY OF BOTTOM FORD. OF $\frac{1}{2}$ L & IN FORE & AFTER PEAKS WHERE THEY ARE TO BE SPACED $\frac{5}{8}$ DIAS APART

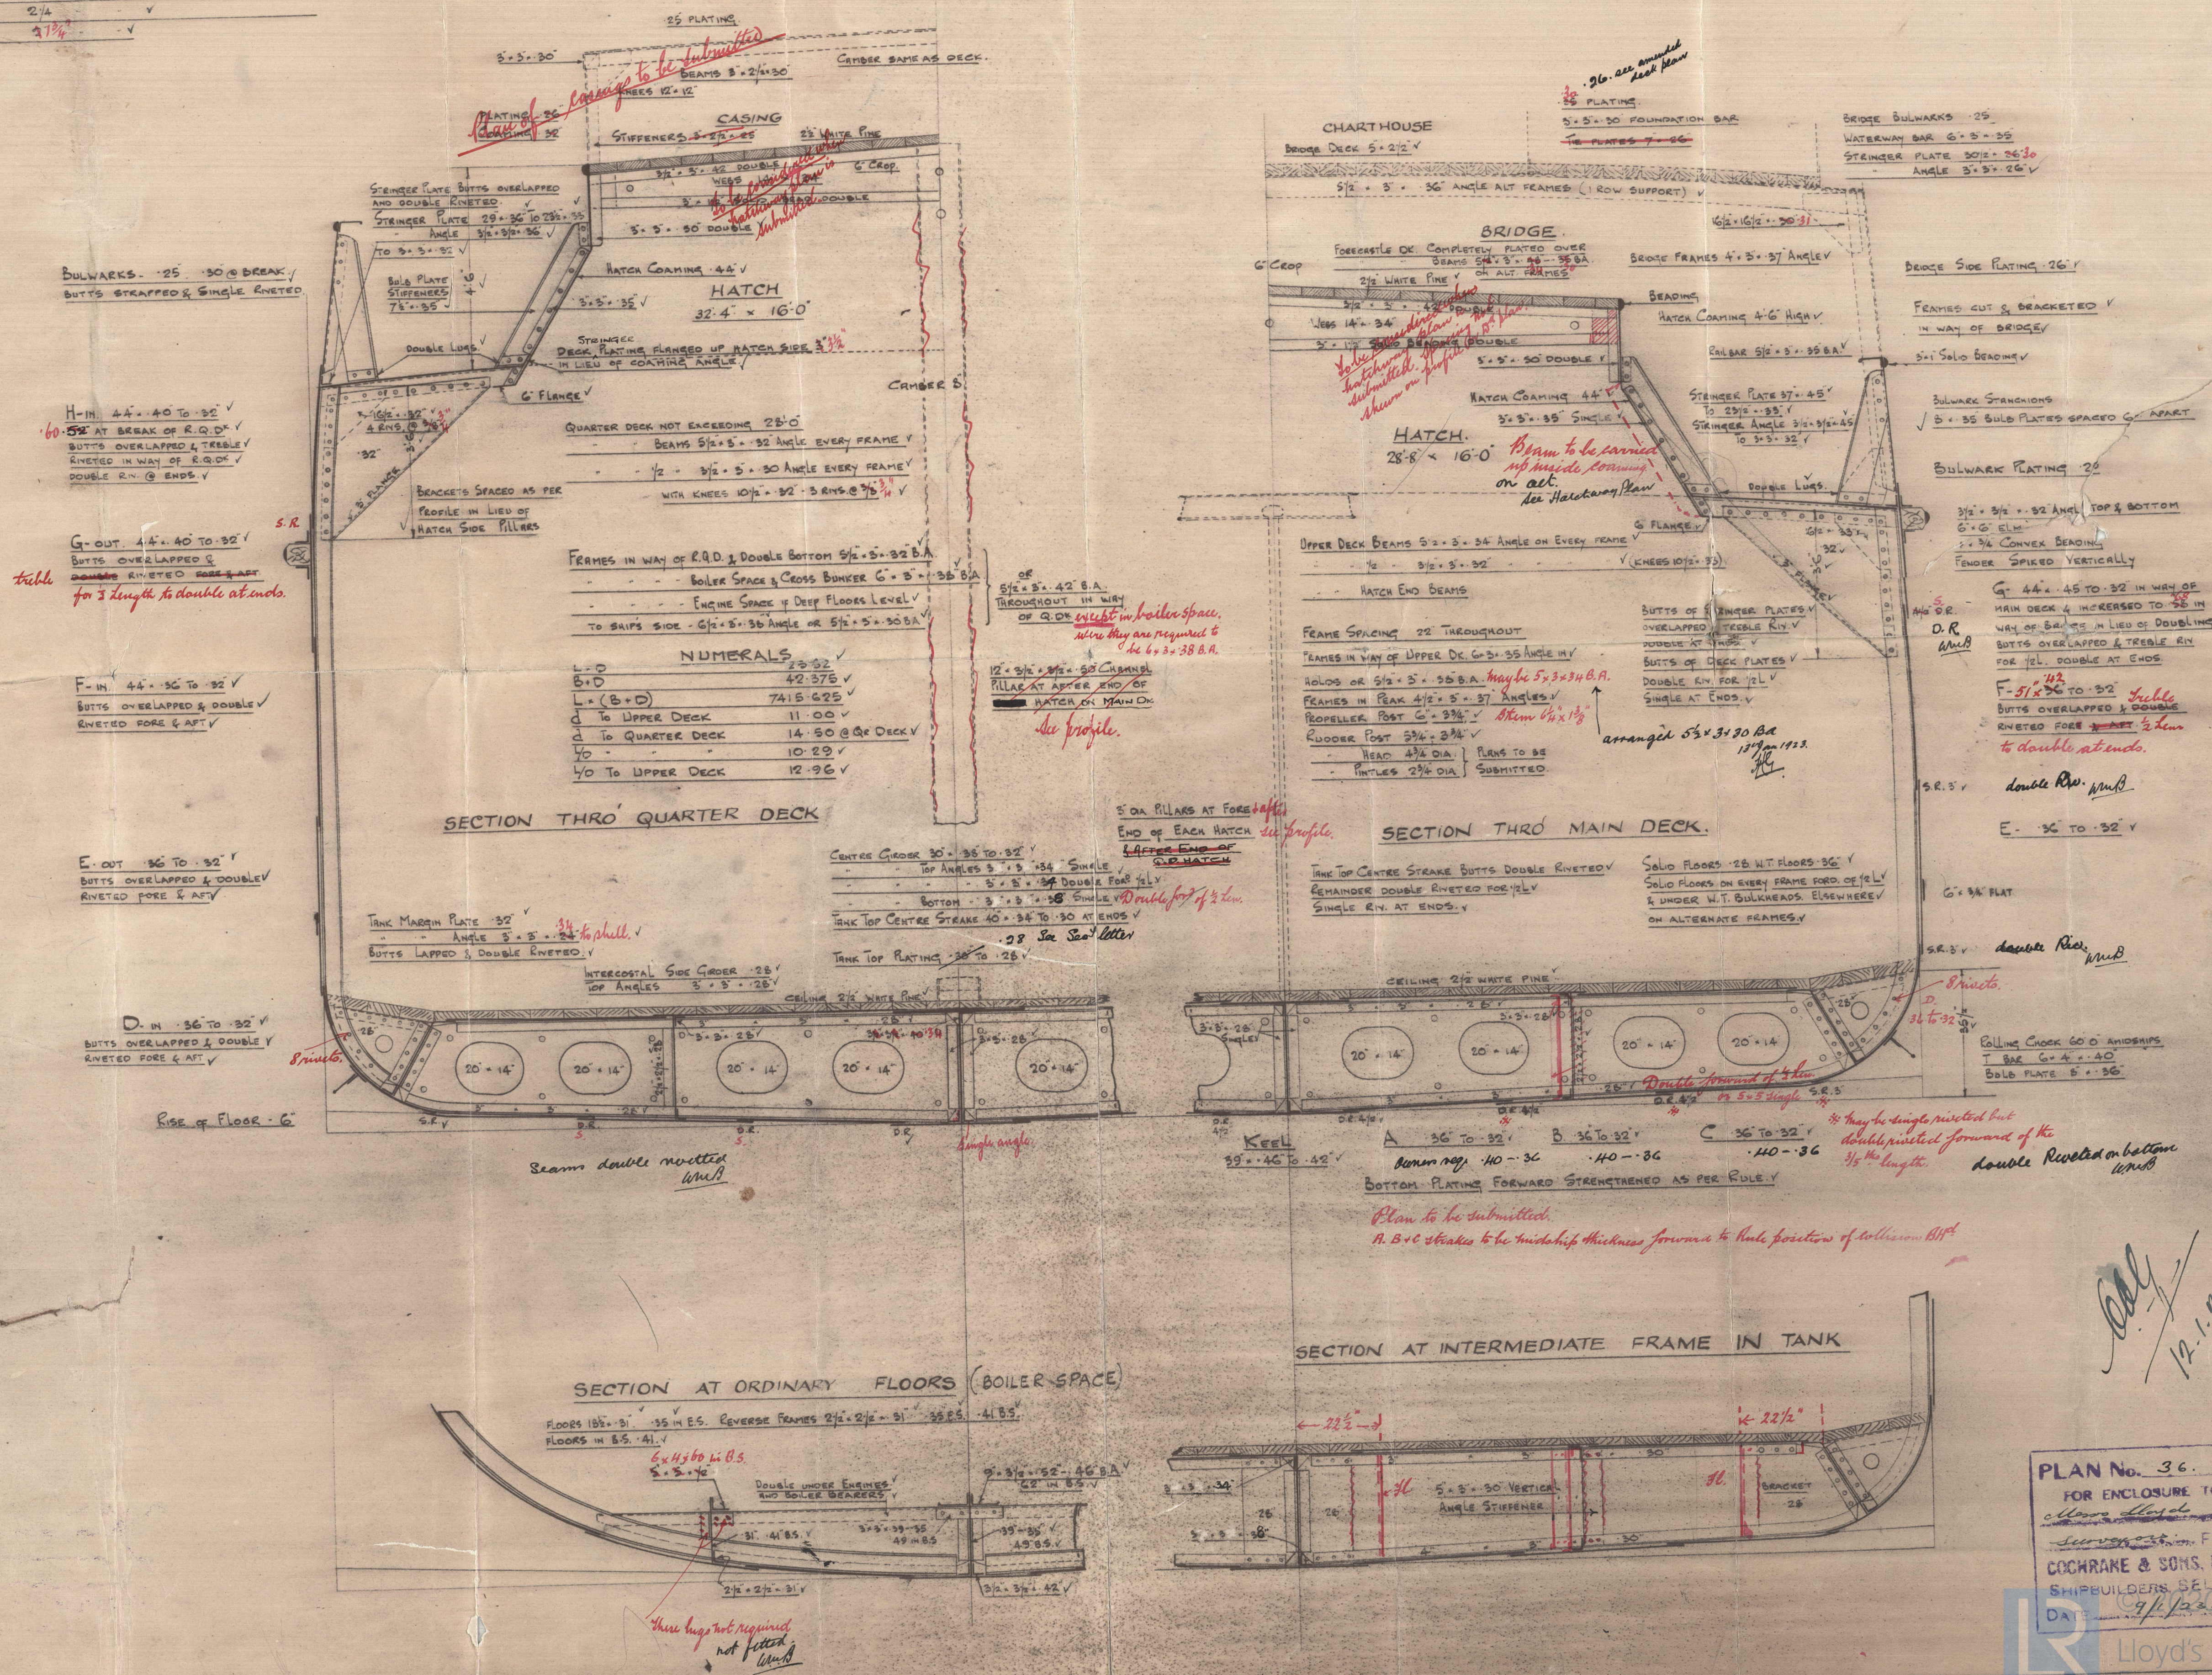

PLAN No. 36.
FOR ENCLOSURE TO
Charles Lloyd
Surveyor. FROM
COCHRANE & SONS, LTD
SHIPBUILDERS, GLEBE
DATE *9/1/23.*

Lloyd's Register
Foundation

W49-0115

Midship Section
Cochrane
m 788+9
how Rules

s/s Malrix Hull Rft No. 34386
- Lestix - - - 34905

W49-0115



© 2020

Lloyd's Register
Foundation