


MIDSHIP SECTION -
Nos 788-9

DIMNS: 175'-0" BP x 29'-0" EXT. x 13'-6" MLD

SCALE $\frac{1}{2} = 1$ FOOT

Equipment to Rule


PLAN No. 6390
FOR ENCLOSURE TO
Messrs. Lewis Surveyors
Sull FROM
COCHRANE & SONS, LTD.
SHIPBUILDERS, SELBY.
DATE 23/12/22.

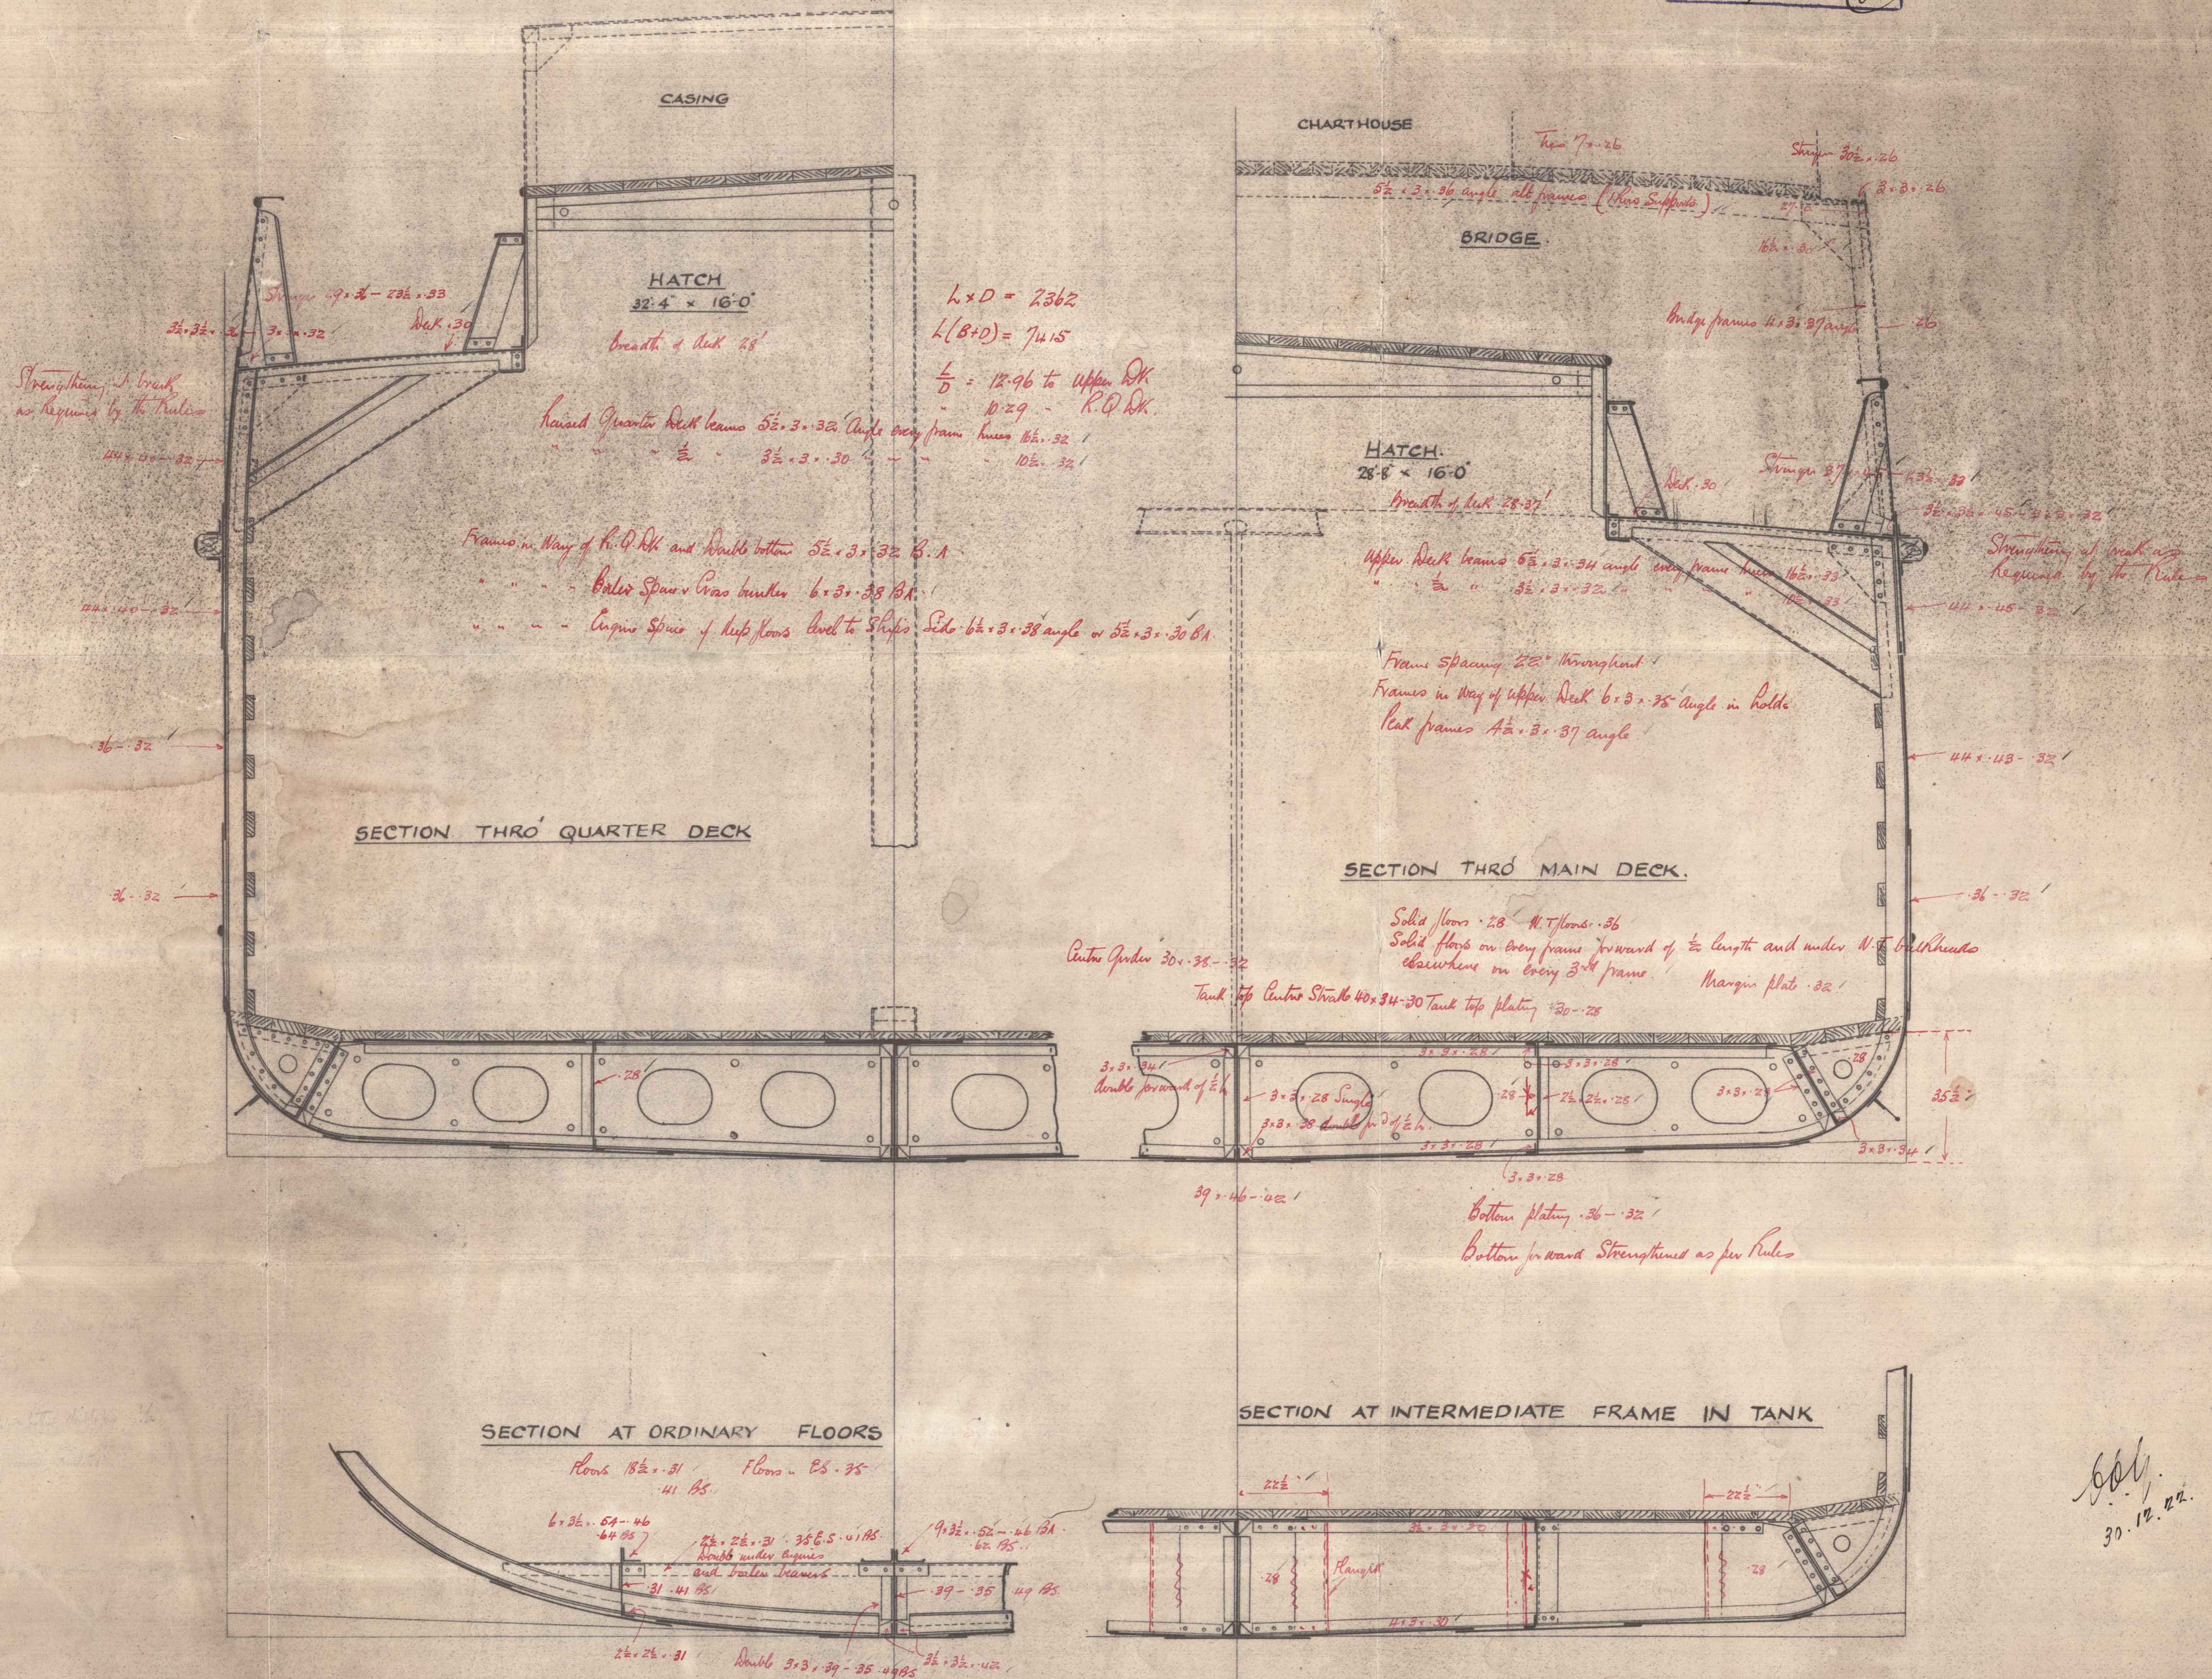

604.
30. 12. 22.

126
108
24 x 45
62 x 80

ENCLOSURE
No 878
JAN 1870

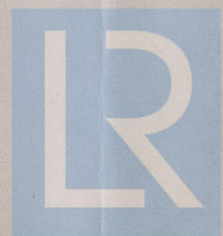

© 2020

Lloyd's Register
Foundation

Cochrane's

N^o 78849

Outline

Midship Section

Revised Rules 1922

Scantlings filled in
in London office.

See later

St. Malin Hull Rpt No. 34386
- Lewis - - - 34905



© 2020

Lloyd's Register
Foundation

W49-0116