

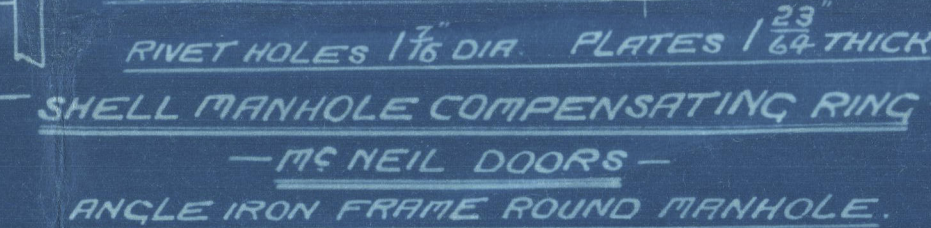


⑧ HEATING SURFACE CALCULATED TO 3" BELOW FURNACE CENTRE LINE
TOTAL HEATING SURFACE ALL BOILERS (MAIN & AUXILIARY) = 12,300 sq
" GRATE AREA " " " " = 264.25

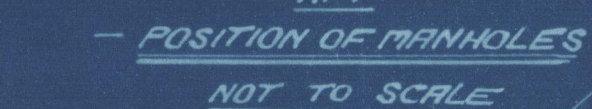

29/5/13

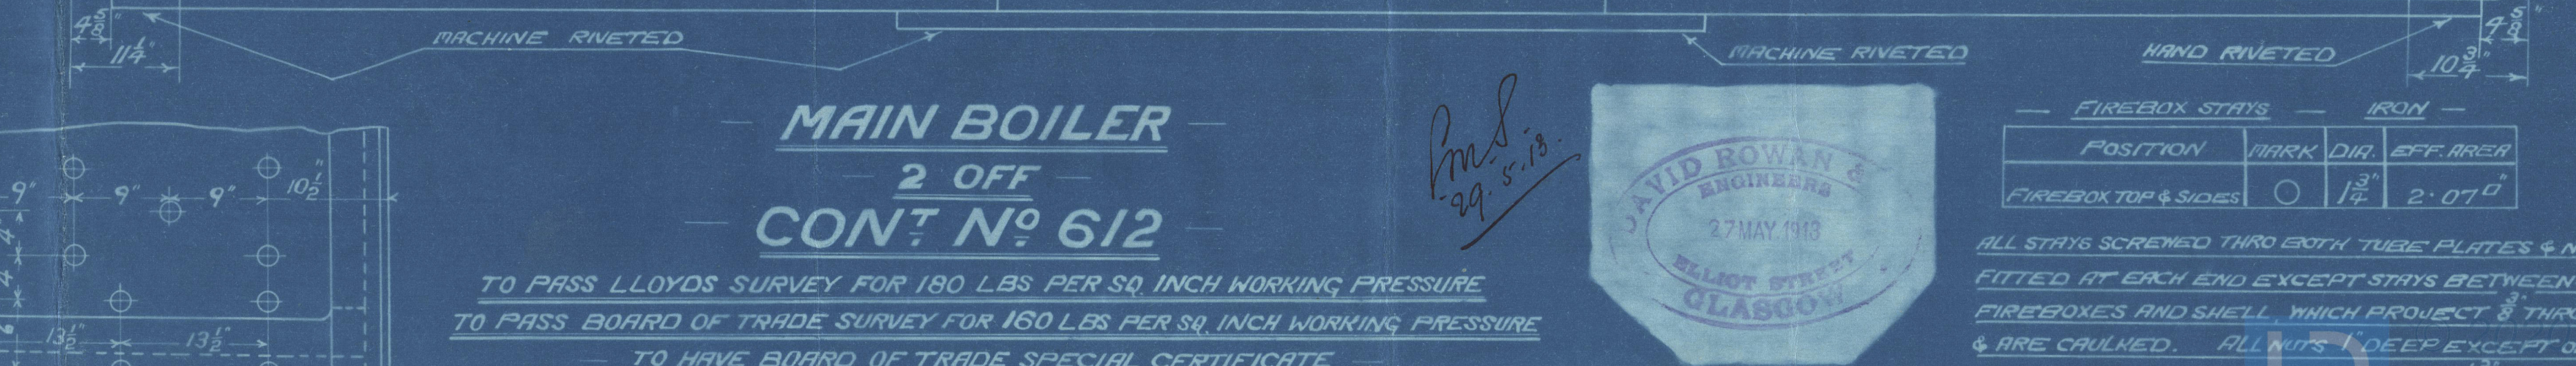



MAIN BOILER
2 OFF
CONT. N° 612

TO PASS LLOYDS SURVEY FOR 180 LBS PER SQ. INCH WORKING PRESSURE
TO PASS BOARD OF TRADE SURVEY FOR 160 LBS PER SQ. INCH WORKING PRESSURE
— TO HAVE BOARD OF TRADE SPECIAL CERTIFICATE —



TRG NO 50017
TRACED 27TH MAY 1913

David Rowan & Co.
Main Boiler
N^o 612.

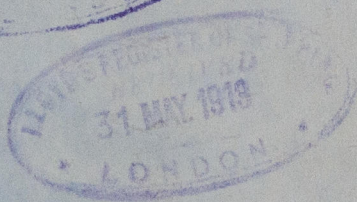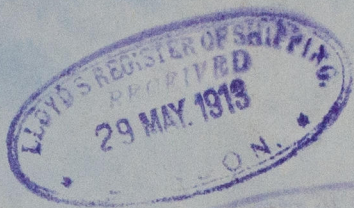

5/8 "Mahanada"

GLASGOW REPORT No. 34565



© 2020

Lloyd's Register
Foundation

W49-0132