


12.11.13  
8-6-14 (10036)  
8-3-15 (155)

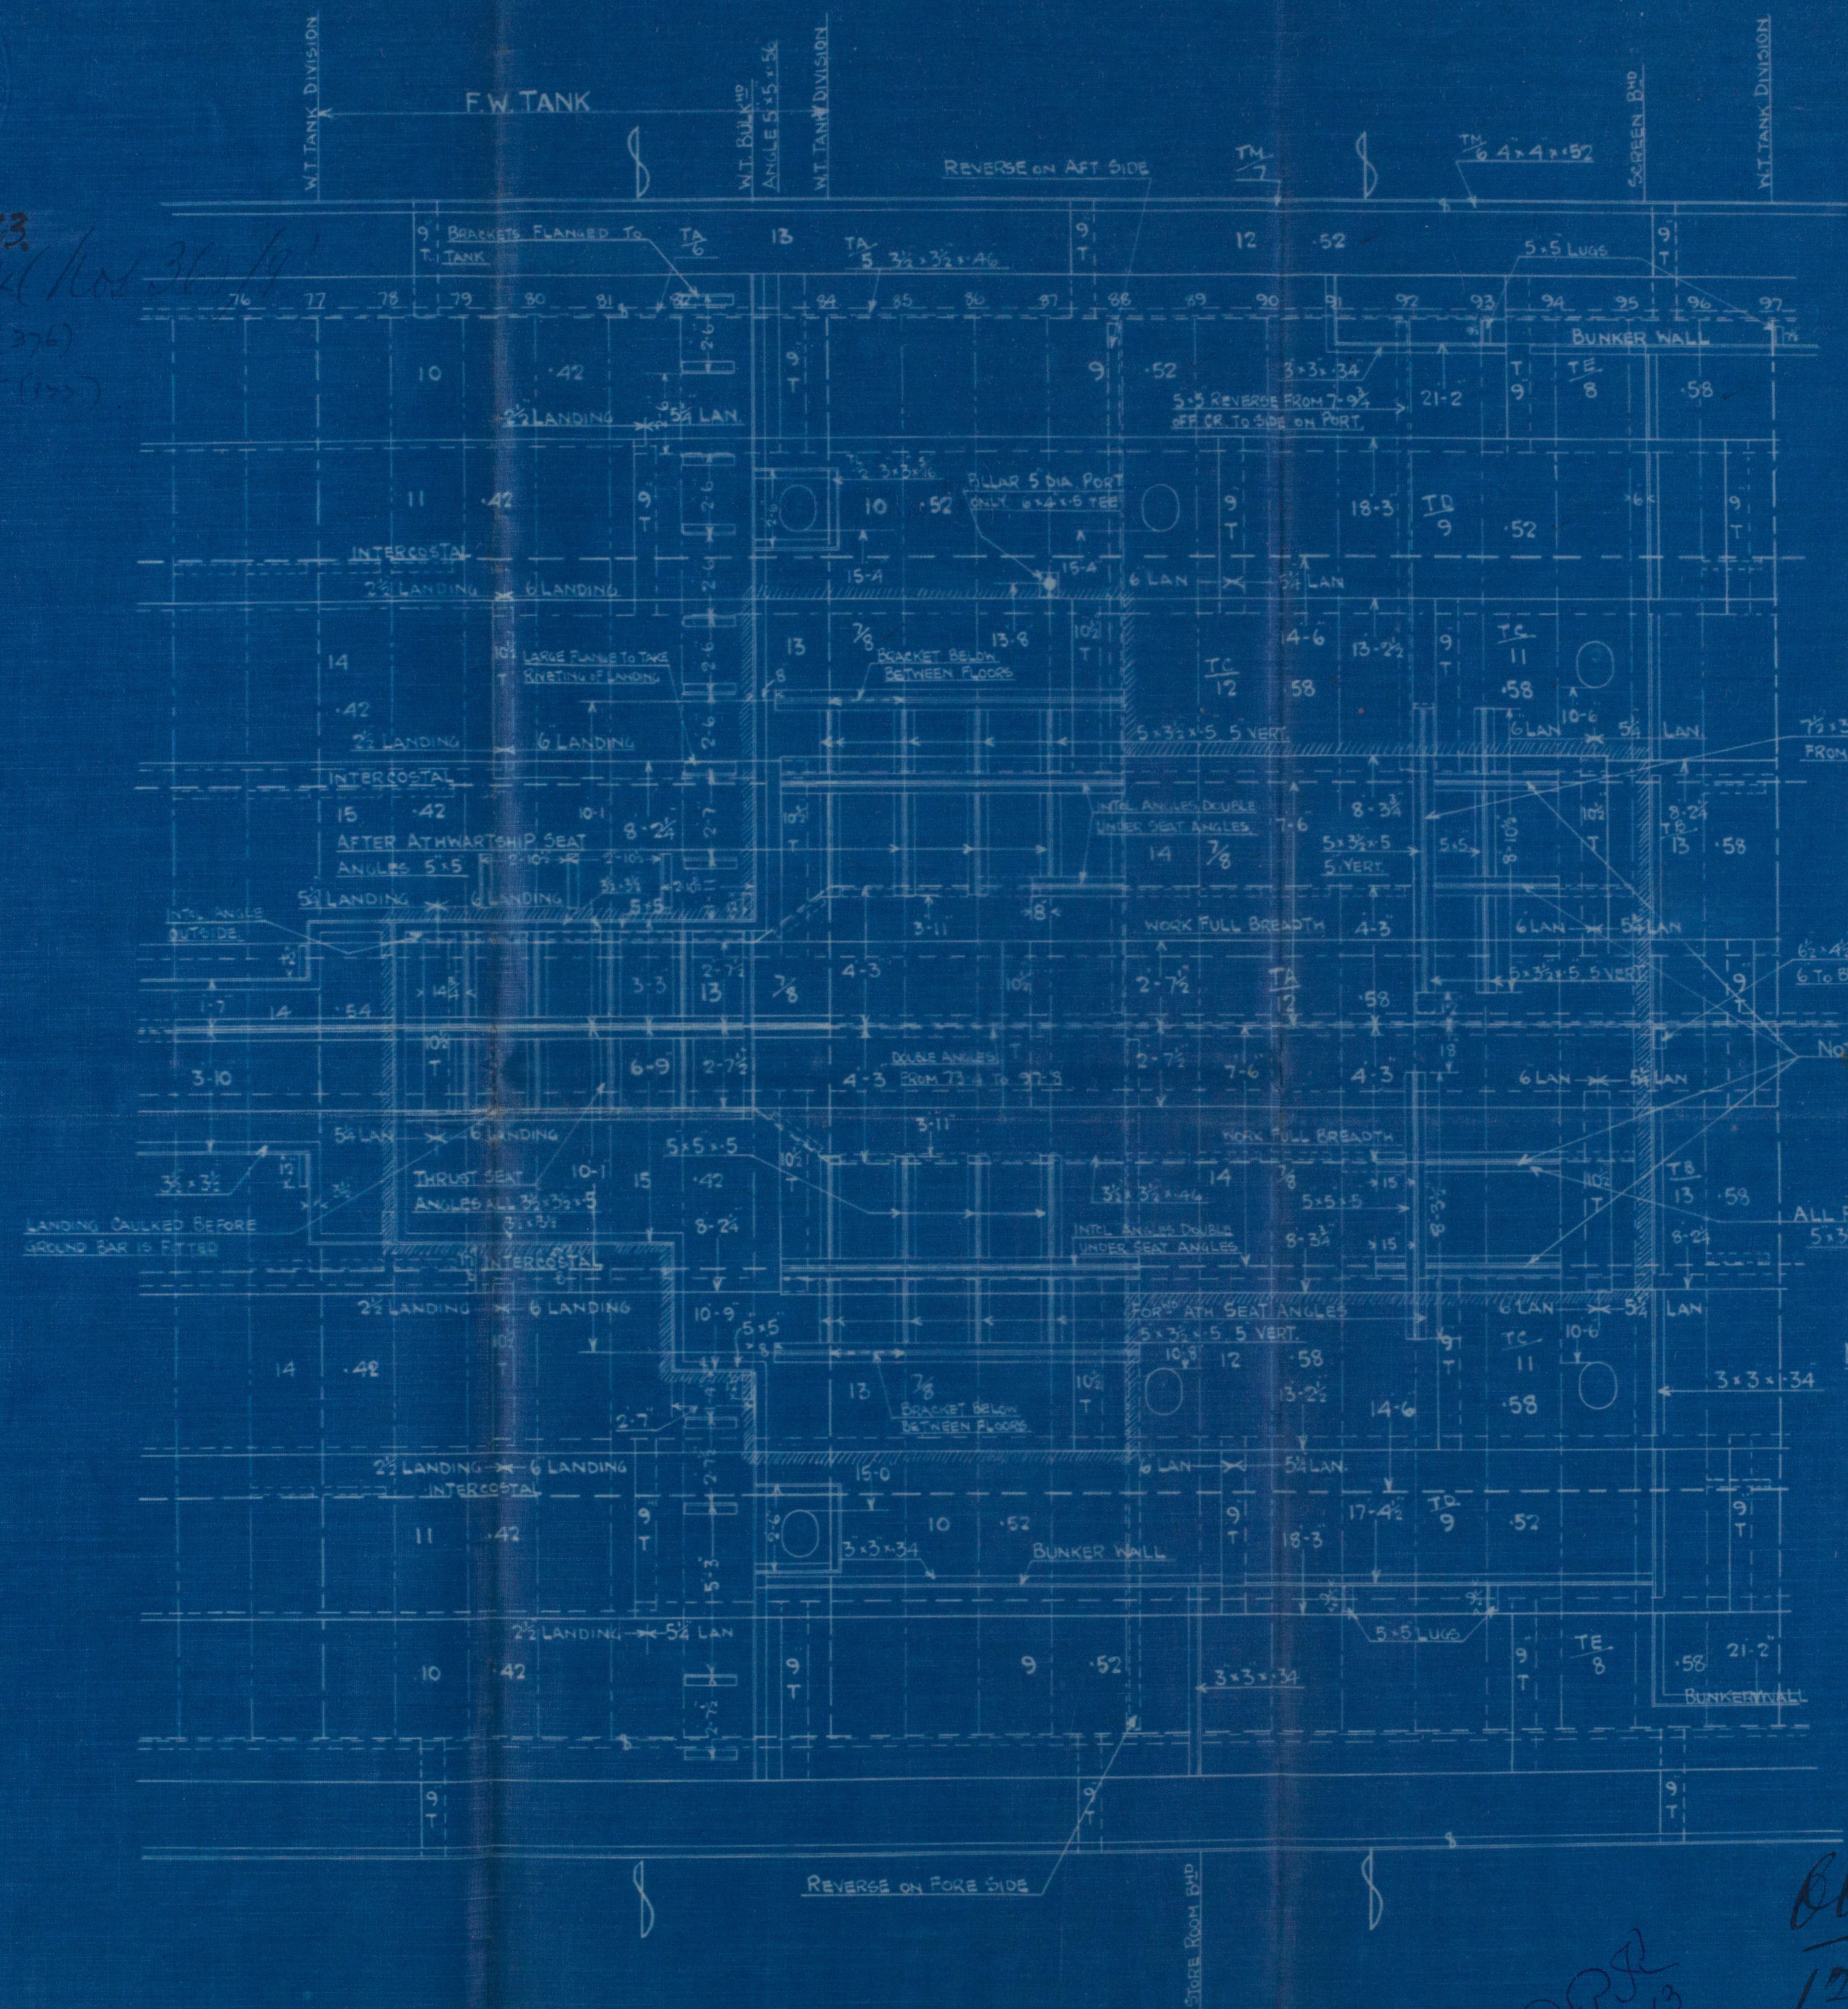


# TANK TOP

Nº 361 SS. 377

SCALE 1/4" = 1 FOOT

TANK TOP PLATING				
TA 12	1 STEEL	23-10	43 1/2	58
13	"	19-0 1/2	43 1/2	7 1/8
TB 13	2 STEEL	16-9 1/2	72 1/2	58
14	"	26-1 1/2	74 1/2	7 1/8
TC 12	2 STEEL	12-3 1/2	65 1/2	58
13	"	19-3	65 1/2	7 1/8
TD 9	2 STEEL	16-10	66 1/2	52
10	"	19-1 1/2	66 1/2	52

12.11.13  
12.11.13

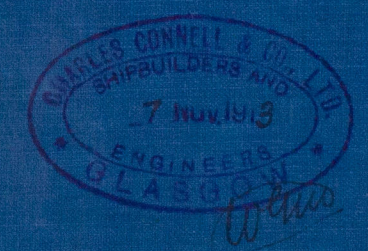

W49-013




C Connell & Co.  
Tank Top in  
Engine Space

N<sup>o</sup> 361  
+ hos 368/9 + 376



N<sup>o</sup> 361 *Is Mahanada*


GLASGOW REPORT No. 34565

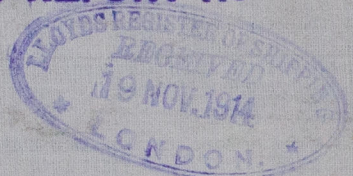

GLASGOW REPORT No. 34123

*Is Manaar*

GLASGOW REPORT No. 34354 *Is Marja*

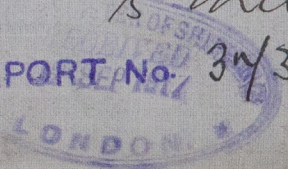


W49-0133

C. Connell & Co. Ltd.

N<sup>o</sup> 361.

Tank top

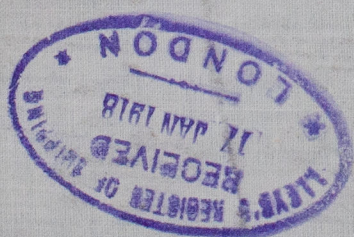

© 2020

Lloyd's Register  
Foundation