

DELETE WORDS WHICH DO NOT APPLY.

The Crew are, are not, berthed in the bridge house.

The arrangements to enable them to get backwards and forwards from their quarters are, are not satisfactory.

Length of Bulwarks in well

Area of freeing ports required by Para. 11 (e) each side of vessel

Freeing Ports (each side of vessel)

Ft. Tenths. Ft. Tenths. No.

Total deficiency =

Sq. Ft.

Total excess =

Vertical distance from bottom of keel or from top of deck at side amidships to lower edge of lowest side scuttle.

(N.B.—This dimension need not be reported unless the sill of the lowest side scuttle would be less than 6 inches above the Indian Summer Load Line if assigned under the tables.)

Do all the Frames extend to the top height in the Poop? *Yes Shelter deck*

Do. do. do. in the Raised Quarter Deck? *Yes*

Do. do. do. Bridge House? *Yes Shelter deck*

Do. do. do. Forecastle? *Yes Shelter deck*

To what height do the Reverse Frames extend? *Yes upper & Shelter deck alternately*

Has the Poop or Raised Quarter Deck an efficient Iron Bulkhead at the fore end? *Yes at Comage opening*

Give particulars of the means for closing the openings in Bulkhead *Weatherboards full height*

Is the Poop or raised Quarter Deck connected with the Bridge House? *Yes by plans*

State whether the Bridge House efficiently covers the Engine and Boiler Openings *Yes*

Has the Bridge House an efficient Iron Bulkhead at the fore end? *Yes*

Give particulars of the means for closing the openings in Bulkhead *Yes*

Describe how and to what extent it is Stiffened, give scantlings and spacing of Angle Irons, Bulb Plates, etc. *Yes*

Has the Bridge House an efficient Iron Bulkhead at the after end? *Yes at Comage opening*

How are the openings closed? *Weatherboards full height*

Is the forecastle at least as high as the main or top-gallant rail? *Yes*

Has the Forecastle an efficient Iron or Wood Bulkhead at its after end? *Yes*


Are the Hatchways efficiently constructed? *Yes* What is the thickness of the Hatches? *2 1/2*

State the height of the Coamings in fore well? *Yes* In after well *No deck openings*

Are the exposed parts of the Engine and Boiler Casings efficiently constructed? *Yes*

State any special features in the construction of the Vessel *Has been Constructed in*

3 Plans accordance with the approved amended plans attached
a Fairboard request form is also attached
Efficient temporary coamings

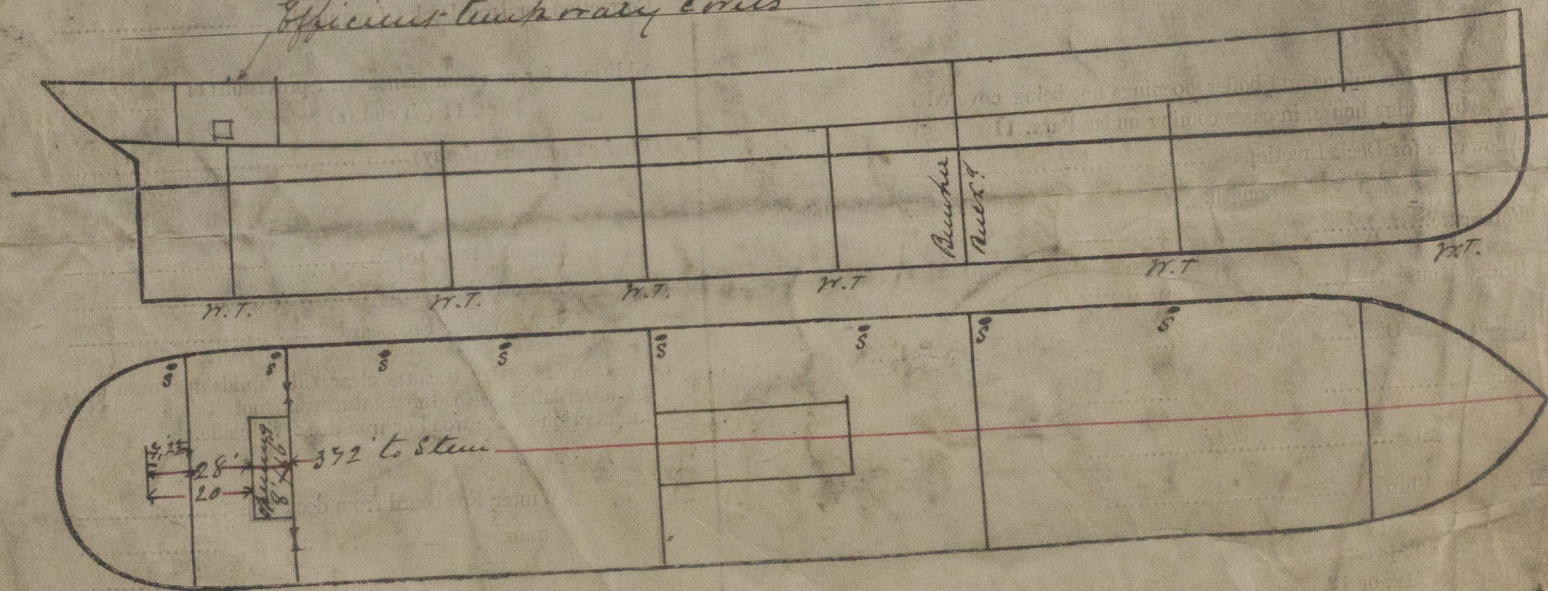

Show hereon the actual measurements of sheer, draft, erections, breaks in line of floors, &c.

Owners

Address

Fee £

Received by me



© 2020

Lloyd's Register Foundation