


— Alternative Midship Section of Twin Screw Steamer. —

— Dimensions 500' + 62' + 37'-6" to Upper Deck. —

— Tr Class 100. A.1. Llyods. —

— Scale  $\frac{1}{2}'' = 1$  Foot. —

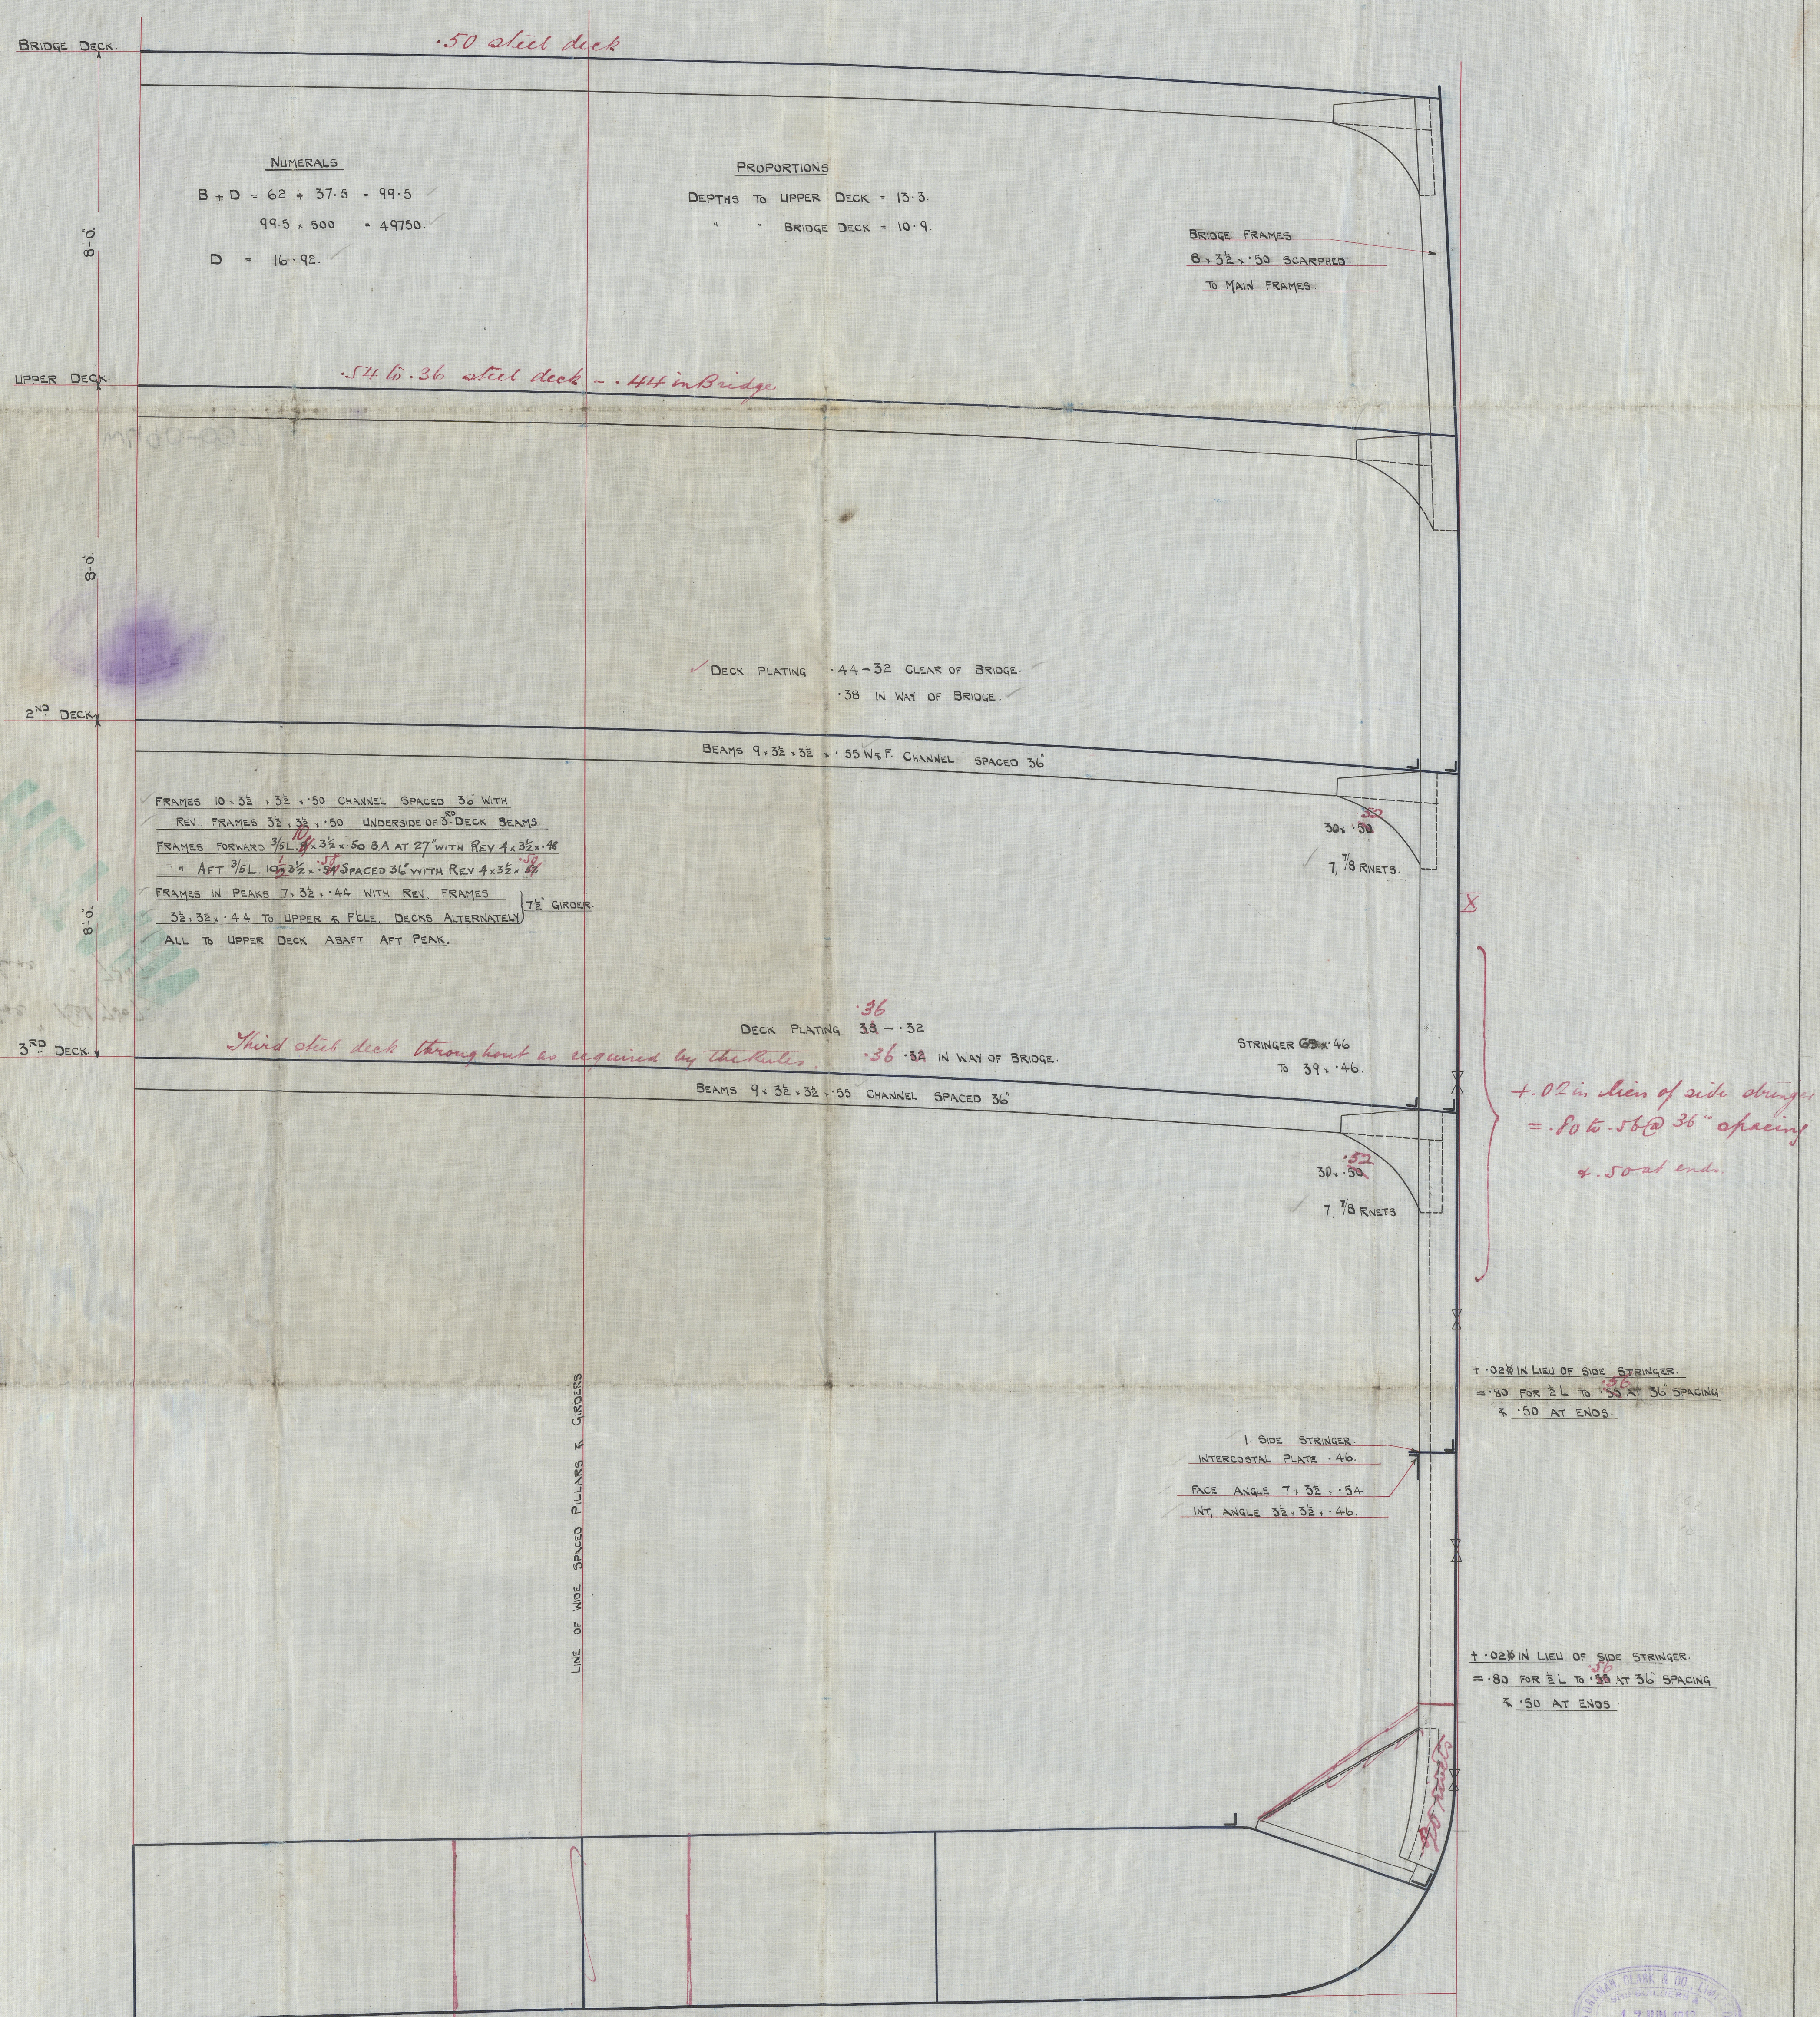

ALL OTHER SCANTLINGS AS ON ORIGINAL SECTION.

C.F.  
12/6/12





For Enclosure to

Foundation

*Messrs. Lloyds Surveyors*


W490-0071½



Wickman Clark & Co


N<sup>o</sup> 324-5

alternative Sketch of  
Midship Section

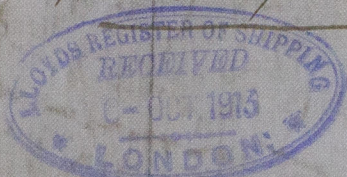

Ill. "Cardiganshire" Rel 7307.

Ill. "Carnarvonshire" " 7347.

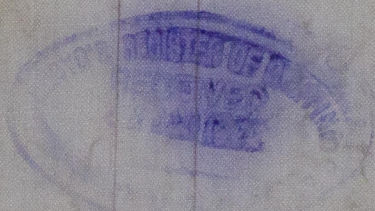

© 2020

Lloyd's Register  
Foundation

W490-0071