

21. 10. 12.


T. S. S. N^os 324-5.

LONGITUDINAL SECTION.

DIMENSIONS 500' x 62' x 37' 6"

TO CLASS 100 A.1. LLOYDS

SCALE $\frac{1}{8}$ " = 1 FOOT.

 

Boatman Class 100

1007, 1008

For Enclosure to

Messrs. Lloyds Surveyors




W490-0073
1/2

Workman Clark 160
No. 324 5325

Outline profile showing
lengthened erection.

S.S. Cardiff and
Carnarvon

Rel 7307.
" 7346.

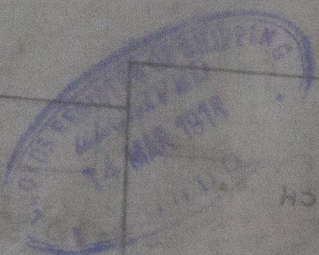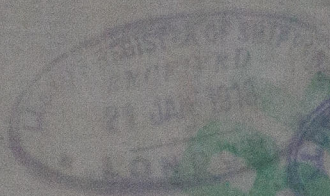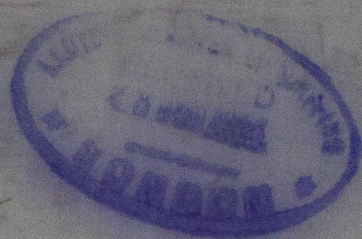

CREW

WORKMAN CLARK

W490-007



© 2020

Lloyd's Register
Foundation