

—To CLASS 100 A.I. LLOYDS.—



For Enclosure

*Messrs. Lloyds*

W490-0077  
112








Belfast  
Warkman Clark & Co  
S.S. 324-5

Amended Midship Section

Signed Copy of Approved Model

S.S. Cardigan Cove Bel 7507

" Carnarvon Cove " 7346

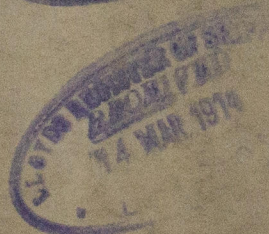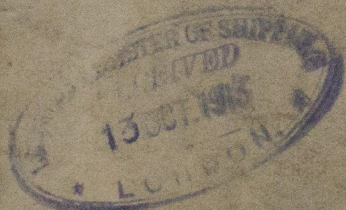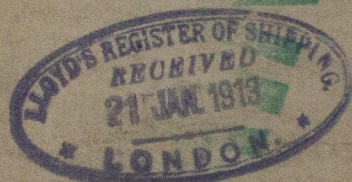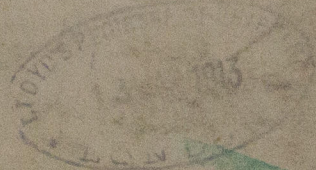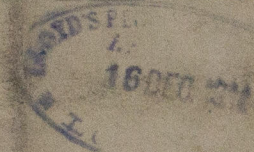

W490-0077



© 2020

Lloyd's Register  
Foundation