

Lloyd's Register of Shipping.

SURVEYS FOR FREEBOARD.

Index. No. **23510**
(For London Office only.)26 SEP 1932 **114****14737**

Computation of Freeboard for Steamer, ~~Sailing Ship~~, Tanker
having POOP BRIDGE & FORECASTLE.

(Type of Superstructures.) 132049

Ship's Name <u>1/2 CARNARVONSHIRE.</u>	Nationality and Port of Registry <u>BRITISH BELFAST.</u>	Official Number <u>132049.</u>	Gross Tonnage <u>9385</u>	Date of Build <u>1914-3.</u>
---	---	-----------------------------------	------------------------------	---------------------------------

Port of Survey MIDDLESBROUGH.
Date of Survey 22, 23 Sept/32
Name of Surveyor Capt B. Scorer

Moulded Dimensions: Length 499.5 Breadth 62.0 Depth 37.65
Moulded displacement at moulded draught = 85 per cent. of moulded depth 22185 tons
Coefficient of fineness for use with Tables .786

Particulars of Classification 100 A.1.
S.S. Harb No. 3-4, 26
Survey 1420 8/20/32
S.S. Harb No. 1-30

<p>Depth for Freeboard (D)</p> <p>Moulded depth ... <u>37.55</u></p> <p>Stringer plate ... <u>.05</u></p> <p>Sheathing on exposed deck <u>WOOD DECK 3"</u></p> <p>$T \left(\frac{L-S}{L} \right) =$ <u>✓</u></p> <p>Depth for Freeboard (D) = <u>37.60</u></p>	<p>Depth correction</p> <p>(a) Where D is greater than Table depth (D-Table depth) R = $(37.60 - 33.30) 3.00$ = <u>+12.9"</u></p> <p>(b) Where D is less than Table depth (if allowed) (Table depth-D) R = <u>✓</u></p> <p>If restricted by superstructures <u>✓</u></p>	<p>Round of Beam correction</p> <p>Moulded Breadth (B) <u>62.00</u></p> <p>Standard Round of Beam = $\frac{B \times 12}{50} =$ <u>14.88"</u></p> <p>Ship's Round of Beam = <u>15.1"</u></p> <p>Difference <u>.12 excess</u></p> <p>Restricted to</p> <p>Correction = $\frac{\text{Diff}^2}{4} \times \left(1 - \frac{S_1}{L} \right) =$ $\frac{.12^2}{4} \times .2562 =$ <u>-.01"</u></p>
--	---	---

DEDUCTION FOR SUPERSTRUCTURES.

	Mean Covered Length (S)	Equivalent Enclosed Length (S ₁)	Height	Height Correction	Effective Length (E)	
Poop enclosed ...	<u>107.2</u>	<u>105.53</u>	<u>7.9"</u>		<u>105.53</u>	Standard Height of Superstructure <u>7.6"</u>
" overhang ...	<u>14.44</u>	<u>.82</u>			<u>.82</u>	" " R.Q.D. <u>✓</u>
R.Q.D. enclosed ...						Deduction for complete superstructure <u>42.00"</u>
" overhang ...	<u>174.07</u>					Percentage covered $\frac{S}{L} =$ <u>75.08%</u> <u>✓</u>
Bridge enclosed ...	<u>180.0</u>	<u>174.07</u>	<u>8.0"</u>		<u>174.07</u>	" " $\frac{S_1}{L} =$ <u>74.38%</u> <u>✓</u>
" overhang aft ...	<u>40.23</u>	<u>2.20</u>			<u>2.20</u>	" " $\frac{E}{L} =$ <u>74.38%</u>
" overhang forward ...	<u>3.23</u>	<u>1.50</u>			<u>1.50</u>	Percentage from Table, Line A. -
F'cle enclosed ...	<u>87.02</u>	<u>87.02</u>	<u>7.6"</u>		<u>87.02</u>	(corrected for absence of forecastle (if required))
" overhang ...	<u>40</u>	<u>.40</u>			<u>.40</u>	Percentage from Table, Line B.
Trunk aft ...						(corrected for absence of forecastle (if required)) <u>68.39%</u>
" forward ...						Interpolation for bridge less than 2L (if required)
Tonnage opening aft ...						Deduction = <u>42.00</u> x <u>.6839</u> = <u>-28.72"</u>
" " forward ...						
Total ...	<u>375.00</u>	<u>371.54</u>			<u>371.54</u>	

SHEER CORRECTION.

Station	Standard Ordinate	S	M	Product	Actual Ordinate	Effective Ordinate	S	M	Product	
A.P. ...	<u>59.95</u>	<u>1</u>		<u>59.95</u>	<u>58.75</u>	<u>58.75</u>	<u>1</u>		<u>58.75</u>	Mean actual sheer aft = <u>Deficient</u> <u>> 75%</u> <u>✓</u>
1/2 L from A.P. ...	<u>26.67</u>	<u>4</u>		<u>106.68</u>	<u>26.08</u>	<u>26.00</u>	<u>4</u>		<u>104.00</u>	Mean actual sheer forward = <u>Excess</u>
2/3 L " ...	<u>6.59</u>	<u>2</u>		<u>13.18</u>	<u>6.52</u>	<u>4.50</u>	<u>2</u>		<u>9.00</u>	Mean standard sheer forward = <u>Excess</u>
Amidships ...	<u>✓</u>	<u>4</u>		<u>✓</u>	<u>✓</u>	<u>✓</u>	<u>4</u>		<u>✓</u>	Length of enclosed superstructure
2/3 L from F.P. ...	<u>13.19</u>	<u>2</u>		<u>26.38</u>	<u>13.15</u>	<u>15.50</u>	<u>2</u>		<u>31.00</u>	forward of amidships = <u>> 1L</u>
1/2 L " ...	<u>53.35</u>	<u>4</u>		<u>213.40</u>	<u>52.60</u>	<u>53.25</u>	<u>4</u>		<u>213.00</u>	" " aft of " = <u>> 1L</u>
F.P. ...	<u>119.90</u>	<u>1</u>		<u>119.90</u>	<u>118.37</u>	<u>118.37</u>	<u>1</u>		<u>118.37</u>	
Total ...				<u>539.49</u>					<u>534.12</u>	

Correction = $\frac{\text{Difference between sums of products}}{18} \left(\frac{75-S}{2L} \right) = \frac{5.37}{18} \left(\frac{.75-.3754}{.3746} \right) =$ + .11"

If limited on account of midship superstructure. ✓ If limited to maximum allowance of 1 1/2 ins. per 100 ft. ✓

<p>Deduction for Tropical Freeboard.</p> <p>Addition for Winter and Winter North Atlantic Freeboard.</p> <p>Depth to Freeboard Deck = <u>37.81</u> Ft.</p> <p>Summer freeboard = <u>8.68</u></p> <p>Moulded draught (d) = <u>29.73</u></p> <p>Deduction for Tropical freeboard and addition for Winter freeboard = $\frac{d}{4}$ inches = <u>7.43" = 7 1/2"</u></p> <p>Addition for Winter North Atlantic Freeboard (if required) = <u>✓</u></p>	<p>Deduction for Fresh Water.</p> <p>Displacement in salt water at summer load water line</p> <p>$\Delta =$ <u>20970</u></p> <p>Tons per inch immersion at summer load water line</p> <p>$T =$ <u>62.86</u></p> <p>Deduction = $\frac{\Delta}{40 T}$ inches = <u>8.34" = 8 1/4"</u></p>	<p>TABULAR FREEBOARD corrected for Flush Deck (if required)</p> <p>Correction for coefficient $\frac{786 + .68}{1.36} = \frac{1466}{1360}$</p> <table border="1" style="width: 100%;"> <tr> <th></th> <th>+</th> <th>-</th> </tr> <tr> <td>Depth Correction ...</td> <td><u>12.90</u></td> <td><u>-</u></td> </tr> <tr> <td>Deduction for superstructures ...</td> <td><u>-</u></td> <td><u>28.72</u></td> </tr> <tr> <td>Sheer correction ...</td> <td><u>.11</u></td> <td><u>-</u></td> </tr> <tr> <td>Round of Beam correction ...</td> <td><u>-</u></td> <td><u>.01</u></td> </tr> <tr> <td>Correction for Thickness of Deck amidships ...</td> <td><u>2.50</u></td> <td><u>-</u></td> </tr> <tr> <td>Other corrections, scantlings, etc. ...</td> <td><u>-</u></td> <td><u>-</u></td> </tr> <tr> <td></td> <td><u>15.51</u></td> <td><u>28.73</u></td> </tr> <tr> <td>Summer Freeboard =</td> <td><u>96.88</u></td> <td></td> </tr> </table>		+	-	Depth Correction ...	<u>12.90</u>	<u>-</u>	Deduction for superstructures ...	<u>-</u>	<u>28.72</u>	Sheer correction ...	<u>.11</u>	<u>-</u>	Round of Beam correction ...	<u>-</u>	<u>.01</u>	Correction for Thickness of Deck amidships ...	<u>2.50</u>	<u>-</u>	Other corrections, scantlings, etc. ...	<u>-</u>	<u>-</u>		<u>15.51</u>	<u>28.73</u>	Summer Freeboard =	<u>96.88</u>	
	+	-																											
Depth Correction ...	<u>12.90</u>	<u>-</u>																											
Deduction for superstructures ...	<u>-</u>	<u>28.72</u>																											
Sheer correction ...	<u>.11</u>	<u>-</u>																											
Round of Beam correction ...	<u>-</u>	<u>.01</u>																											
Correction for Thickness of Deck amidships ...	<u>2.50</u>	<u>-</u>																											
Other corrections, scantlings, etc. ...	<u>-</u>	<u>-</u>																											
	<u>15.51</u>	<u>28.73</u>																											
Summer Freeboard =	<u>96.88</u>																												

SUMMER FREEBOARD amidships from Centre of Disc to top of Deck Line, Wood, Steel, Deck:-

Tropical Fresh Water Line above Centre of Disc ...	<u>15.3"</u>	Tropical Fresh Water Freeboard ...	<u>6.9 1/4"</u>
Fresh Water Line " " ...	<u>8 1/4"</u>	Fresh Water " " ...	<u>7.4 3/4"</u>
Tropical Line " " ...	<u>7 1/2"</u>	Tropical " " ...	<u>7.5 1/2"</u>
Winter Line below " " ...	<u>7 1/2"</u>	Winter " " ...	<u>8.8 1/2"</u>
Winter North Atlantic Line " " ...	<u>✓</u>	Winter North Atlantic " " ...	<u>✓</u>

189 SEP 1932

MARKING FORM

18 OCT 1935

RECEIVED

MARKING FORM

-6 APR 1935

RECEIVED

MARKING FORM

-7 OCT 1935

RECEIVED

Lloyd's Register
Foundation

S.S. CARNARVONSHIRE

Particulars of Scuppers and Sanitary Discharge Pipes :—

Particulars of Scuppers and Sanitary Discharge Pipes:—

3. Scuppers from bridge space open pipes with wood plugs on inner end.
Sanitary discharge pipes fitted with storm valves at ships side and efficient traps on inner end.

Particulars of Side Scuttles :—

Particulars of Side Scuttles:—
 All side scuttles below foreboard deck fitted with hinged deadlights.
 All side scuttles in crew space in Poop & Bridge & Forecastle fitted with hinged deadlights.
 Cargo spaces -

all scuttles of substantial construction

Particulars of Guard Rails :—

Particulars of Guard Rails:—

Guard rails on Newcastle deck	3'-9" high	having 6 rods, and Stranchins	3'-10" apart.
" " " Bridge deck	3'-9"	" 5 "	3'-10" "
" " " Top deck	3'-9"	" 6 "	3'-10" "

Steel bulwarks on Foreboard deck in fore and aft with 4'-9" high efficiently constructed and supported.

Particulars of Gangways, Lifelines, etc. :—

None fitted

Suitable provision made for rigging lifelines in any part of the ship which might have to be used by the crew in the regular working of the ship.

Particulars of fiddle, funnel and ventilator coamings: ~~with permanently attached steel cores~~
 5/8" hold gratings ~~not covered and not efficiently supported.~~
 Fiddle and funnel ventilators in efficient condition.
 Engine skylight of steel strongly constructed.

Particulars of Flush Bunker Scuttles:—

None fitted.

Particulars of Companionways :—

Particulars of Companionways:—
Companionway on Forecastle deck 5'-8" x 3'-2" 6'-2" high plating 25" thick solid teak door operated from both sides
Door sill 12"
Companionway on poop deck built on Hatch. Hatch 4'-0" x 3'-8" Coaming 15" x 30" Comp 5'-4" x 3'-1" 6'-0" high steel door
4'-8" x 2'-6" manipulated from both sides sill 28"

Particulars of Ventilators in exposed positions on freeboard and superstructure decks :—

Particulars of Ventilators in exposed positions on freeboard and superstructure decks:—			
10 ft Ventilator on Forecastle deck	12" steel beam	32 1/2 x 25 1/2 to fore peak	2 ft Ventilator on Upper deck
10 ft	15"	31 1/2 x 30 to hold.	16" dia beam
10 ft	15"	28 x 30 to hold.	33 x 35 to deep tank
6 ft	12"	33 x 30 to hold.	2 ft
2 ft	16"	33 x 35 to hold.	Pop. deck
2 ft	12"	27 1/2 x 30 to hold.	14"
2 ft	16"	27 x 35 to hold.	10"
4 ft	16"	27 1/2 x 35 to hold.	16"
			17 x 28 to transverse on
			top of escape trunk, door to trunk 3:0 x 2:6 steel tramped
			and manipulated from both sides, sill 6 1/2"
			all ventilator constructed in accordance with rules and beams closed with wood plugs and canvas covers.

Particulars of Air Pipes in exposed positions on freeboard, raised quarter, or superstructure decks :—

Particulars of Air Pipes in exposed positions on freeboard, raised quarter, or superstructure decks				
On pipes in fore-castle deck	14ft C.I. 26 3/4	high	32	to the forepeak.
Upper deck fore wall	40ft C.I. 25		32	O.B.T.
	20ft C.I. 33		32	O.B.T.
Bridg's deck	64ft C.I. 27		32	
Upper deck after wall	20ft C.I. 26-35		32	
Roof deck	10ft C.I. 27 1/2		32	After peak

bananas covers fitted to all air pipes


Particulars of Gangway Cargo and Coaling Ports:—

3 Watertight coaling doors, P & S. Sides between bridge & upper deck 4'0" x 5'0" efficiently constructed

Particulars of Superstructures, Trunks, Casings, Deckhouses.								
	Coaming	Plating	Stiffeners	Spacing	End Attachments of Stiffeners	Size of Openings	Height of Sills	Height of Casings
Poop Bulkhead	40 1/2 x 40	35	7 x 3 1/2 x 30 1/2	33	NONE	5' 7 1/2" x 4' 0"	14	
Raised Quarter Deck Bulkhead ...								
Bridge, After Bulkhead	40 x 40	35	3 1/2 x 3 1/2 x 36 1/2	30	NONE	46 1/2" x 60 1/2" x 4"	1' 3"	
Bridge, Forward Bulkhead	43 1/2 x 48	40	9 x 3 1/2 x 36 1/2	30	BRACKETS T. B.	36 x 66"	15	
Forecastle Bulkhead	42 x 35	35	4 x 3 x 35 1/2	36	NONE	3' 9" x 5' 6"	14	
Trunk, Aft								
Trunk, Forward								
Exposed Machinery Casings on Free-board or Raised Quarter Decks ...								
Exposed Machinery Casings on Super-structure Decks	3' 3" x 45	40	4 x 3 1/2 x 40	35	NONE	2' 5" 4" x 2' 4" 2' 5" 4" 10" x 3' 10"	14 1/2 15	7' 4 1/2
Machinery Casings within Superstructures not fitted with Class I Closing Appliances	1' 5" x 45	40	4 x 3 1/2 x 40	35	NONE	2' 5" 5' 4" x 2' 4" 2' 5" 4" 10" x 3' 10"	15	
Deckhouses on Flush Deck Ships ...								

Particulars of Closing Appliances (state if capable of being manipulated from both sides).	
Poop Bulkhead	3" storm boards in riveted channels full height with bolted plate over.
Raised Quarter Deck Bulkhead ...	✓
Bridge, After Bulkhead	Storm boards in riveted channels 3" thick full height.
Bridge, Forward Bulkhead	Water tight steel hinged doors P+S. manipulated from both sides.
Forecastle Bulkhead	Hinged wood doors. manipulated from both sides.
Exposed Machinery Casings on Free-board or Raised Quarter Decks ...	
Exposed Machinery Casings on Super-structure Decks	Wood doors (Cold) to Engine room P+S. Sides. manipulated from both sides.
Machinery Casings within Superstructures not fitted with Class I Closing Appliances	Steel doors to coal shoots. manipulated from outside only.
Deckhouses on Flush Deck Ships ...	Steel hinged doors to coal shoots manipulated from outside only.

Superstructure bulkheads, trunks, deckhouses, casings, cargo and coaling hatchways, extent and thickness of sheathing on the freeboard deck, coaling ports, and any other openings, etc., which would affect the seaworthiness of the ship are to be shewn on the following sketches:—

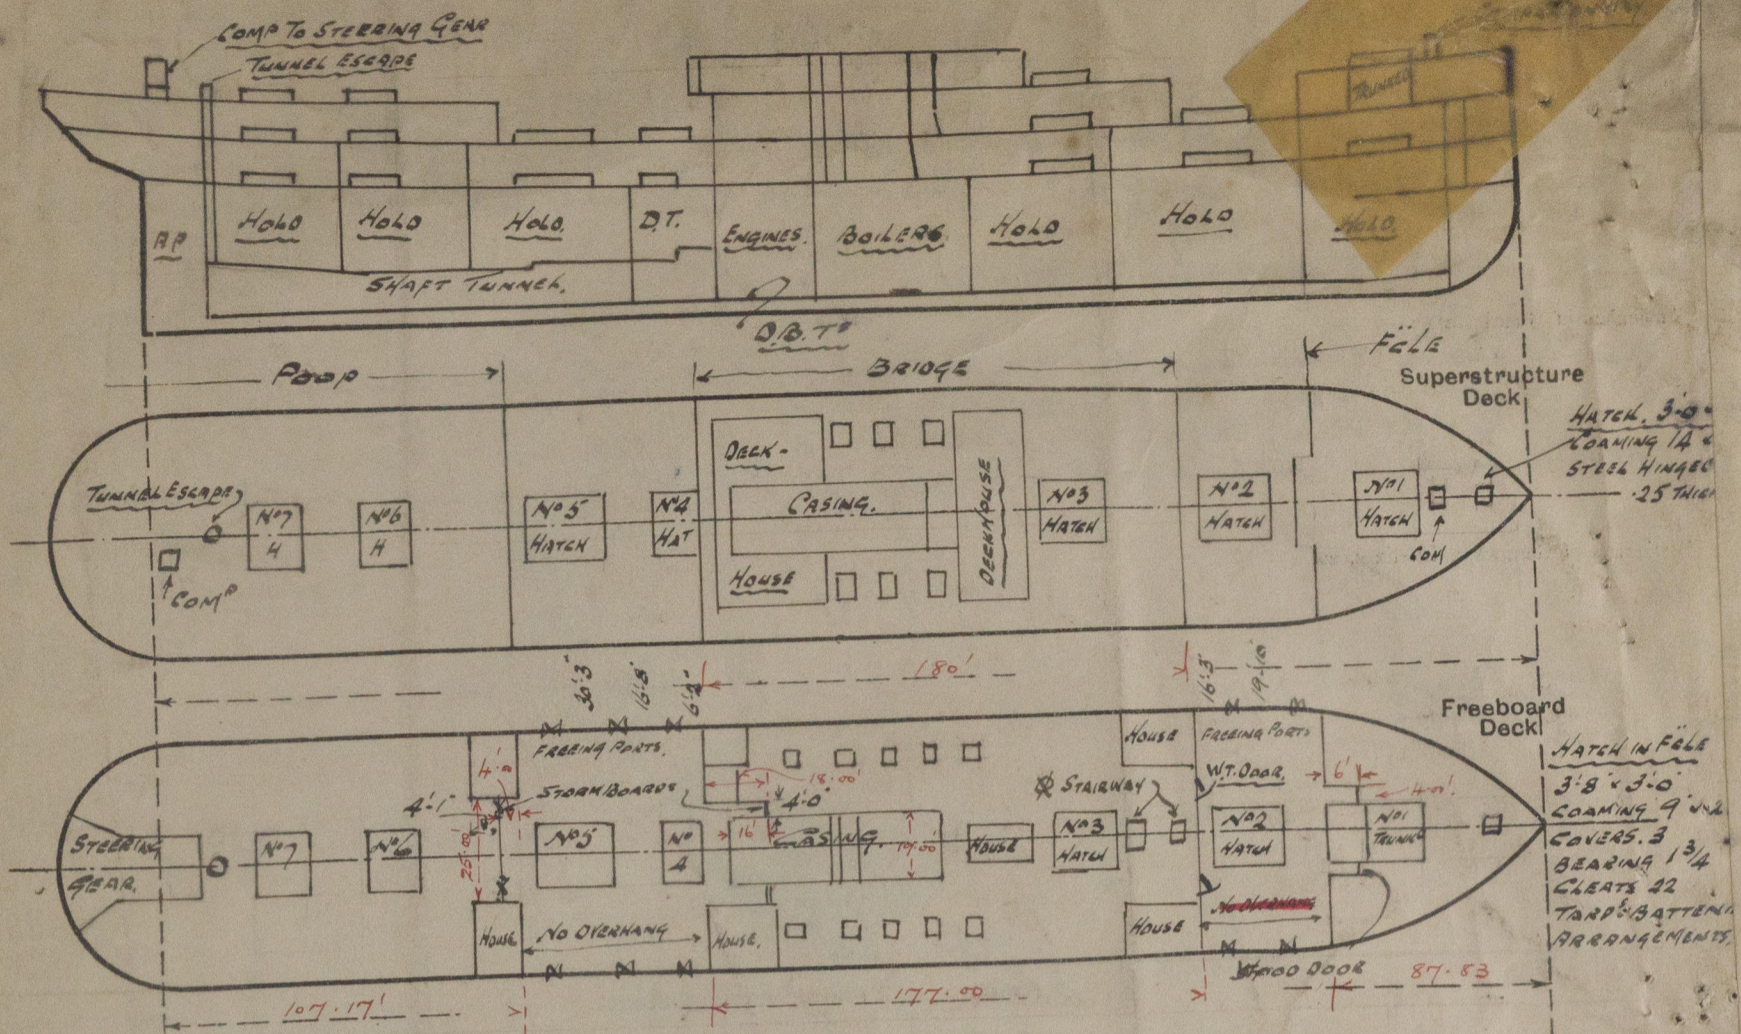

State any special features in the construction of the ship:—

BUNKER HATCHES ON BRIDGE DECK
 2 OFF. 4'6" x 4'0" P.S.
 1 OFF. 4'0" x 4'0" P.S.
 COAMINGS 30" x 35"
 COVERS 5" BEARING 2"
 CLEATS 24 APART
 TARP & BATTENING ARR.

BUNKER HATCH IN BRIDGE
 4 OFF. 5'0" x 4'0"
 1 OFF. 4'10" x 2'9"
 9' x 33' x 5' B.P. COAMING 9" (6" ABOVE DECK)
 COVERS 3" BEARING 2" CLEATS 2'3"
 TARPULING & BATTENING ARR.

STAIRWAYS IN BRIDGE
 1 OFF. 7'6" x 7'0"
 1 OFF. 6'8" x 3'8"
 33' x 33' ANGLE COAMING
 PLANKED OVER WITH 3" HATCH COVERS & CALLED
 NO SUPPORTS

Survey held afloat and confined to obtaining the above particulars.

Port
 Reass $\frac{25 \times 4}{61}$ - $\frac{107.17}{1.64}$ O.H.
 105.53 equs

Bridge
 Reass $\frac{18 \times 4}{31}$ - 2.32 $\frac{2.93}{174.07}$ O.H. aft.
 19 x 2 $\frac{.61}{62}$ 2.93

Fore castle
 Reass $\frac{6 \times 4}{29.76}$ 87.83
 87.02 equs

Builder's name and yard number *Workman Clark & Co. Ltd. N° 325.*

Names of sister ships

Owners *Royal Mail Steam Packet Co.*

Fee £ *17* : - : -

Received by me