


SCALE $\frac{1}{2}'' = 1 \text{ foot}$

DIMENSIONS.	
LENGTH BP	168' 0"
BREADTH M ^{LD}	27' 6"
DEPTH	13' 4"
DEPTH (d) Lloyds	14' 10"
	M.D 10' 10"

DEPTH	13.33	SMALL NO
40.88	168	
6859.44	LONGITUDE NO	
RD QR DECK 62.33 - 4	249.32	
I.G. FORECASTLE 25.5 - 7 - 75	133.87	
BRIDGE HOUSE 9.16 - 8 - 75	54.96	
CASINGS 44 - 7 - 5	154.00	
7451.59	EQUIPMENT	

QR DECK NOS
27 5
17 33
44 83
168
753144

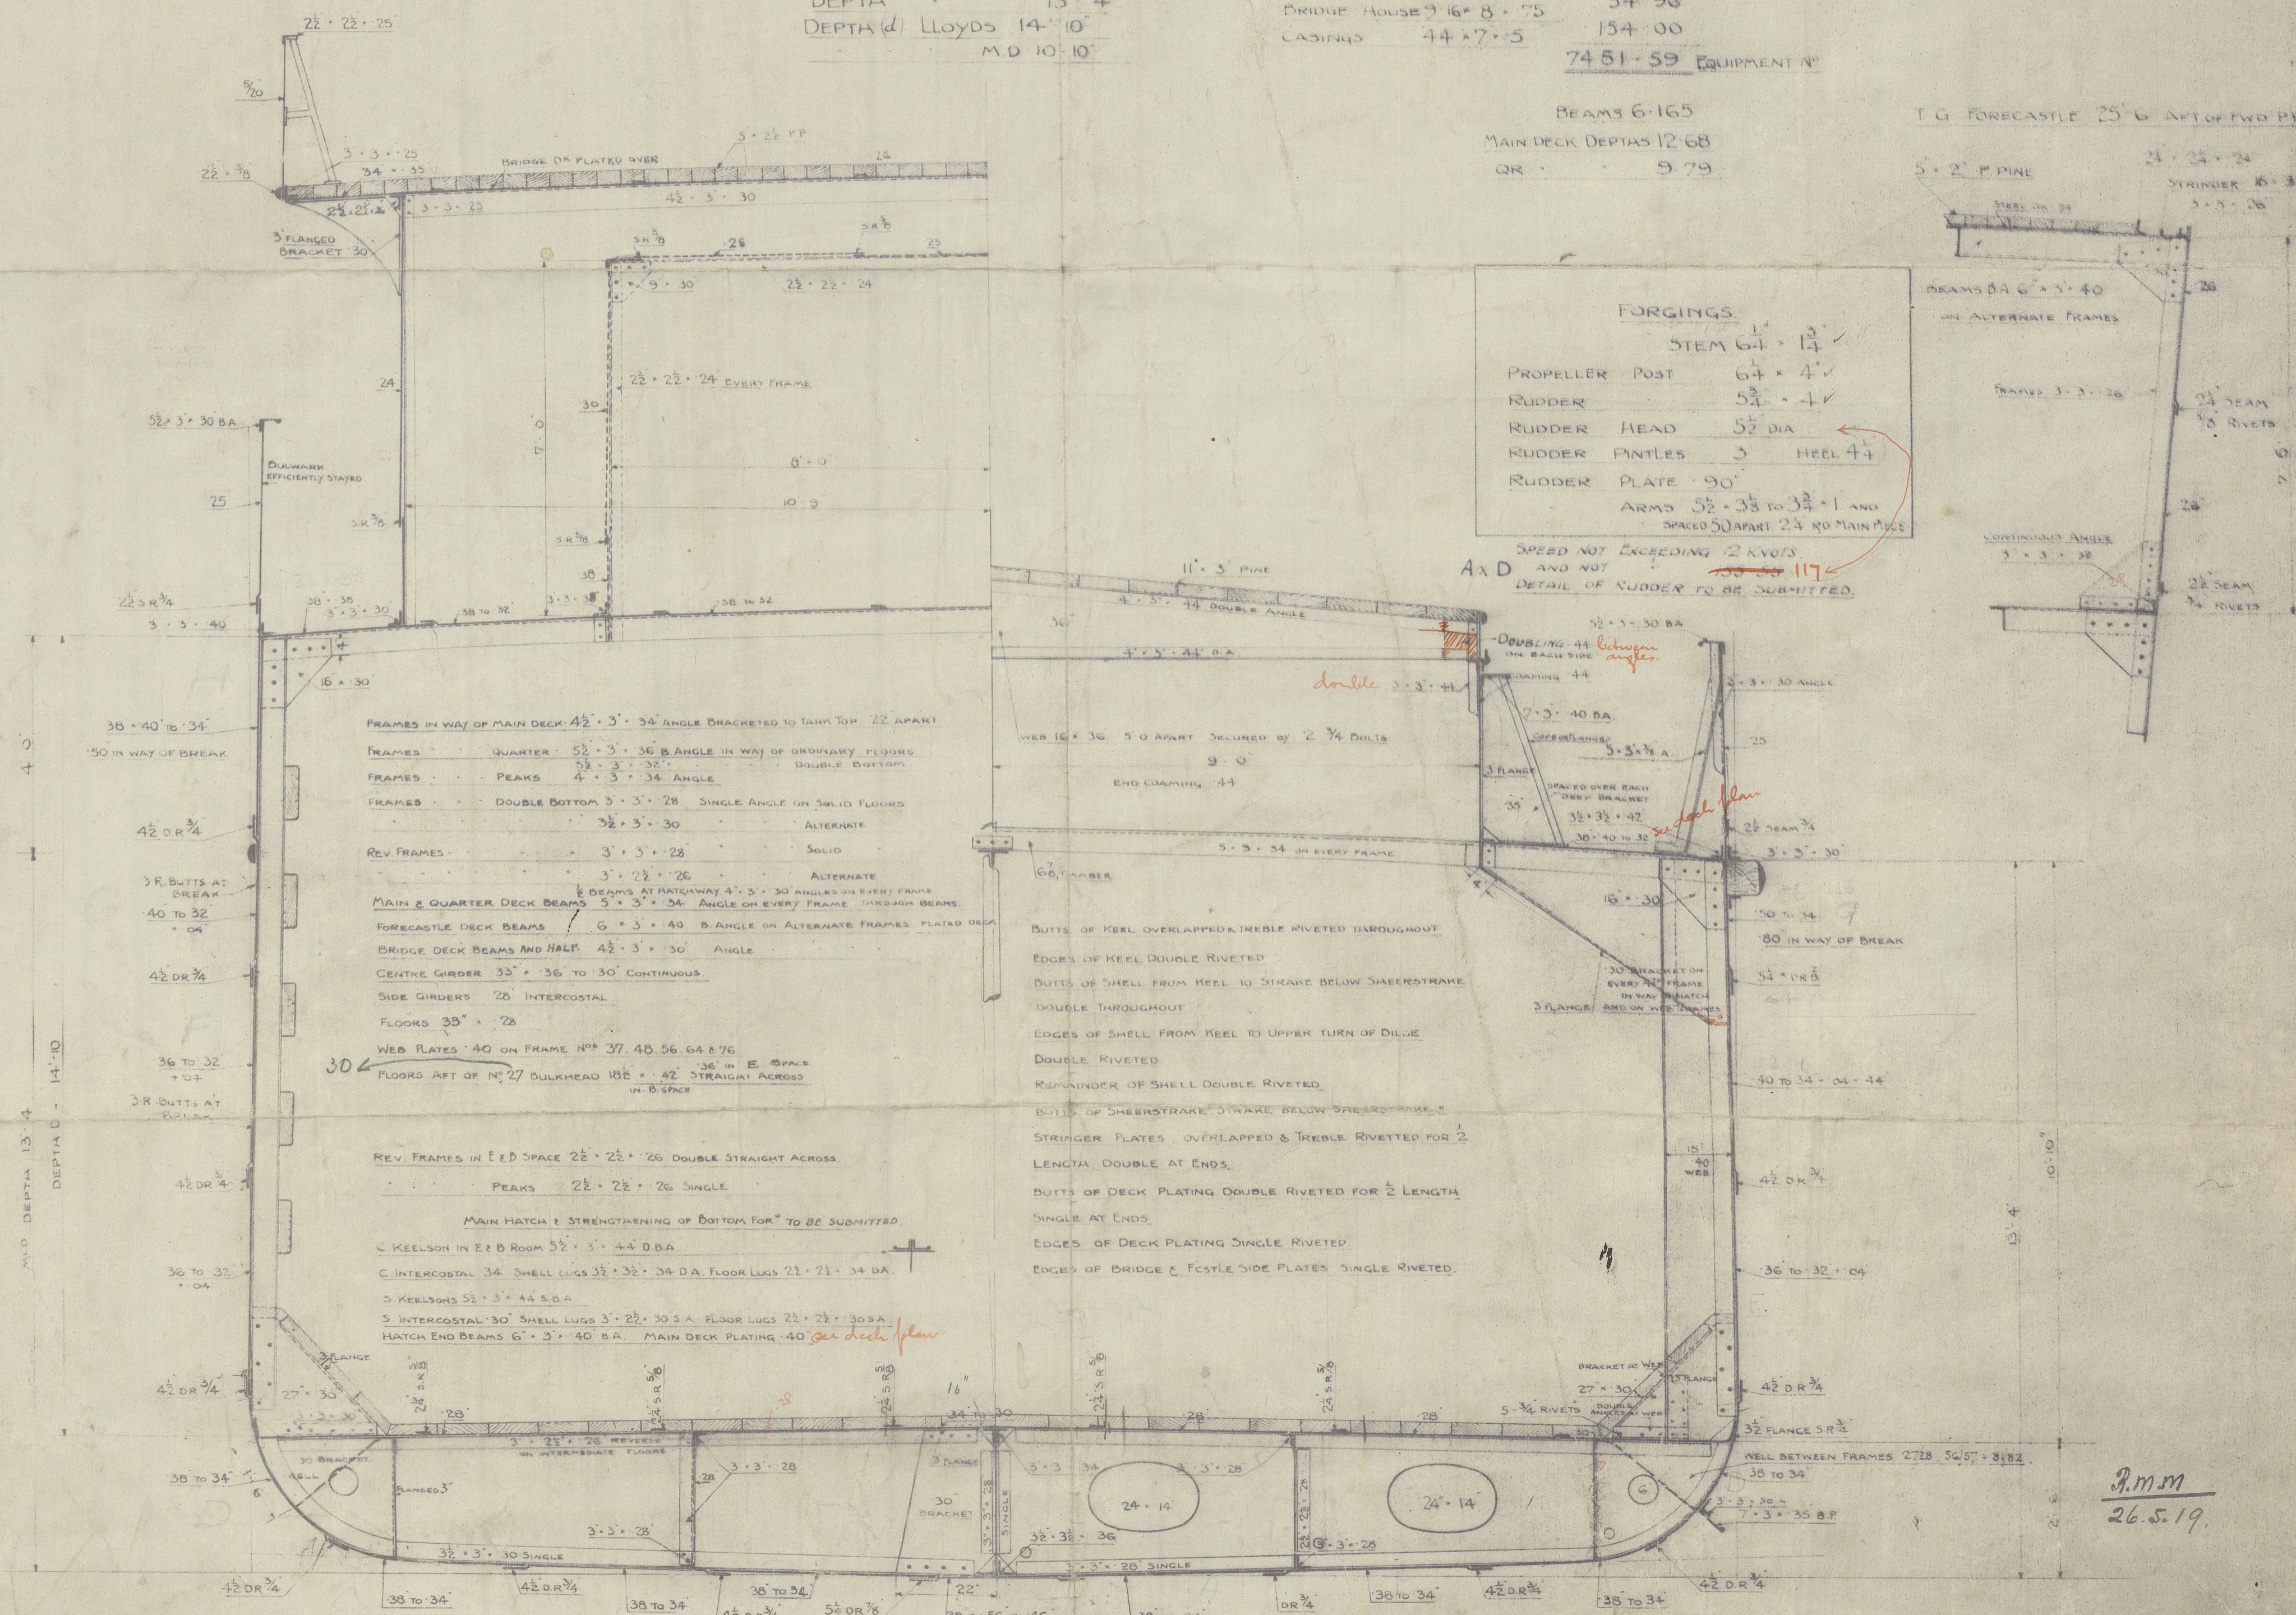

JOHN CHAMBERS LTD.
SHIPBUILDERS AND ENGINEERS,
OULTON BROAD, LOWESTOFT.


Chambers Ltd

S.S. 512

Mudship Section

S.S. "WYNSTONE"

RETAIN

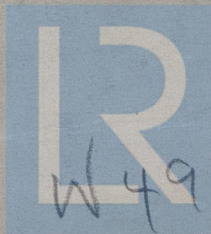

© 2020

Lloyd's Register
Foundation

Chambers 512

Unmanned mid. section



© 2020

Lloyd's Register
Foundation