

27/3/20
D IN PLACE
AND OR CHIPPED

1	3"	MAIN STOP VALVE
1	3"	SAFETY VALVE SINGLE SPRING
1	1 1/2"	BLOW DOWN COCK
15 SET	5/8"	WATER GAUGES 3/4" GAG ENDS
2		TEST COCKS 3/4" GAG ENDS
1	6" DIA	PRESSURE GAUGE GRADUATED TO 175
1	1"	FEED CHECK VALVE FOR DONKEY.
1	1"	INJECTOR & THE NECESSARY VALVES


2 FIRING TOOLS COMPRISING SHOVEL SLICE & RAKE. PRICKER
To BE SUPPLIED

STEAM PIPE - $\frac{3}{8}$ " O/A. EXHAUST PIPE - $\frac{1}{2}$ " O/A.
WATER PIPE - 1" O/A.

5'-6" x 10'-0" VERT BOILER

TO LLOYD'S TESTS & REQUIREMENTS
SCALE 1" = ONE FOOT.

SEPT 14 1919

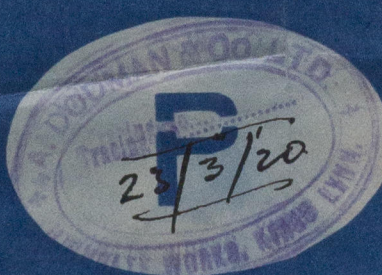

Dodman

Boiler

1134

F+G.

2 off.

5'-6" x 10'-0"

Dodman B
1134

RETAIN

W 491 - 0116



© 2020

Lloyd's Register
Foundation