

22.412

MIDSHIP SECTION

STEEL CREW TRAWLER


N^o 540

DIM^s 135'-0" x 3'-6" EX x 13'-3" M^{LD}

SCALE: INCH = 1 FOOT.

PLAN No. 1418
FOR ENCLOSURE TO
Messrs. Lloyd's Register
Hull FROM
COCHRANE & SONS
SHIPBUILDERS, BELLY
DATE 19/4/12. RR

TO CLASS 100 A.I. LLOYDS FOR FISHING
PURPOSES. ENGINE BOILER CASING AS
PREVIOUSLY. DECKED OVER IN WAY OF
MACHINERY SPACE

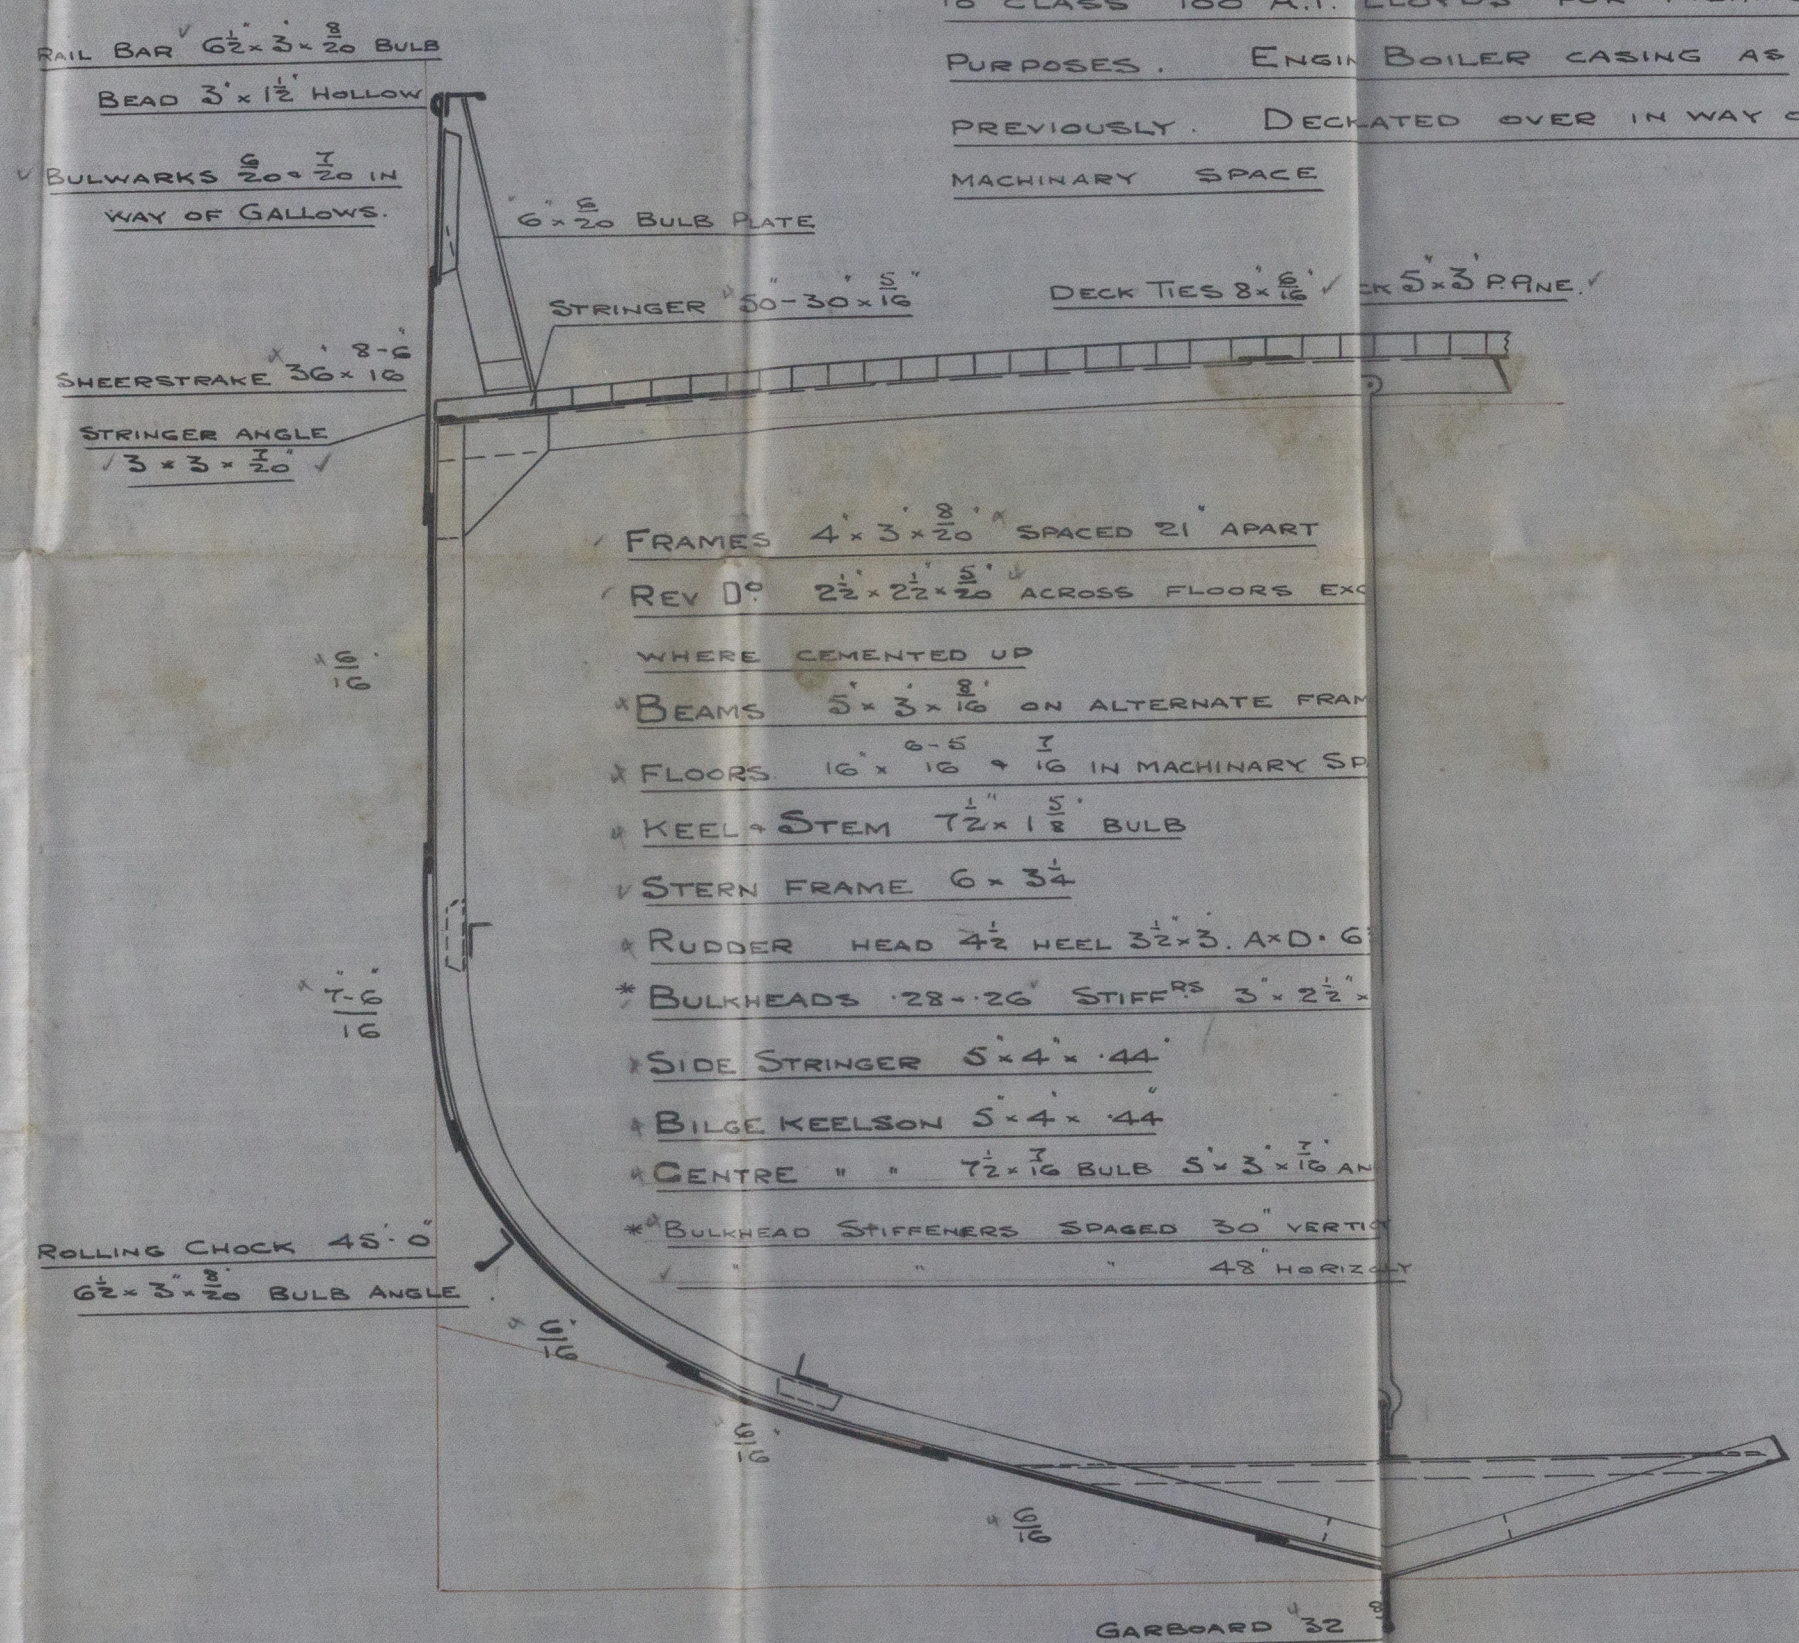

NUMERALS

D + B = 36.61

L x (D + B) = 4942.35

PROPORTIONS

L / B = 5.78

L / D = 10.19

EQUIPMENT

NET	BOWER ANCHOR	7 1/2 CWT ^s STOCKLESS
AND	"	7 " "
AND	"	3 " EX STOCK
AND	FATHOMS	1 1/2 CABLE
AND	"	6 HAWSER
AND	"	5 WARP

RIVETING

- * BUS OF SHELL PLATING LAPPED & DOUBLE
- * RIVET EXCEPT GARBOARD & SHEERSTRAKE
- * WH ARE TO BE STRAPPED, & DOUBLE
- * RIVET. LANDINGS DOUBLE RIVETED
- * BWARKS SINGLE RIVETED.

acw.
20.4.12

LLOYD'S REGISTER
OF SHIPPING
20 APR 12

© 2020

Lloyd's Register

W493-0276

Cochrane & Sons.

No 540.

Midship Section

Duplicate of 515/516

1/2 Inverfur Connexion.

Hull Rpt No: 25544

BILLETING

W493-0276

BOWER ANCHOR

EQUIPMENT



© 2020

Lloyd's Register
Foundation