

PROFILE & DECK PLAN


STEEL SCREW TRAWLER

No 540


DIMS 135'-0" x 23'-6" EX x 13'-3" DEPTH M^{LO}

SCALE $\frac{1}{4}$ " = ONE FOOT.

PLAN No. 14-14
FOR ENCLOSURE TO
Messrs Lloyd's Surveyors
Hull
FROM
COCHRANE & SONS,
SHIPBUILDERS, SHELBY
19/4/12. RK

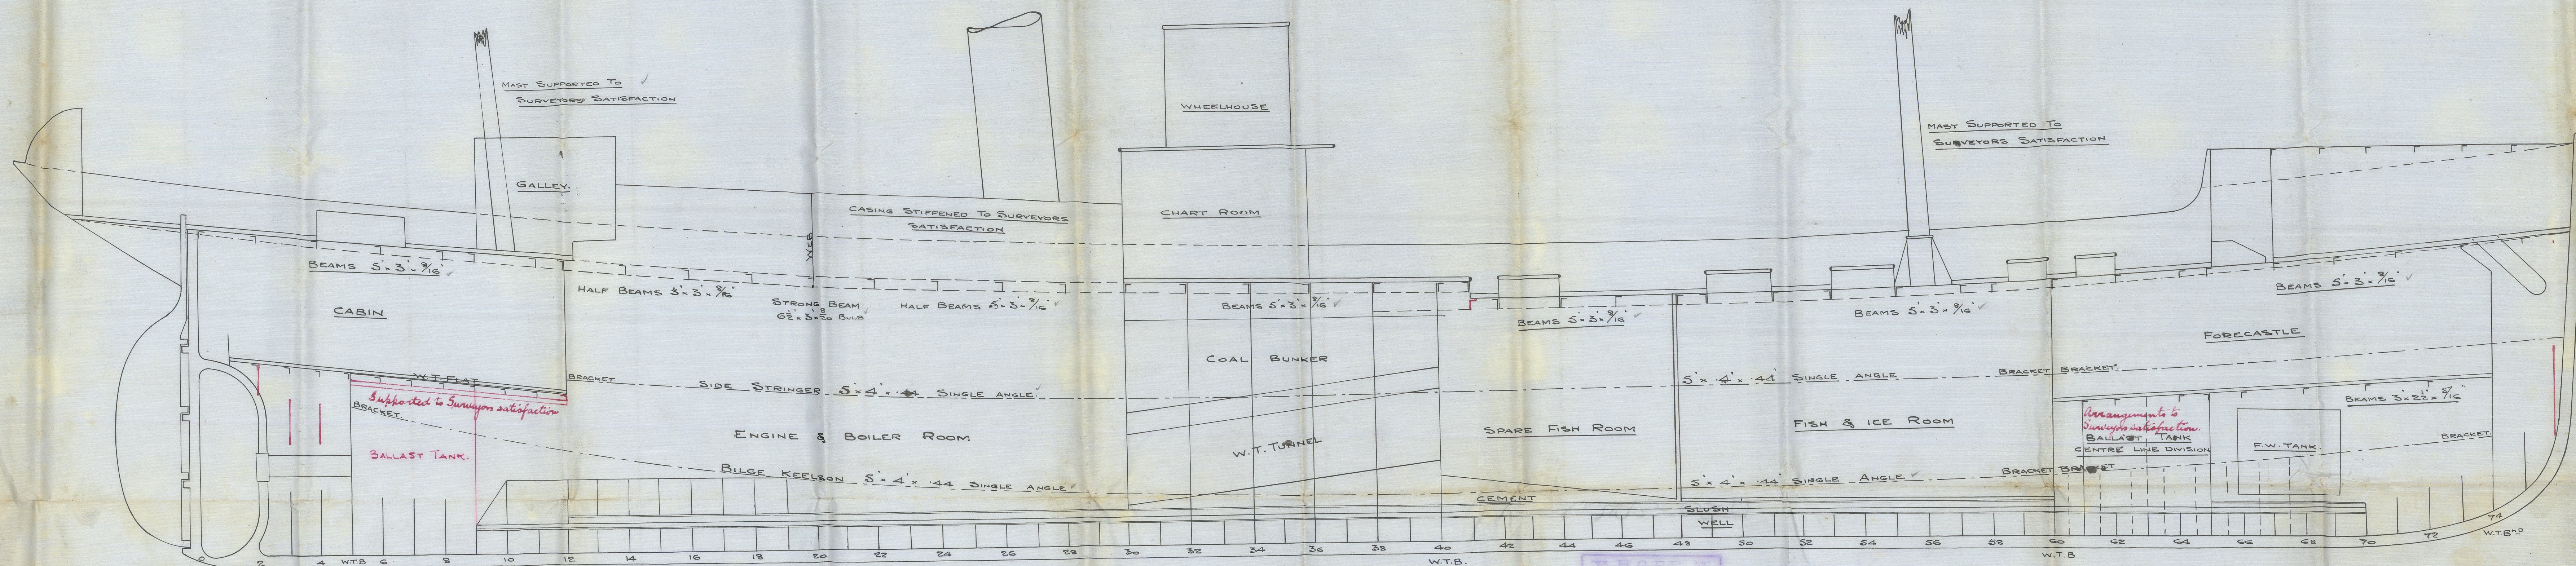

PILLARS TO SURVEYORS SATISFACTION

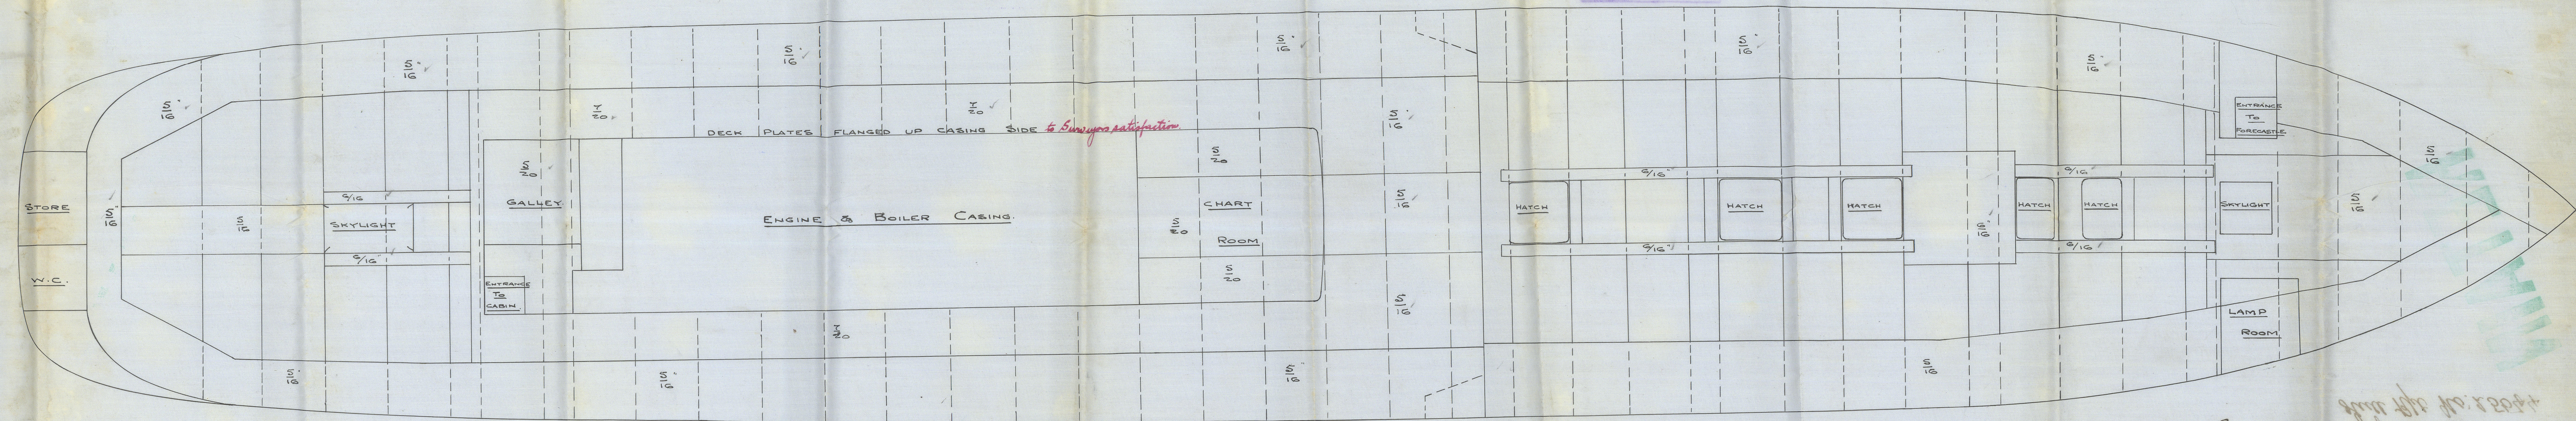

C.B.
22. 4. 12

20-4-12

Cochran & Sons

No. 540.

Profile & Deck
duplicate of 515/516.

L. Ingolfur Alonsson.

Shell Rpt No. 25574

W493-0277



© 2020

Lloyd's Register
Foundation

LLOYD'S REGISTER
OF SHIPPING.
20 APR. 1912
HULL



© 2020

Lloyd's Register
Foundation

W493-0277