



- NORTHUMBERLAND ENGINE WORKS. -

- TRACING 375 -


- SCHEDULE L -

- STEAM BOILER. -


- SCALE 1 INCH = ONE FOOT. -

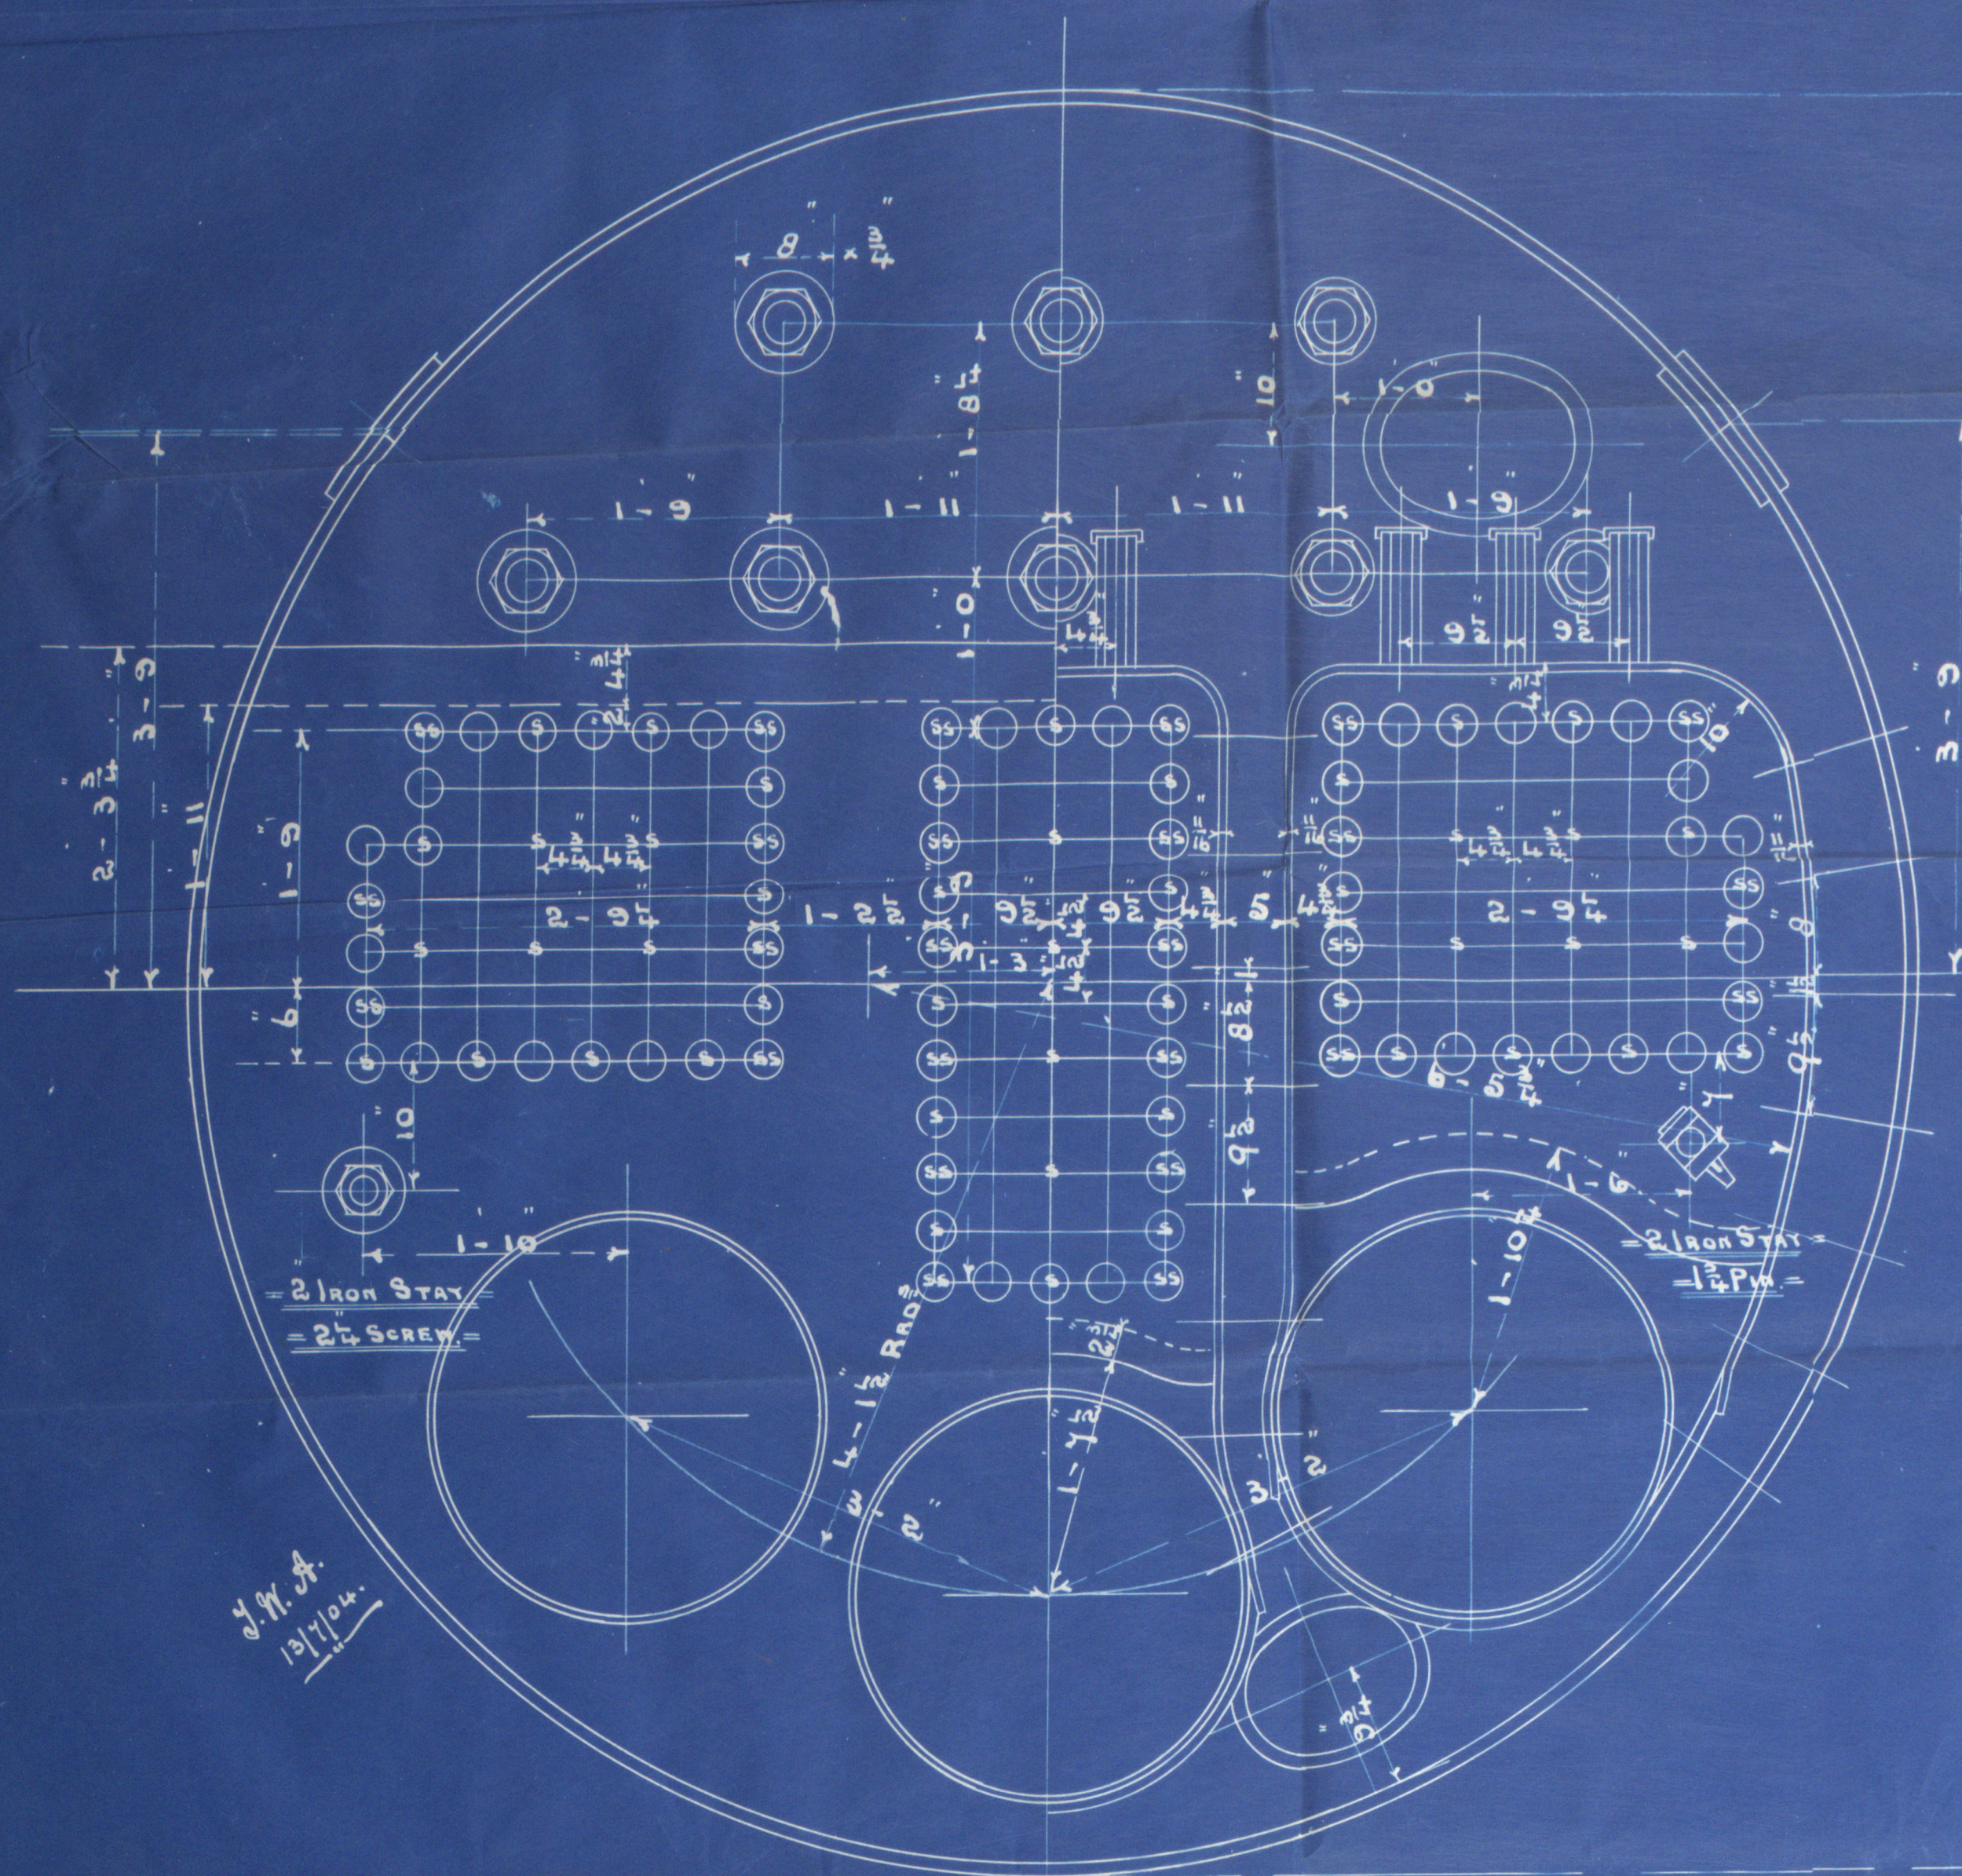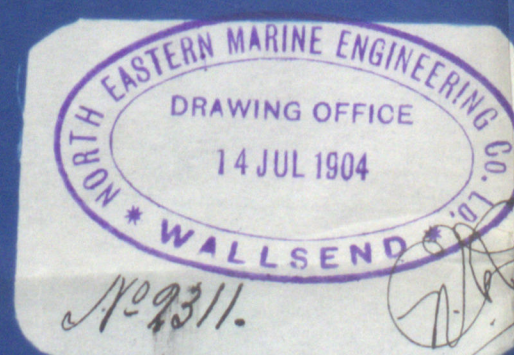

12-0 EXT. DIA.

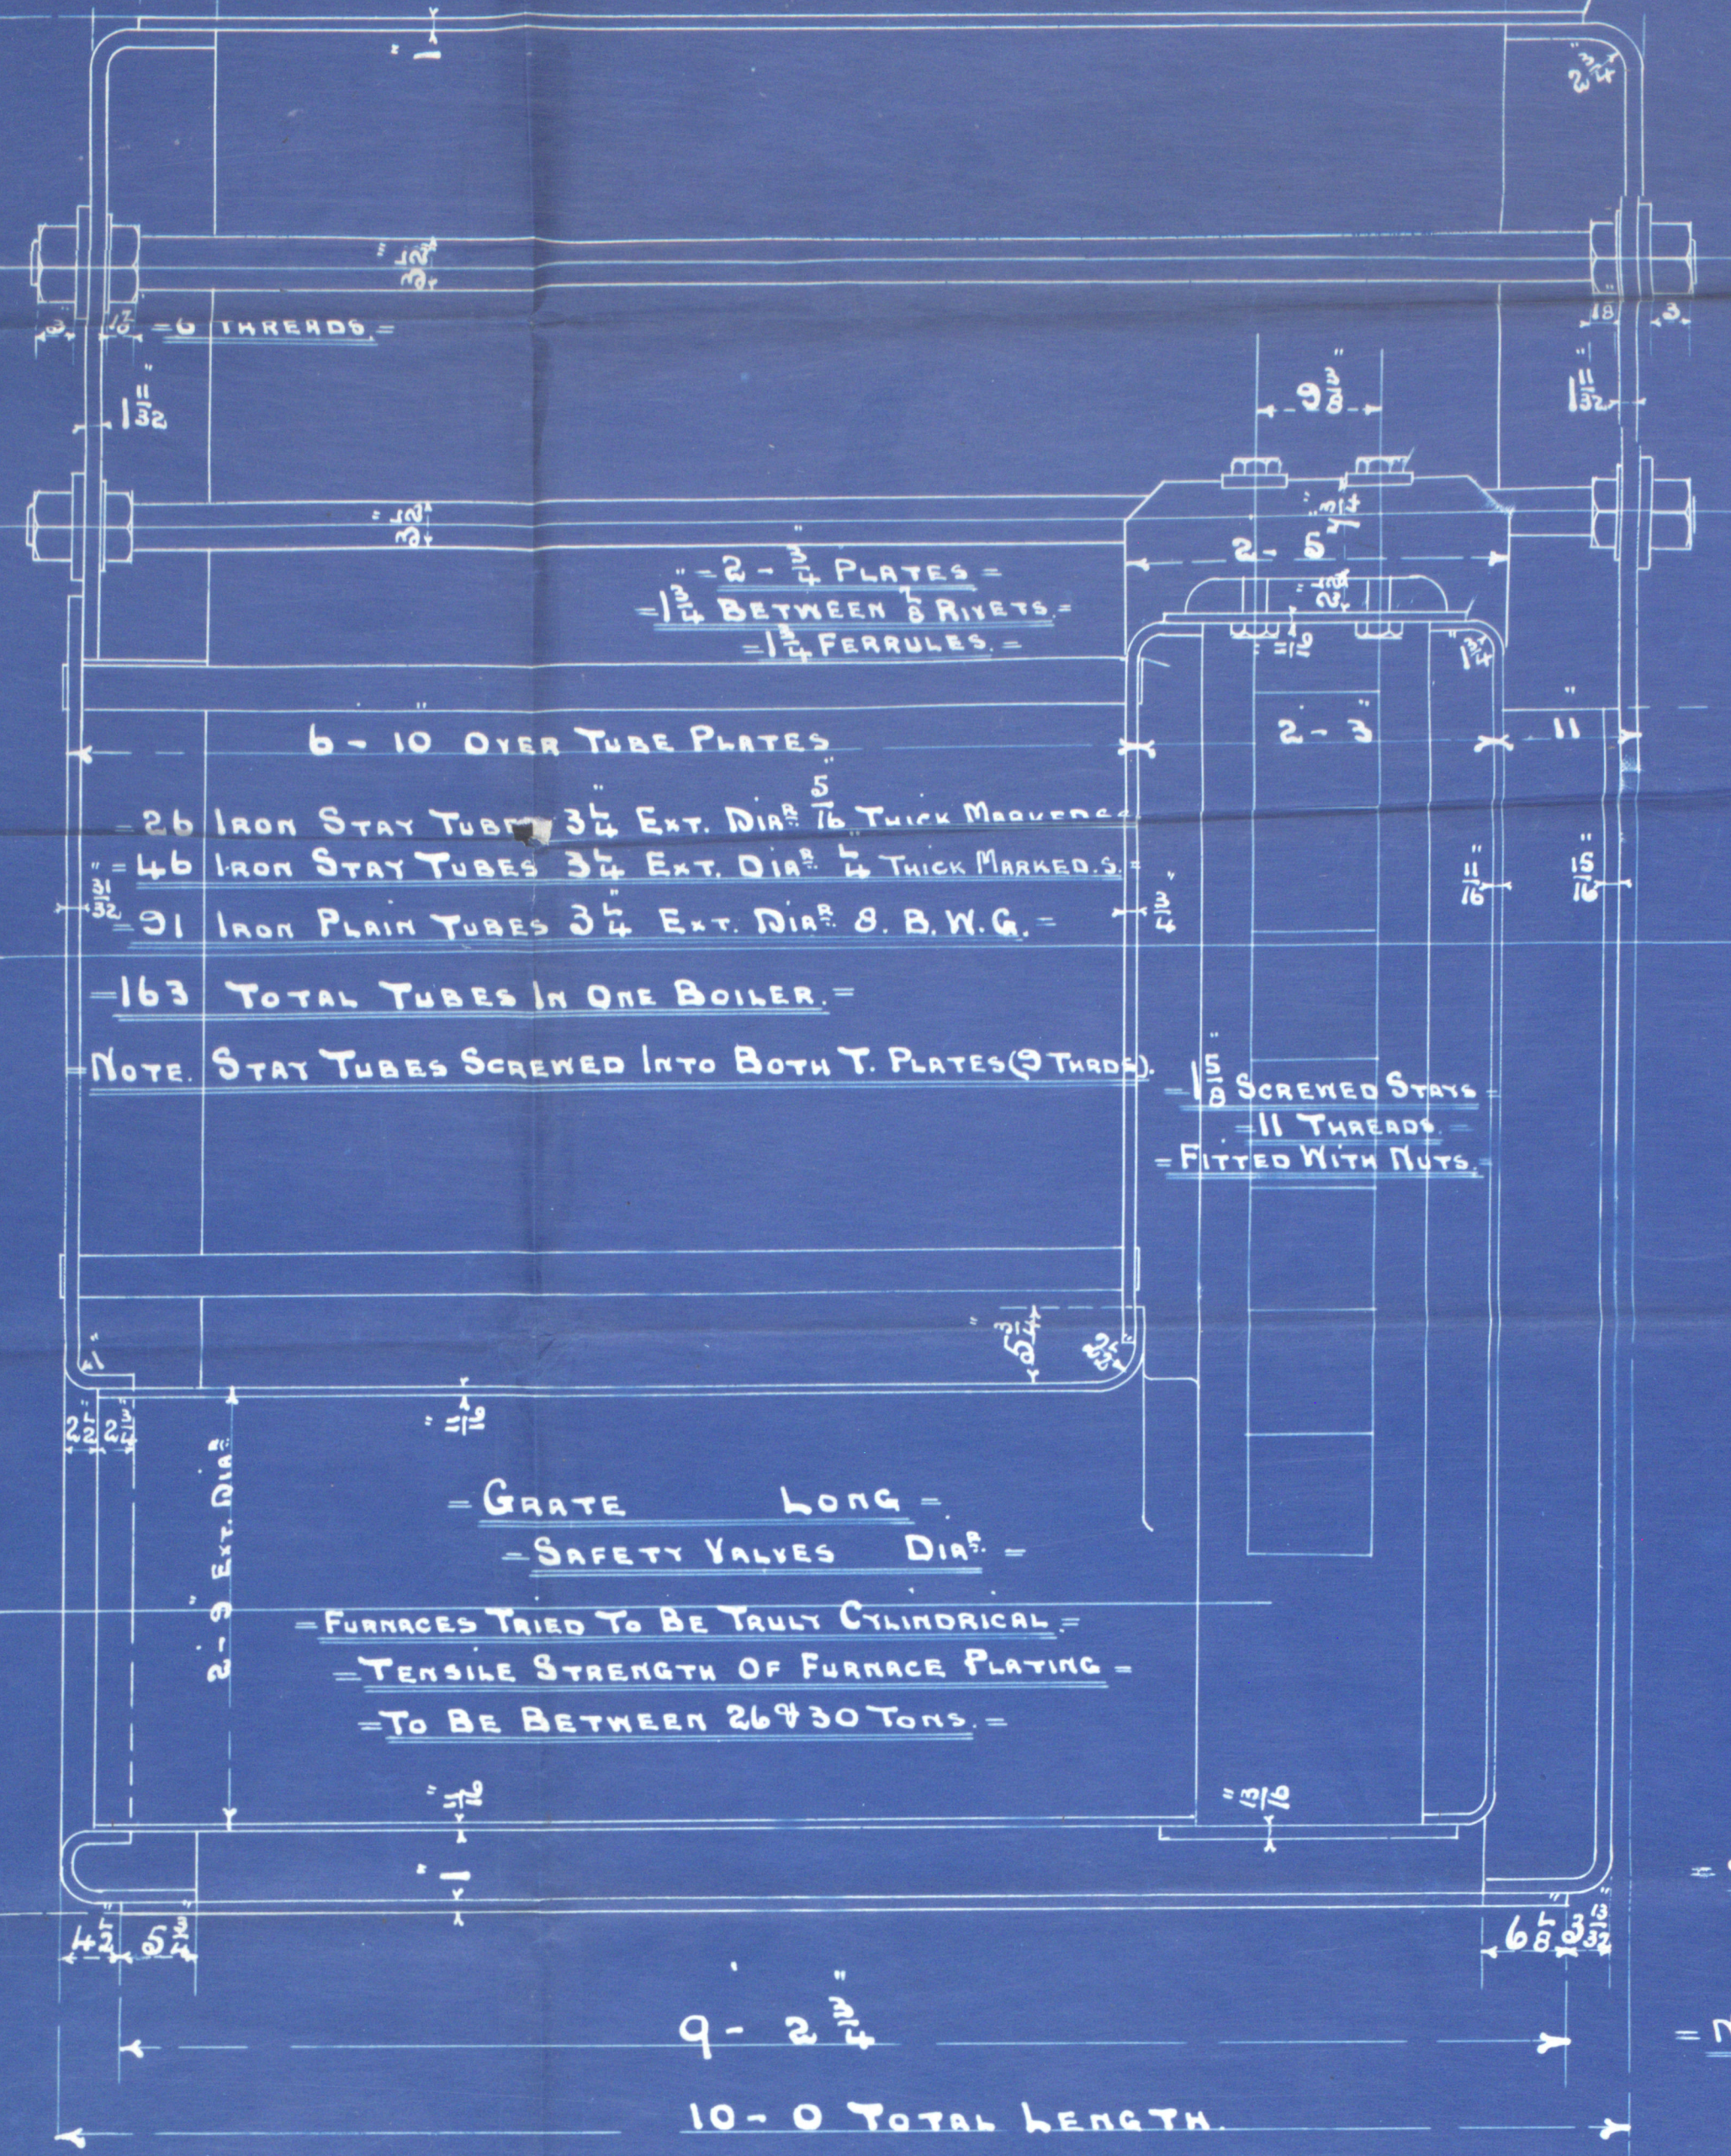

= WORKING PRESSURE = 180 LBS. =
= TEST PRESSURE = 360 =
= NOTE. ALL PLATES STAYS & TO BE OF STEEL EXCEPT WHERE OTHERWISE SHOWN. =
= TENSILE STRENGTH OF SHELL PLATING TO BE NOT LESS THAN 29 TONS. PER SQ. INCH. =

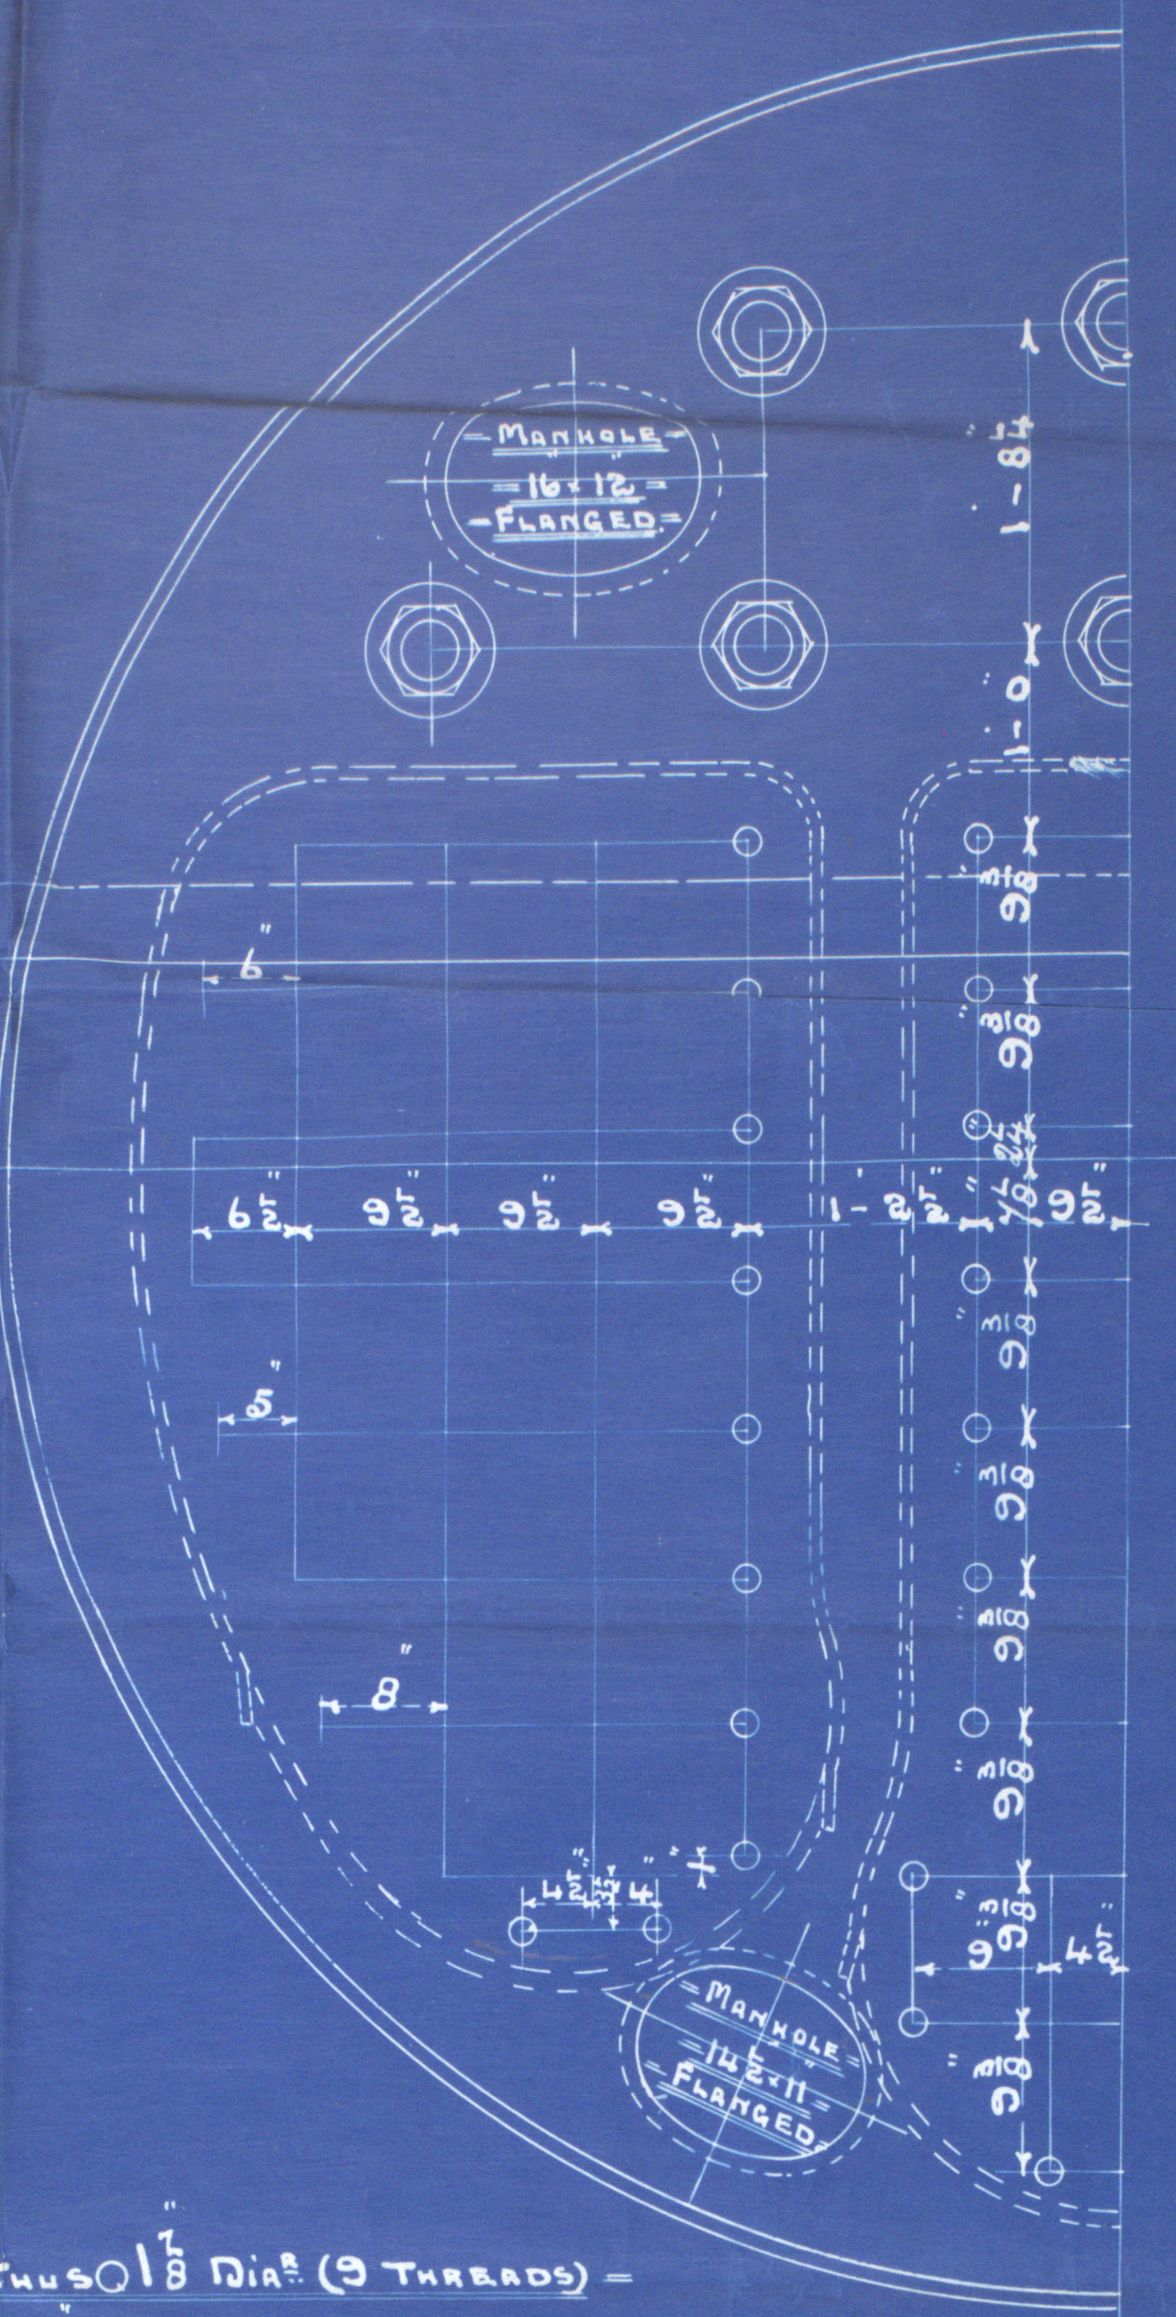

= STAYS MARKED THUS 1 1/8\"/>

= 1. THUS. = CONTRACT 1596. =

© 2020

N. E. M. E. CO., LIMITED, WALLSEND.

ENCLOSURE

FOR

Messrs.

Lloyd's Register
Foundation

W494-0251

42

Wood. Skimmers

N^o 124

H. E. King Col^d

N^o 1596

180 to.


(24)

Test.

N^o.

360

12/11/04

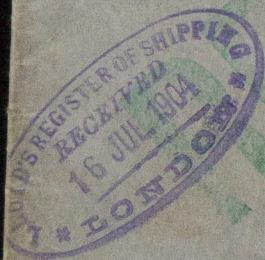

8/5

Arrival

S. P. Arrival

Newcastle Report

N^o 48050

© 2020



W494 Lloyd's Register Foundation