

Verification

EXT

Rot.
13/9/32

20 FEB 1928

Index No.

(For London Office only.)

Lloyd's Register of Shipping.

SURVEYS FOR FREEBOARD. STEAM SHIPS.

N^o 29642

PARTICULARS RELATING TO ALL STEAM SHIPS EITHER FLUSH DECKED, OR WITH TOP GALLANT FORECASTLES, SHORT POOPS AND BRIDGE HOUSES DISCONNECTED, OR WITH TOP GALLANT FORECASTLES HAVING LONG POOPS, OR RAISED QUARTER DECKS CONNECTED WITH BRIDGE HOUSES, OR OTHERWISE.

Port of Survey Sunderland
Date of Survey Feb'y 18th 1928
Name of Surveyor W. P. Bollings

Ship's Name. FORTHBRIDGE Port of Registry and Nationality. W. Hartlepool British Official Number. 4772 Gross Tonnage. 1928 Date of Build. 1928 Particulars of Classification. 100A1. (Contemplated)

Registered dimensions from

LENGTH.	BREADTH.	DEPTH.	UNDER DECK TONNAGE.
390.0	54.8	27.75	4772
390.0	average Frame Depth $\frac{1}{4}$ Ceiling + 20. Rule "6" Sheer + 94. = $2 \times 8\frac{1}{2} = -1.33.42$ spar ceiling fitted.	28.89	4772

Moulded Depth as measured..... 30'-2"
Addition for Keel below base line for draught record..... $2\frac{1}{4}$ inches.

NOTE. - If the depth is measured when vessel is afloat, the details of measurement should be reported.

Thickness..... 468.793
on necessary 22 CORB
to (e)*
corrected..... 468.793

CORRECTION FOR LENGTH.

Length of Ship on Loadline.....	390.0
Length in Table	362.0
Difference	28.0
Correction for 10ft., Table A.	1.5
× Difference divided by 10	4.20
If $\frac{1}{10}$ ths length covered divide by 2	2.1
	+2.1

CORRECTION FOR IRON DECK.

Proportion covered, if less than $\frac{1}{10}$ ths length covered 80596
Thickness of usual wood deck, less stringer $3\frac{1}{2}$
- $3\frac{1}{2}$

CORRECTION FOR ROUND OF BEAM.

Breadth at Gunwale amidships..... 54.54
Round of Beam 13.6
Normal round..... $13\frac{1}{2}.63$
Difference $\div 2 =$
Proportion of Deck uncovered (Para. 19)

NOTE. - The round of beam should be reported on the full breadth of vessel at the gunwale.

At front of bridge house.....
At after end of forecastle

÷ 2 =

Correction

Freeboard, Table A $7'' 7\frac{1}{2}''$
Correction for Sheer $- 8\frac{1}{2}''$
Correction for Length $+ 2''$
Allowance for Deck Erections $- 1 - 5\frac{3}{4}''$
Correction for Round of Beam..... $5'' 7\frac{1}{4}''$
Correction for fall in Sheer (if any).....
Correction for Steel Deck (if required) $- 3\frac{1}{2}''$
Additions for non-compliance with provisions of Para. 11 (d) and (e) $\frac{1}{2}$
Other Corrections (if any)

ALLOWANCE FOR DECK ERECTIONS:-

C..... $4'' 5\frac{1}{2}''$
Length, if required (Para. 12, 13, and 14)

Table A, corrected for sheer, and for length, required (Para. 12, 13, and 14) $6'' 11''$
W..... $4 - 5\frac{1}{2}''$ $2 - 5\frac{1}{2}''$
 $60.59 \times 29.5 = \frac{41.73}{100} = 11.87$
 $41.73 - 10\frac{1}{4} = 31.33$
Q. Dk. if engine and boiler openings not in bridge house (Para. 11)
Erections $- 17\frac{3}{4}''$

Winter Freeboard $5'' 3\frac{3}{4}''$
Summer Freeboard $4'' 10''$
Indian Summer Freeboard $4'' 5\frac{1}{4}''$
N.A. Winter Freeboard

Length, Length allowed, Height.

27' 9 $\frac{1}{2}$	27' 79	7'-6
254-1	254.08	7'-6
32.5/2	32.46	7'-6
	314.33	8059
	390.00	

Correction necessary because clearside amidships, measured in accordance with the Statute is not taken at the intersection of the wood or steel deck with side. $+ 13\frac{1}{4}''$

Recommended amidships from centre of Disc to top of Statutory Deck Line, Wood (Steel) Deck:-

Fresh Water Line	above centre of Disc	...
Indian Summer Line	"	...
Winter Line	below	...
Winter North Atlantic Line	"	...

Winter Freeboard from deck line $5'' 5\frac{1}{2}''$
Summer " " " $4'' 11\frac{3}{4}''$
Indian Summer " " " $4'' 6''$
N.A. Winter " " " $4'' 11\frac{1}{2}''$

© If the frames, skin planking, or ceiling are of unusual thickness the breadth of vessel to inside of ceiling should be reported if possible.
† In vessels obtaining an allowance for deck erections under Para. 11 where the sheer drops abaft amidships the height of the R.Q.D. is to be taken from the level of the top of the amidships beam.
§ In flush-decked vessels the total standard mean sheer means the sheer measured at the stem and sternpost. In vessels having poops and forecastles, it means the sheer measured at points distant one-eighth of the vessel's length from stem and sternpost.

State dimensions of freeing port area on back of this form.
The Surveyor should state whether the fall in sheer as reported is measured relatively to height of line of keel or to the water line. If measured relatively to water line the vessel's draught of survey, and also the usual load draft forward and aft should be reported.

RECEIVED 2 MAR 1928 W. = 12190
40X436 = 699

Foundation

Do all the Frames extend to the top height in the Poop? *yes* Raised Quarter Deck? *yes* Bridge House? *alt yes* Forecastle? *yes*
 To what height do the Reverse Frames extend? *Channel bulk angle framing*
 Has the Poop or Raised Quarter Deck an efficient Iron Bulkhead at the fore end? *yes*
 Give particulars of the means for closing the openings in Bulkhead *2 openings, closed with steel hinged plate door*
 Is the Poop or Raised Quarter Deck connected with the Bridge House? *no* Has the Bridge House an efficient Bulkhead at the fore end? *y*
 Give particulars of the means for closing the openings in Bulkhead *no openings*
 What is the thickness of the Bridge Front plating? *40* and Coaming plate? *44*
 Give scantlings and spacing of the Stiffeners *9 x 3 1/2 x 50 Bds. @ 30" spacing*
 Are bracket plates fitted at each end of the Stiffeners? *yes* Are hor'l. brackets fitted connecting Bridge Bulk'd. with Bulwarks? *Rail b up sweep of bulwark Bridge sheer*
 Has the Bridge House an efficient Iron Bulkhead at the after end? *yes*
 How are the openings closed? *Storm boards full height in riveted channels*
 Is the Forecastle at least as high as the main or top-gallant rail? *yes* Has the Forecastle an efficient Iron or Wood Bulk'd. at after end? *y*
 Are the Engine and Boiler openings covered by a Bridge, Poop, Raised Quarter Deck, or enclosed by a Strong Iron or Steel Deckhouse? *Covered by a bridge casing*
 If the openings are not so protected are the exposed parts of the Casings efficiently constructed? *yes*
 Give thickness of plating; scantlings and spacing of Stiffeners
 What is the height of the exposed Casings? Are suitable means provided for closing all openings in them in bad weather? *yes*
 Are the Weather Deck Hatchways efficiently constructed and at least equal to the requirements of Section 28 of the Rules for 1904-5? Give particulars below: *yes*


Position and Size.	No 1 - 29'3" x 20'0"		No 2 - 30'4" x 20'0"		No 3 - 16'4" x 18'0"		No 4 - 30'4" x 20'0"		No 5 - 30'4" x 20'0"	
Item.	Ship.	Rule.	Ship.	Rule.	Ship.	Rule.	Ship.	Rule.	Ship.	Rule.
COAMING. Height above top of DECK	4'-0"	as app'd	2'-8"	as app'd	2'-8"	as app'd	2'-8"	as app'd	3'-0"	as app'd
Thickness	Sides	50	50	50	44	50	50	50	50	50
	Ends	44	44	44	44	44	44	44	44	44
SHIFTING BEAMS OR WEB PLATES.	Number	5	5	5	3	5	5	5	5	5
	Section and Scantlings	18 x 36	18 x 36	18 x 36	14 x 34	18 x 36	18 x 36	18 x 36	18 x 36	18 x 36
	Material	4 x 3 x 44	4 x 3 x 44	4 x 3 x 44	4 x 3 x 44	4 x 3 x 44	4 x 3 x 44	4 x 3 x 44	4 x 3 x 44	4 x 3 x 44
* FORE AND AFTERS.	Number									
	Section and Scantlings									
	Material									
HATCHES Thickness	3"	Do	3"	Do	3"	Do	3"	Do	3"	Do
Remarks	Good		Good		Good		Good		Good	

* The depth of Fore and Afters should be stated from the underside of the hatches in all cases.
 (If the sill of the lowest side scuttle will be less than 6 inches above the Indian Summer Load-Line if assigned under the tables, state vertical distance from top of deck at side amidships to lower edge of lowest side scuttle.)

The following information is to be given in all Cases of vessels dealt with under Paras. 11, 12 (under 15 feet Moulded depth) and under Shelter Deck Rules.
 What is the thickness of the Bridge Sheerstrake? Strake between Main and Bridge Sheerstrakes?

Delete the words { The Crew are, are not, berthed in the bridge house.
 that do not apply { The arrangements to enable them to get backwards and forwards from their quarters are, are not satisfactory.

Length of Bulwarks in well *Fore 36'-0" aft 39'-8"*
 Area of Freeing Ports required by Rule 11 (e) each side of vessel = *10.120.57 10.47* Sq. ft.
 Ft. Tenths. Ft. Tenths. No.
Fore well 2.66 x 1.54 x 3 = 10.74
Freeing Ports (each side of vessel) = 10.74 24.24 10.53 Sq. ft.
aft " 2.66 x 1.5 x 3 = 10.53
 Total deficiency or excess = *.64 10.06* Sq. ft.

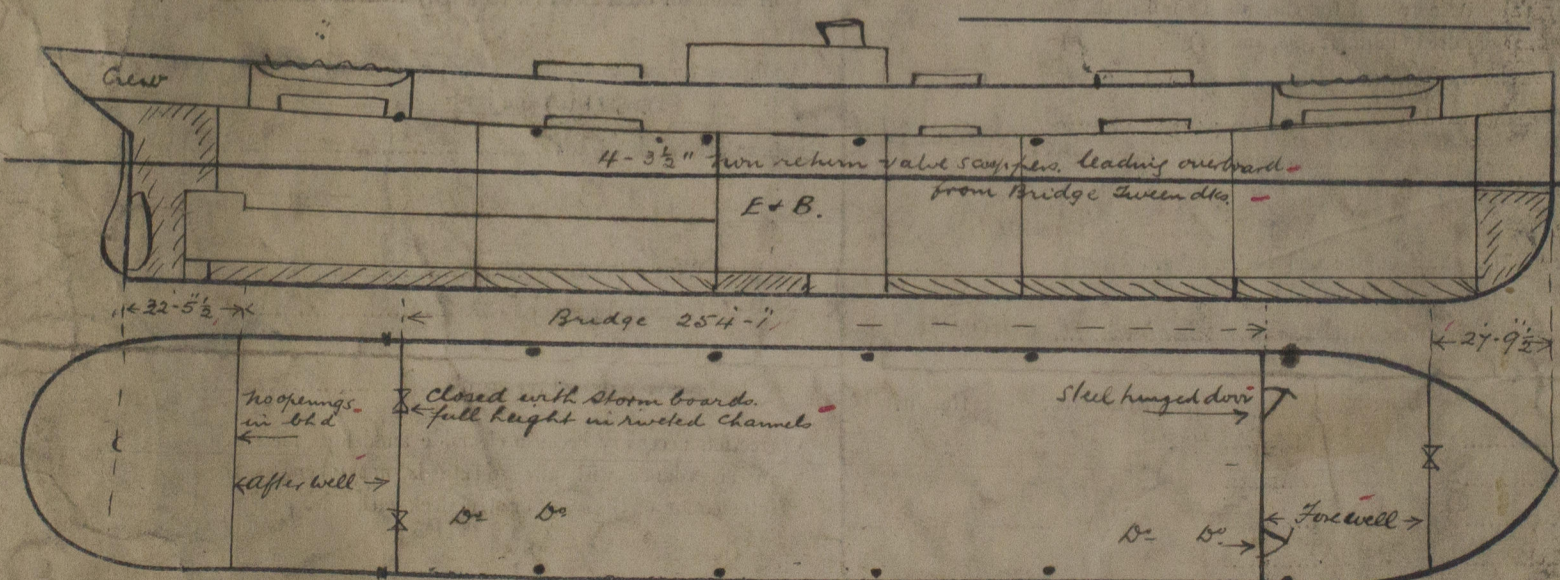

Show hereon line of Floors or Tank Top with position of any Breaks in same; also height of Peak Tank tops, &c., &c.

State any special features in the construction of the Vessel *no special features*
 Builder's name and yard number *Wm Duxford & Sons Ltd. Yard No 587*
 Names of sister vessels
 Owners *Crosby, Mage & Co Ltd*
 Address *West Hartlepool*

Fee £ *10: 1: 8* Received by me *See F.B. Report*
Will be charged on completion

Dispt @ 25'5 1/2 draft 12190 tons
 Cons per inch at loaded 47.6 tons
 draft
 Request form attached
 Lloyd's Register
 Foundation