
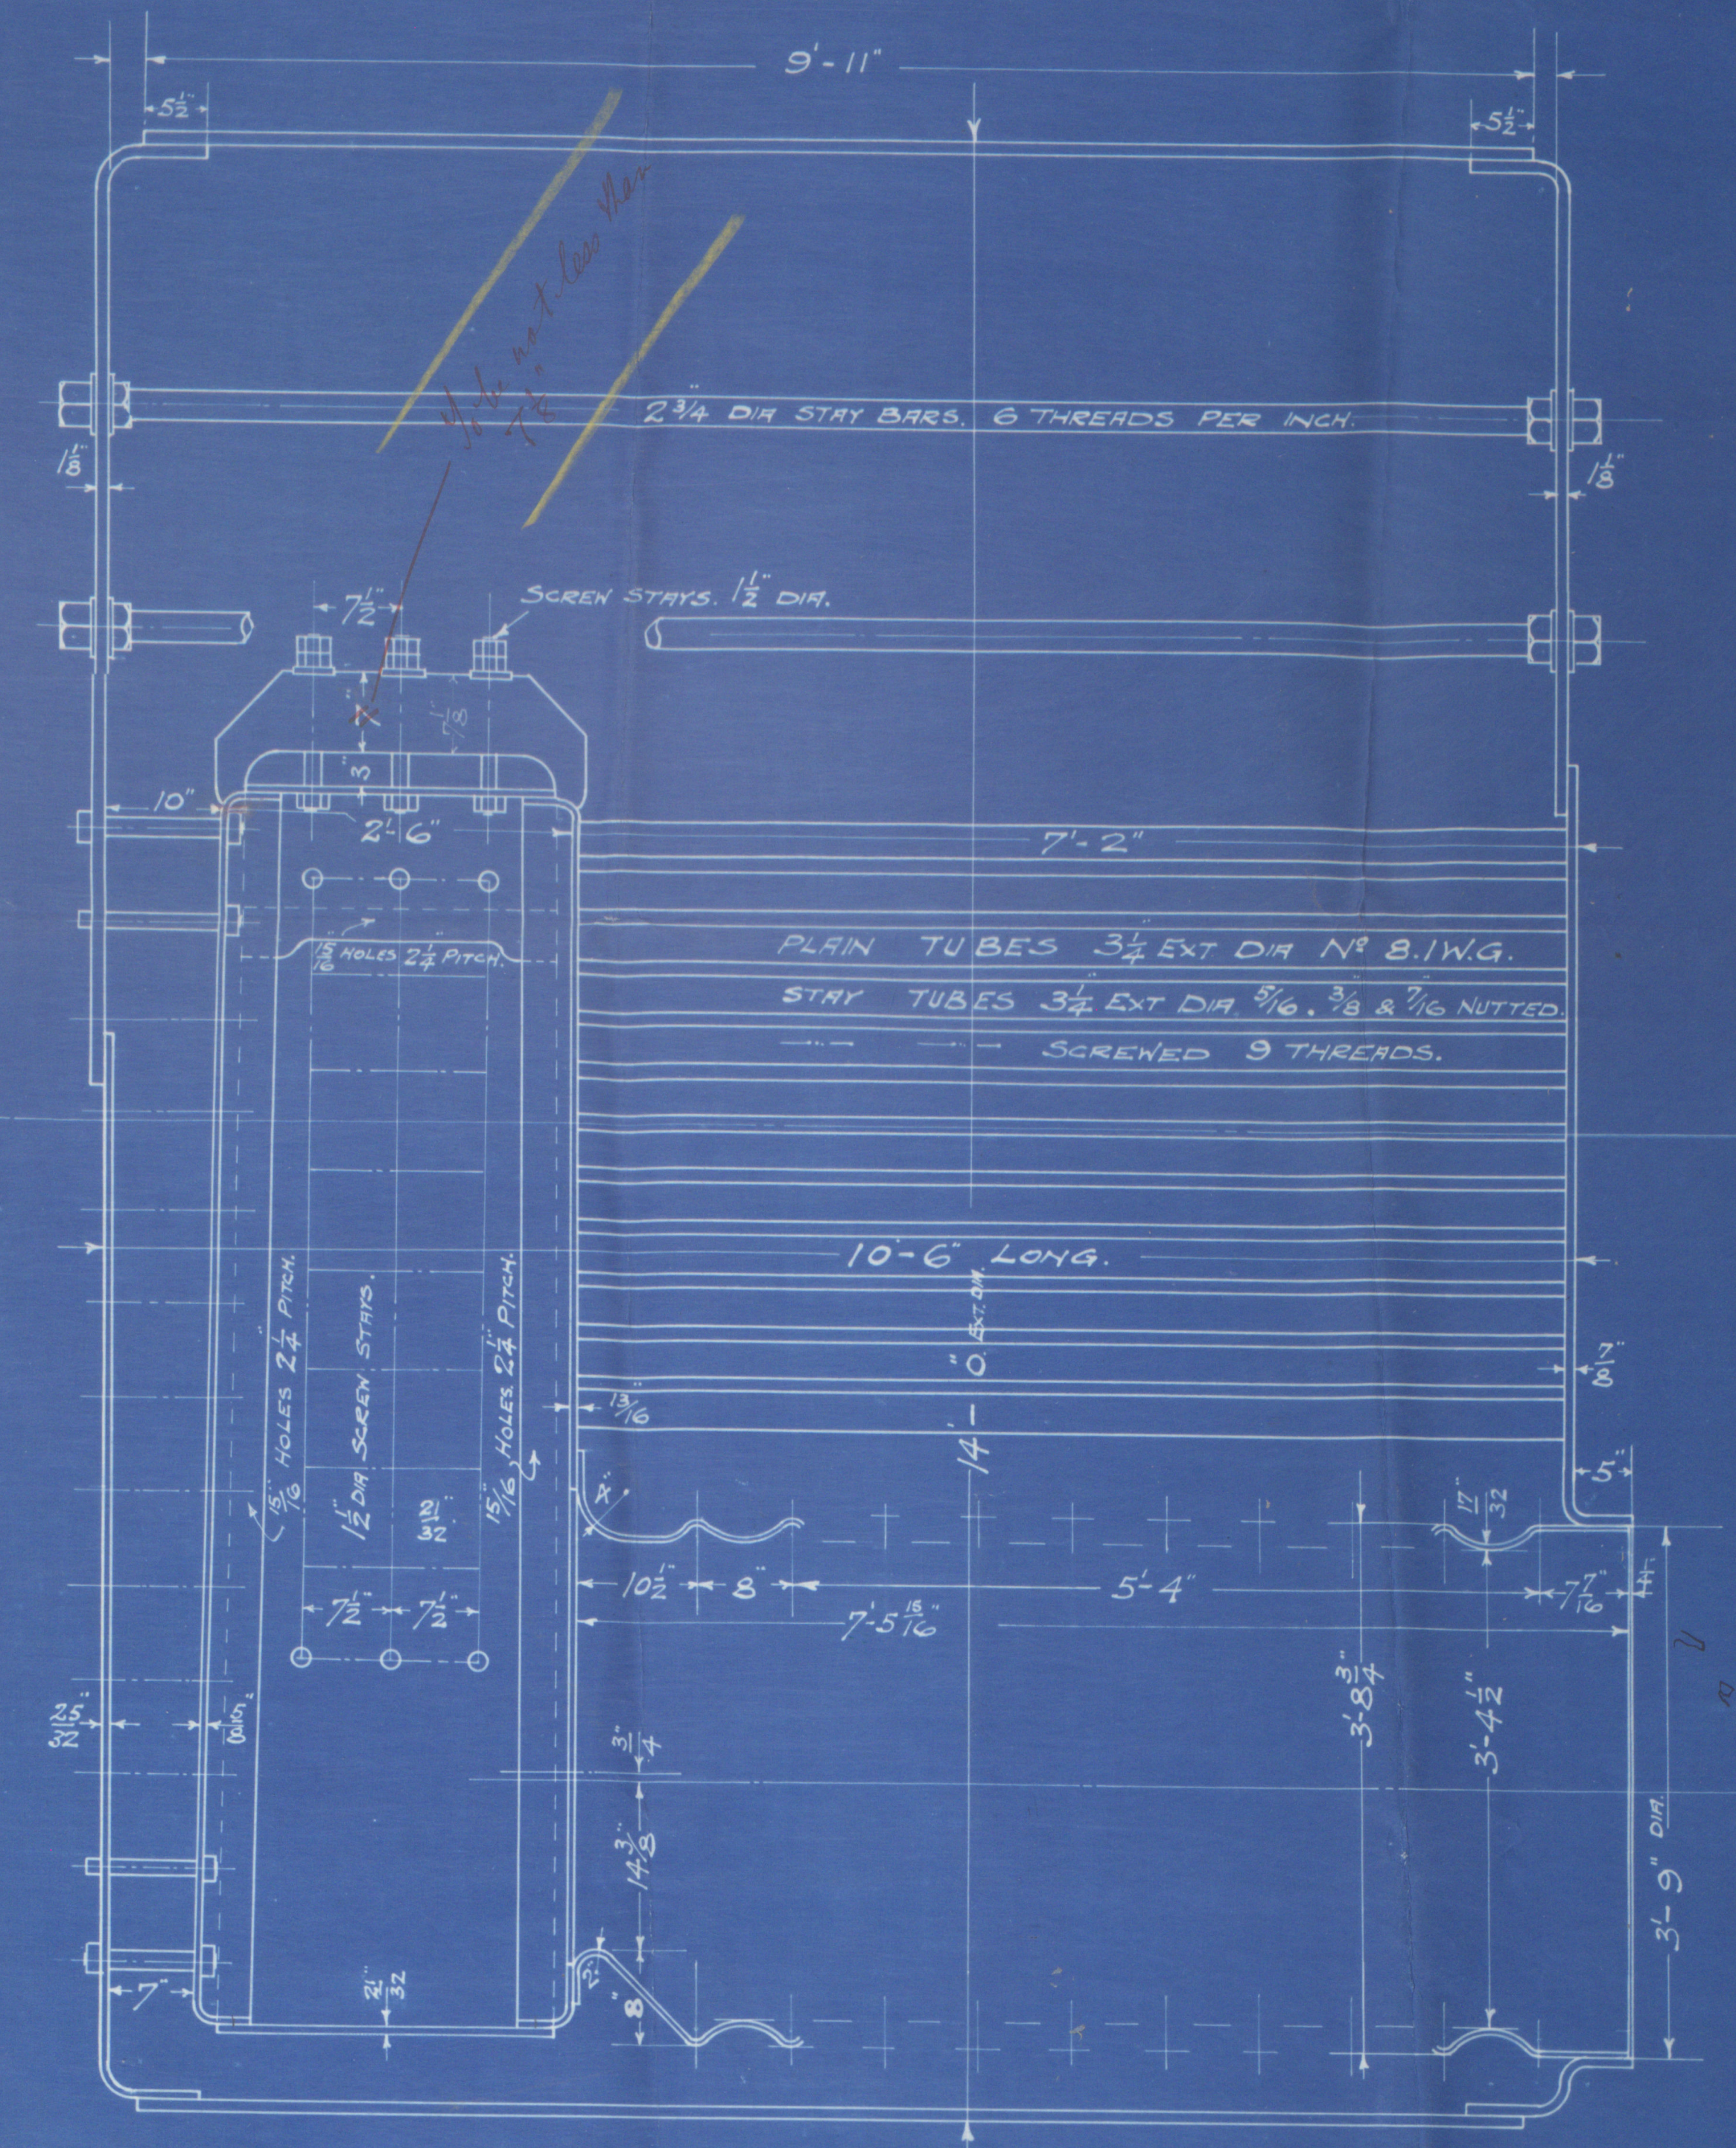
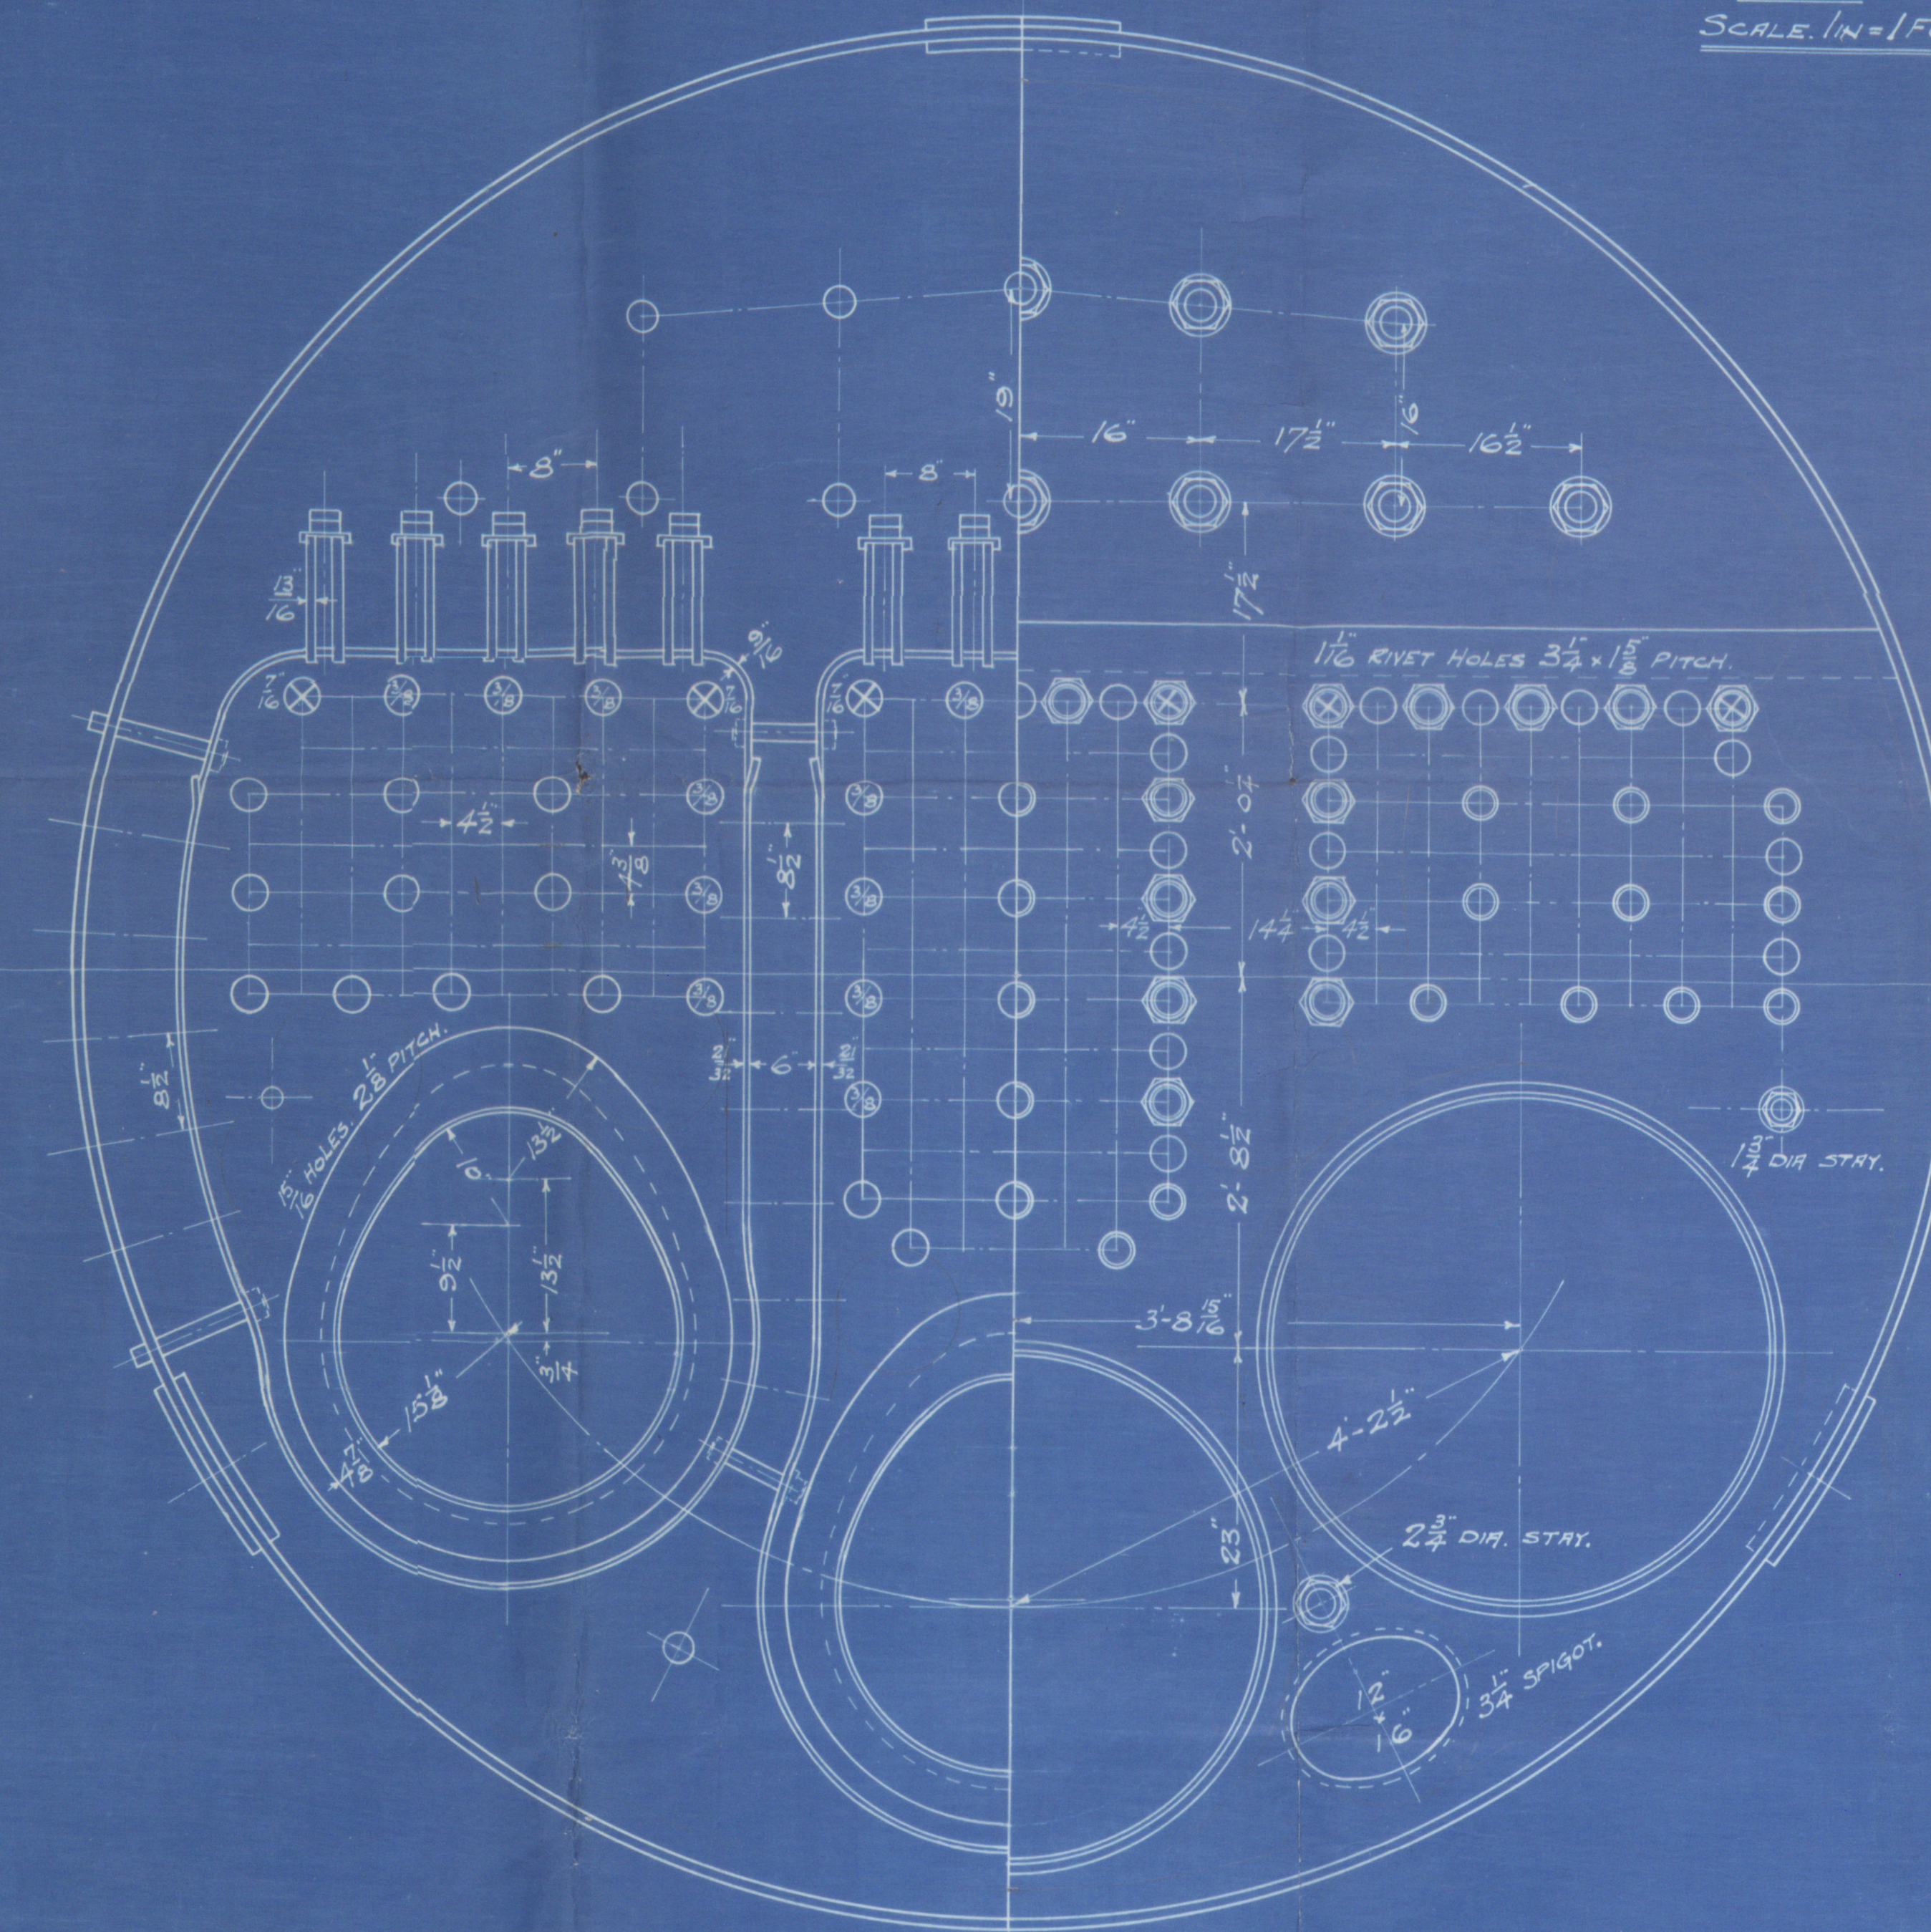


TO BE FITTED TO MESSRS W. DOXFORD & SONS. S.S. N<sup>o</sup> 587.  
TO PASS LLOYDS SURVEY FOR A WORKING PRESSURE OF 180 LBS PER Q.  
TO BE TESTED IN THE PRESENCE OF LLOYDS & OWNERS SURVEYOR.

TENSILE OF SHELL PLATES.	28.5 TO 32.5 TON.
" GIRDER "	28.0 " 32.0 "
" FLANGE " & FURNACES.	26.0 " 30.0 "
" MAIN STAY BARS.	28.0 " 32.0 "
" SCREW " & RIVET BARS.	26.0 " 30.0 "

COMPENSATION 1/8" THK, RIVETS 5/32" DIA.  
SCALE. 1/2" = 1 FOOT.

1. OFF.  
SCALE. 1/4" = 1 FOOT.

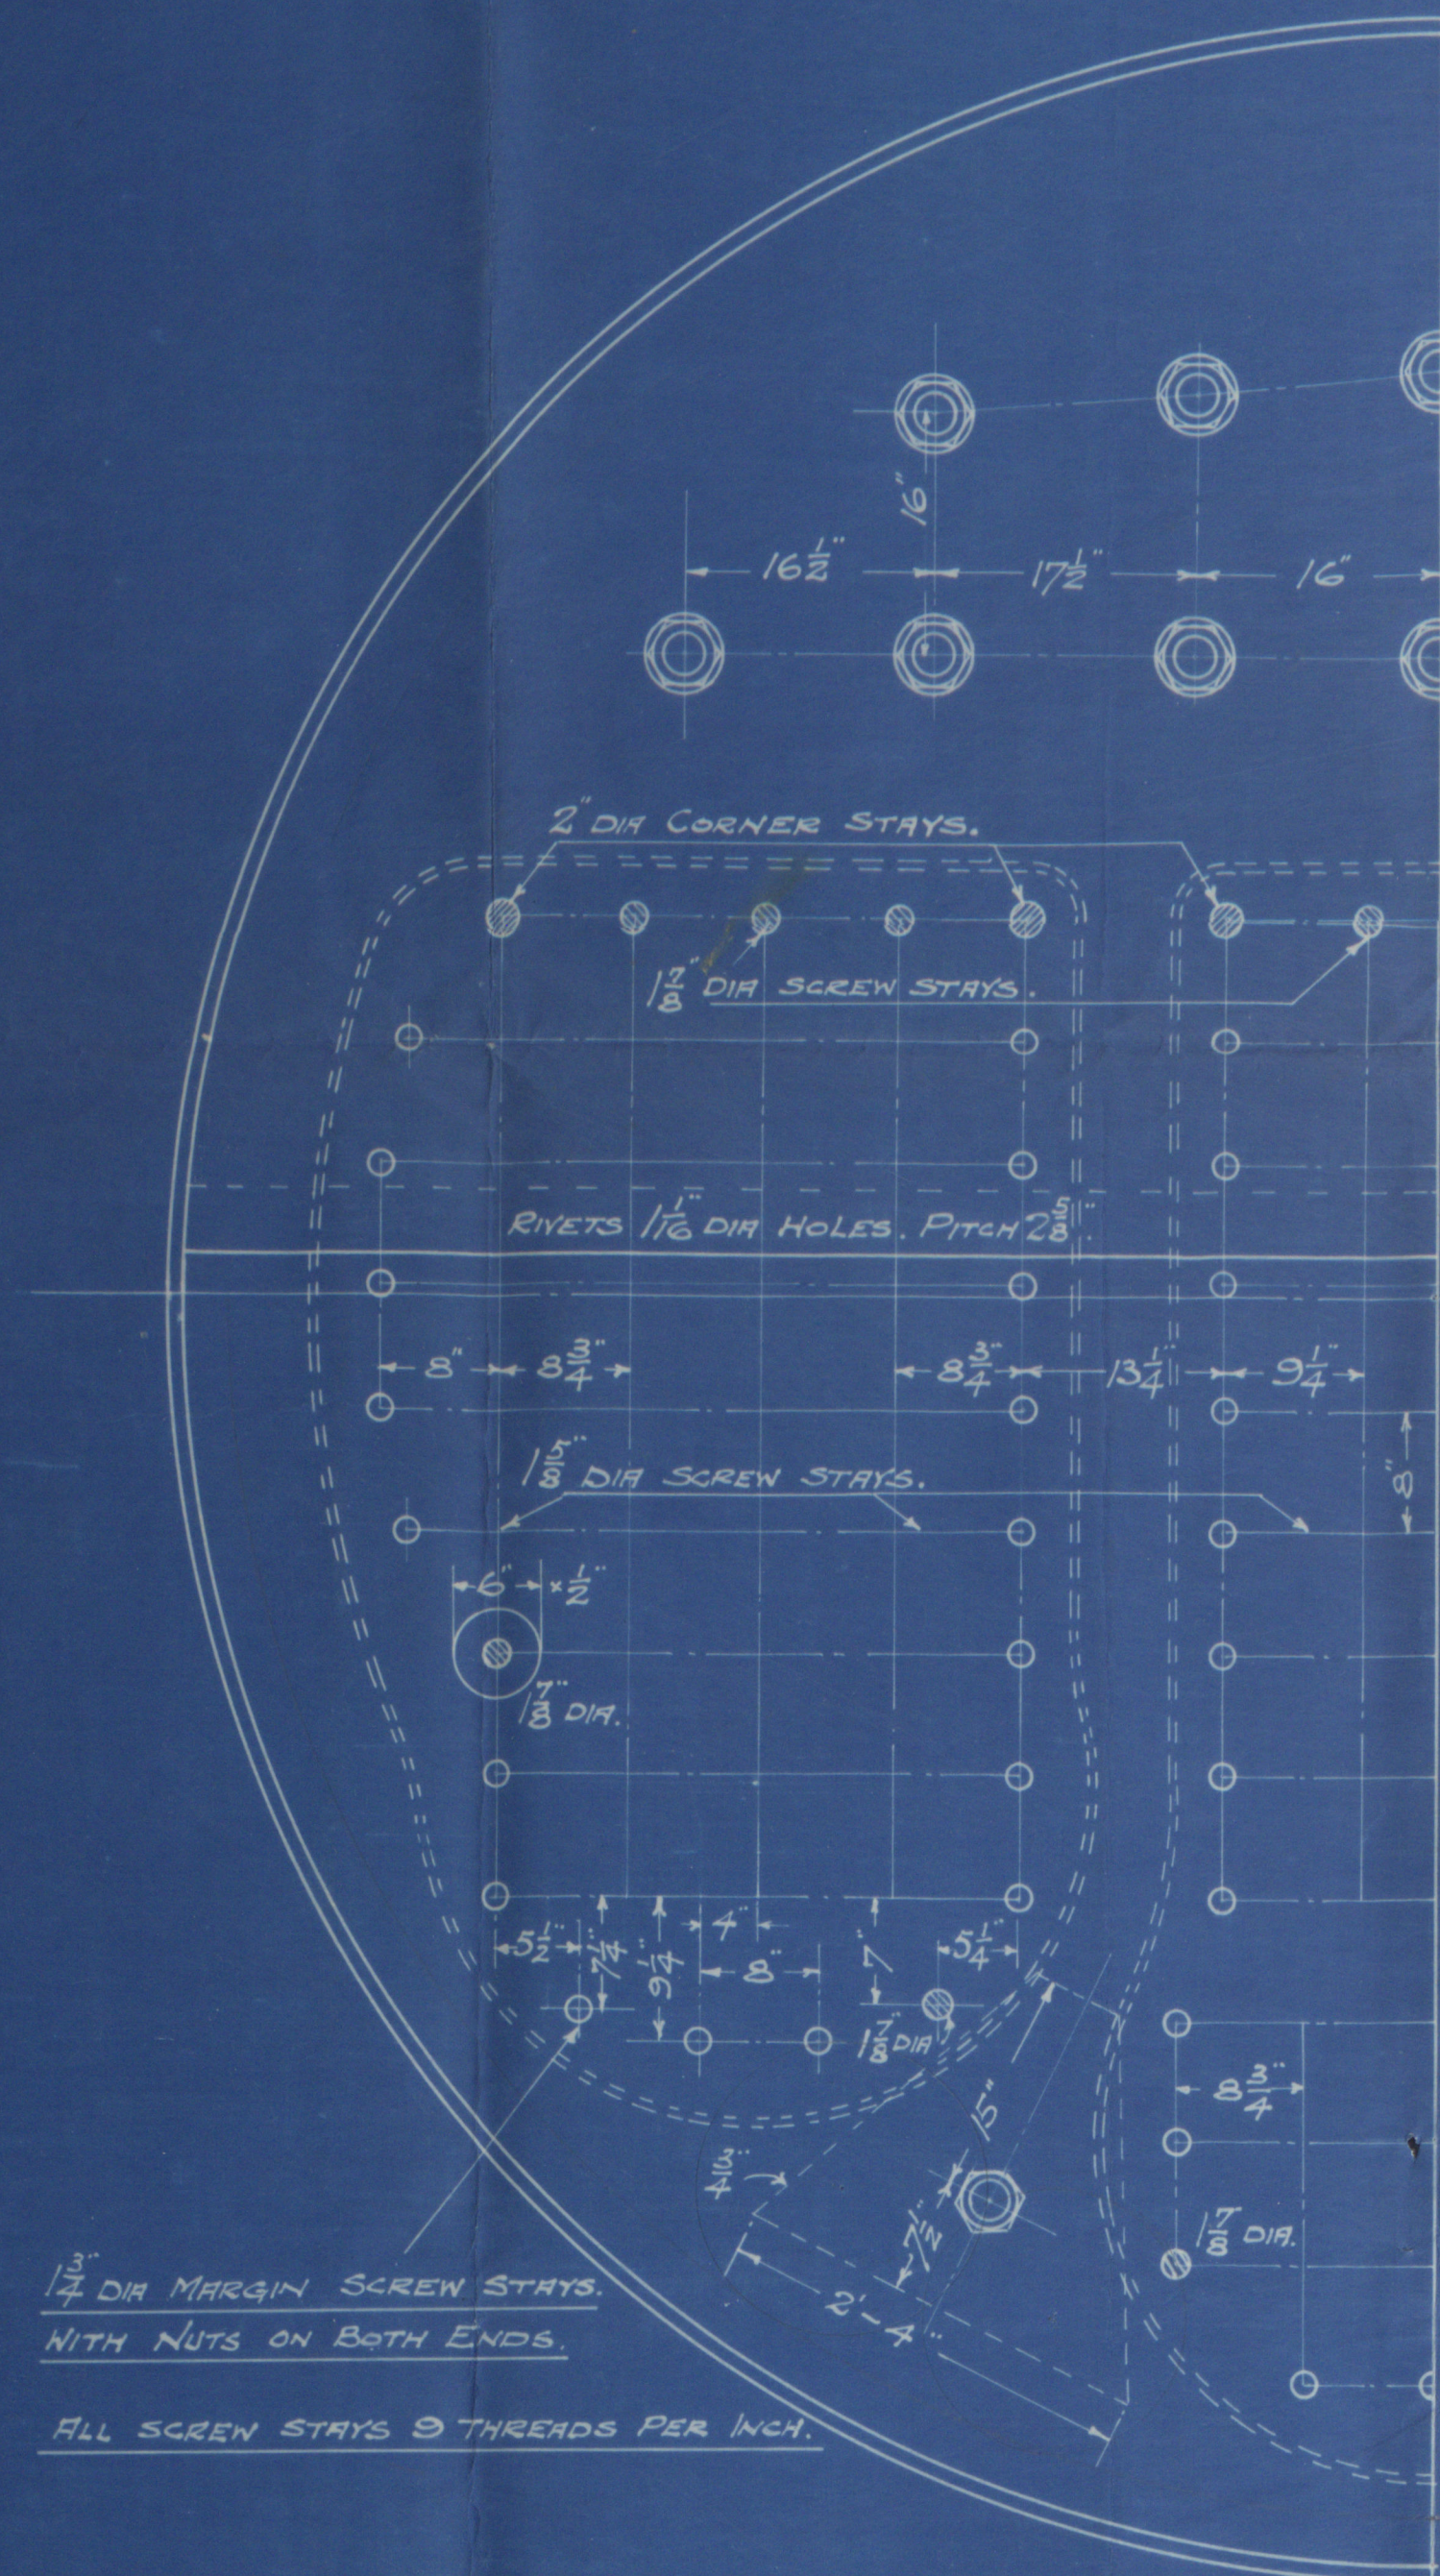

BOILER. N<sup>o</sup> 2196. A



© 2020  
10/3/2020  
Foundation



MAIN BOILERS

Nº S 2196A.

RICHARDSONS WESTGARTH & CO

WYM DOXFORD & SONS

S.S. Nº 587.

Nº 3724  
LLOYDS TEST  
320 lbs  
WP. 180 lbs  
16-12-27 AD

*West-Harclpool Report*

*No 16599*

*"Forthbridge"*

*See Rpt No 29677*

RETAIN

W494-0386

© 2020

Lloyd's Register  
Foundation