

Rpt. 11b.

LIV 28/5/32

MON. 26 SEP 1911

2/233
6840.

Lloyd's Register of British & Foreign Shipping.

SURVEYS FOR FREEBOARD.—STEAM SHIPS.

amended

Verification

PARTICULARS RELATING TO ALL STEAM SHIPS EITHER FLUSH DECKED, OR WITH TOP GALLANT FORECASTLES, SHORT POOPS AND BRIDGE HOUSES DISCONNECTED, OR WITH TOP GALLANT FORECASTLES HAVING LONG POOPS, OR RAISED QUARTER DECKS CONNECTED WITH BRIDGE HOUSES, OR OTHERWISE.

Port of Survey Belfast.

Date of Survey Building.

Name of Surveyor C. Pendall.

Ship's Name.	Port of Registry and Nationality.	Official Number.	Gross Tonnage.	Date of Build.	Particulars of Classification.
S.S. "GLOUCESTERSHIRE"	Liverpool British	131296	8124	1910-10	* 100% Contemplated.

Registered dimensions from Ship's Register.	LENGTH.	BREADTH.	DEPTH.	UNDER DECK	Moulded Depth as measured.....
	467.2	57.35	31.70	Tonnage. 6309.93 6187.29 say.	35.1"
Length on LOADLINE	466.6	Frame Depth Rule	Ceiling +.20 Sheer -.16 $\frac{2.5}{.08}$	Peak 3 included Tanks	
CORRECTED DIMENSIONS.	466.6	57.27	31.74	6187.29	

Co-efficient of fineness77	CORRECTION FOR LENGTH.
Any modification necessary {		Length of Ship on Loadline..... 466.6
[Para. 4 (a) to (e)*]		Length in Table 421.0
Co-efficient as corrected77	Difference 45.6
		Correction for 10ft., Table A. 1.7 Table C.
		× Difference divided by 10 7.75 (if required.)
		If $\frac{6}{10}$ ths length covered divide by 2 + 3.87 say +3.74"

Sheer { Stem... 89 } 116 ÷ 2 = 58 ... Mean	at Sternpost... 27	CORRECTION FOR IRON DECK.
Sheer at $\frac{1}{2}$ of the length from { Stem 48 } 56 ÷ 2 = 28 ... Mean	Sternpost 8	Proportion covered, if less than $\frac{7}{10}$ ths length covered
Gradual mean Sheer	50.90	Thickness of usual wood deck, less stringer and 2 Lts. Lts. = -1/2"
Standard mean Sheer (Table, Para. 18)	56.66	
Difference.....	5.76 ÷ 4 = + 1.44	
§ If limited as Para. 18 (f).....	say + 1/2"	

Rise in Sheer { At front of bridge house.....	✓	CORRECTION FOR ROUND OF BEAM.
from amidships {		Breadth at Gunwale amidships..... 53.6
[Para. 18 (e)] At after end of forecastle		Round of Beam..... 9.4
		Normal round
		Difference 4.4 ÷ 2 = 2.2
		Proportion of Deck uncovered (Para. 19) 1.2 = + 1/2"

Fall in sheer { Para. 18 (d) 4" ÷ 2 =		FREEBOARD
Length uncovered Nil covered by Bridge.	Correction	

ALLOWANCE FOR DECK ERECTIONS:—		
Freeboard, Table C. (9' 7 3/4" - 2.27")	6' 5 1/4"	
Correction for Length, if required (Para. 12, 13, and 14)		
Freeboard by Table A. corrected for sheer, and for length, if required (Para. 12, 13, and 14)	9' 9 1/2"	
Difference 39.94	3' 4"	
Percentage as below.....	56.813	
	22.4	
Correction for R. Q. Dk. if engine and boiler openings not covered by bridge house (Para. 11)		
Allowance for Deck Erections say. 1' 10 1/2"		
Length of Ship	466.6	
Corresponding percentage { (Para. 11, 12, 13, or 14) 56.813		
FREEBOARD recommended amidships from centre of Disc to top of Statutory Deck Line, Wood (Iron) Deck :—		

Length.	Length allowed.	Height.
Forecastle..... 77.5'	76.5'	8'
Bridge House 242.5'	228.875	8.3'
+ Fixed Q. Dk.
Poop..... 51.6	50.0	8'
Total 355.525	345.13	
Length of Ship	466.6	
Corresponding percentage { (Para. 11, 12, 13, or 14) 56.813		
FREEBOARD recommended amidships from centre of Disc to top of Statutory Deck Line, Wood (Iron) Deck :—		

© If the frames, skin planking, or ceiling are of unequal thickness the breadth of vessel to inside of ceiling should be reported if possible.
 † In vessels obtaining an allowance for deck erections under Para. 11 where the sheer drops abaft amidships the height of the R.Q.D. is to be taken from the level of the top of the amidships beam.
 § In flush-decked vessels the total standard mean sheer means the sheer measured at the stem and stern-post. In vessels having poops and forecastles, it means the sheer measured at points distant one-eighth of the vessel's length from stem and stern-post.

Annex T.

Ms Bx 1 26/9/10.

Winter Freeboard	8' - 1 1/2"
Summer	7' - 7"
Indian Summer	7' - 0 1/2"
N.A. Winter	7' - 0 1/2"
Correction necessary because clearside amidships, measured in accordance with the Statute, is not taken at the intersection of the wood or iron deck with side.	- 1"
Winter Freeboard from deck line	8' - 2 1/2"
Summer	7' - 8"
Indian Summer	7' - 1 1/2"
N.A. Winter	7' - 1 1/2"
Amended Tables	7' - 6 1/2"
March 1906	6 1/2" N.

† State dimensions of freeing port area on back of this form.
 The Surveyor should state whether the fall in sheer as reported is measured relatively to the straight line of keel or to the water line. If measured relatively to water line the vessel's draft at time of survey, and also the usual load draft forward and aft, should be reported.

MARKING REPORT [P.T.O.]
 RECEIVED 12 OCT. 1910

W495-0133

Do all the Frames extend to the top height in the Poop?	Yes.	Raised Quarter Deck?		Bridge House?	Yes	Forecastle?	Yes
To what height do the Reverse Frames extend?	<i>No Upper & Middle Decks alternately.</i>						
Has the Poop or Raised Quarter Deck an efficient Iron Bulkhead at the fore end?	Yes.						
Give particulars of the means for closing the openings in Bulkhead	<i>Weather boards half height in riveted channels.</i>						
Is the Poop or Raised Quarter Deck connected with the Bridge House?	<i>No</i>	<i>of alleyway. hinged doors in alleyway.</i>		Has the Bridge House an efficient Bulkhead at the fore end?	Yes.		
Give particulars of the means for closing the openings in Bulkhead	<i>no openings.</i>						
What is the thickness of the Bridge Front plating?	<i>.720"</i>	and Coaming plate?	<i>.920"</i>				
Give scantlings and spacing of the Stiffeners	<i>9x32x64 Bulk angles spaced 30"</i>						
Are bracket plates fitted at each end of the Stiffeners?	Yes.	Are hor'l. brackets fitted connecting Bridge Bulk'd. with Bulwarks?	Yes.				
Has the Bridge House an efficient Iron Bulkhead at the after end?	Yes.						
How are the openings closed?	<i>Weather boards half height in riveted channels.</i>						
Is the Forecastle at least as high as the main or top-gallant rail?	Yes.	Has the Forecastle an efficient Iron or Wood Bulk'd. at after end?	Yes.				
Are the Engine and Boiler openings covered by a Bridge, Poop, Raised Quarter Deck, or enclosed by a Strong Iron or Steel Deckhouse?							
If the openings are not so protected are the exposed parts of the Casings efficiently constructed?							
Give thickness of plating; scantlings and spacing of Stiffeners							
What is the height of the exposed Casings?		Are suitable means provided for closing all openings in them in bad weather?					
Are the Weather Deck Hatchways efficiently constructed and at least equal to the requirements of Section 28 of the Rules for 1904-5? Give particulars below:		Yes.					
Position and Size.	N°1 Poop 12'6" x 16'0"	N°2 22'6" x 16'0"	N°3 15'9" x 16'0"	N°4 17'14" x 16'0"	N°5 15' x 12'		
Item.	Ship. on Forecastle. Rule.	Ship. Rule.	Ship. Rule.	Ship. on Bridge. Rule.	Ship. Rule.		
COAMING.							
Height above top of DECK.	34"	18"	30"	24"	30"	18"	24"
Thickness { Sides.....	.40	.40	.57	.45	.50	.40	.44
Ends.....	.40	.34	.40	.40	.34	.40	.40
SHIFTING BEAMS OR WEB PLATES.	Number.....	Two.	Two.	Three.	Three.	Three	Two.
Section and Scantlings.....	25x40 Web 12-T beam Steel.	16x34 Web.	2 web 25x40 3 bars 12x60 T	Four	Three.	Three	Three
Material.....							
FORE AND AFTERS.	Number.....	none					
Section and Scantlings.....							
Material.....							
HATCHES Thickness	5"						
Remarks.....							

* When the Fore and Afters are of wood the depth should be stated from the underside of the hatches.

(If the sill of the lowest side scuttle will be less than 6 inches above the Indian Summer Load Line if assigned under the tables, state vertical distance from top of deck at side amidships to lower edge of lowest side scuttle.)

The following information is to be given in all Cases of vessels dealt with under Paras. 11, 12 (under 15 feet Moulded depth) and under Shelter Deck Rules.

What is the thickness of the Bridge Sheerstrake?

Delete the words { The Crew are, are not, berthed in the bridge house.
that do not apply { The arrangements to enable them to get backwards and forwards from their quarters are, are not satisfactory.

Length of Bulwarks in well

Area of Freeing Ports required by Para. 11 (e) each side of vessel

Ft. Tenth. Ft. Tenth. No. =

Sq. ft.


x x } Freeing Ports
(each side of vessel) =

Sq. ft.

x x }

Sq. ft.

Total deficiency or excess =

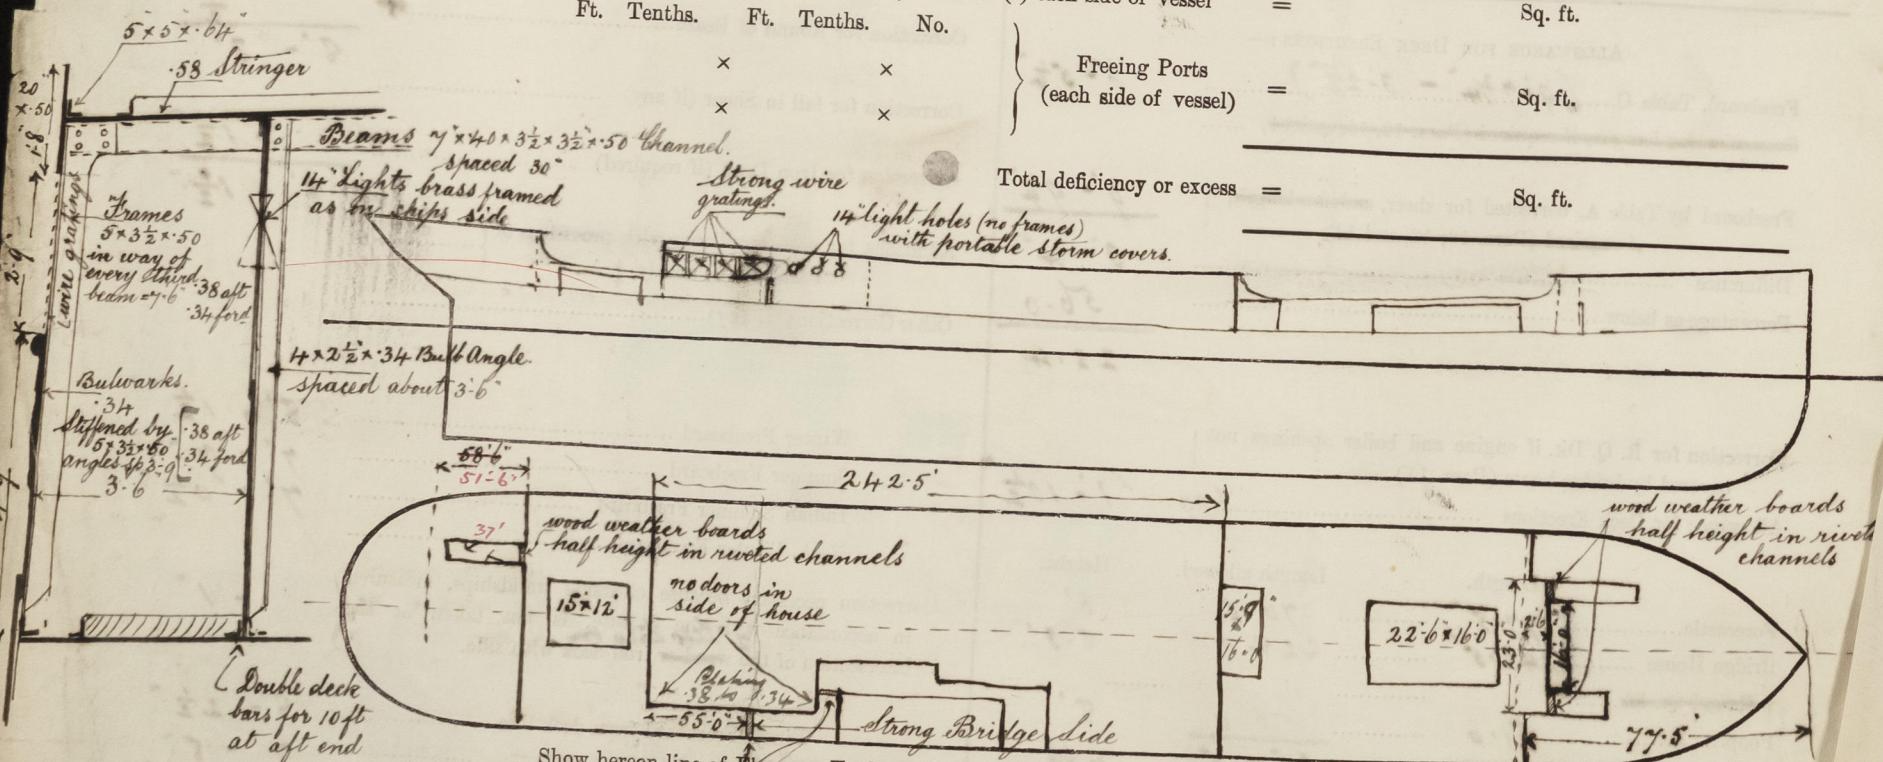

State any special features in the construction of the Vessel *wood weather boards 1/2 height in riveted channels* *Approved plans forwarded herewith for reference. See Verification Freeboard Report No 6836 on this vessel.*

Owners

Address

Fee £

Received by me



© 2021

Lloyd's Register
Foundation