


S. S. "GLOUCESTERSHIRE."

ARRANGEMENT OF ACCOMMODATION.

SCALE $\frac{1}{8}$ = 1 FOOT

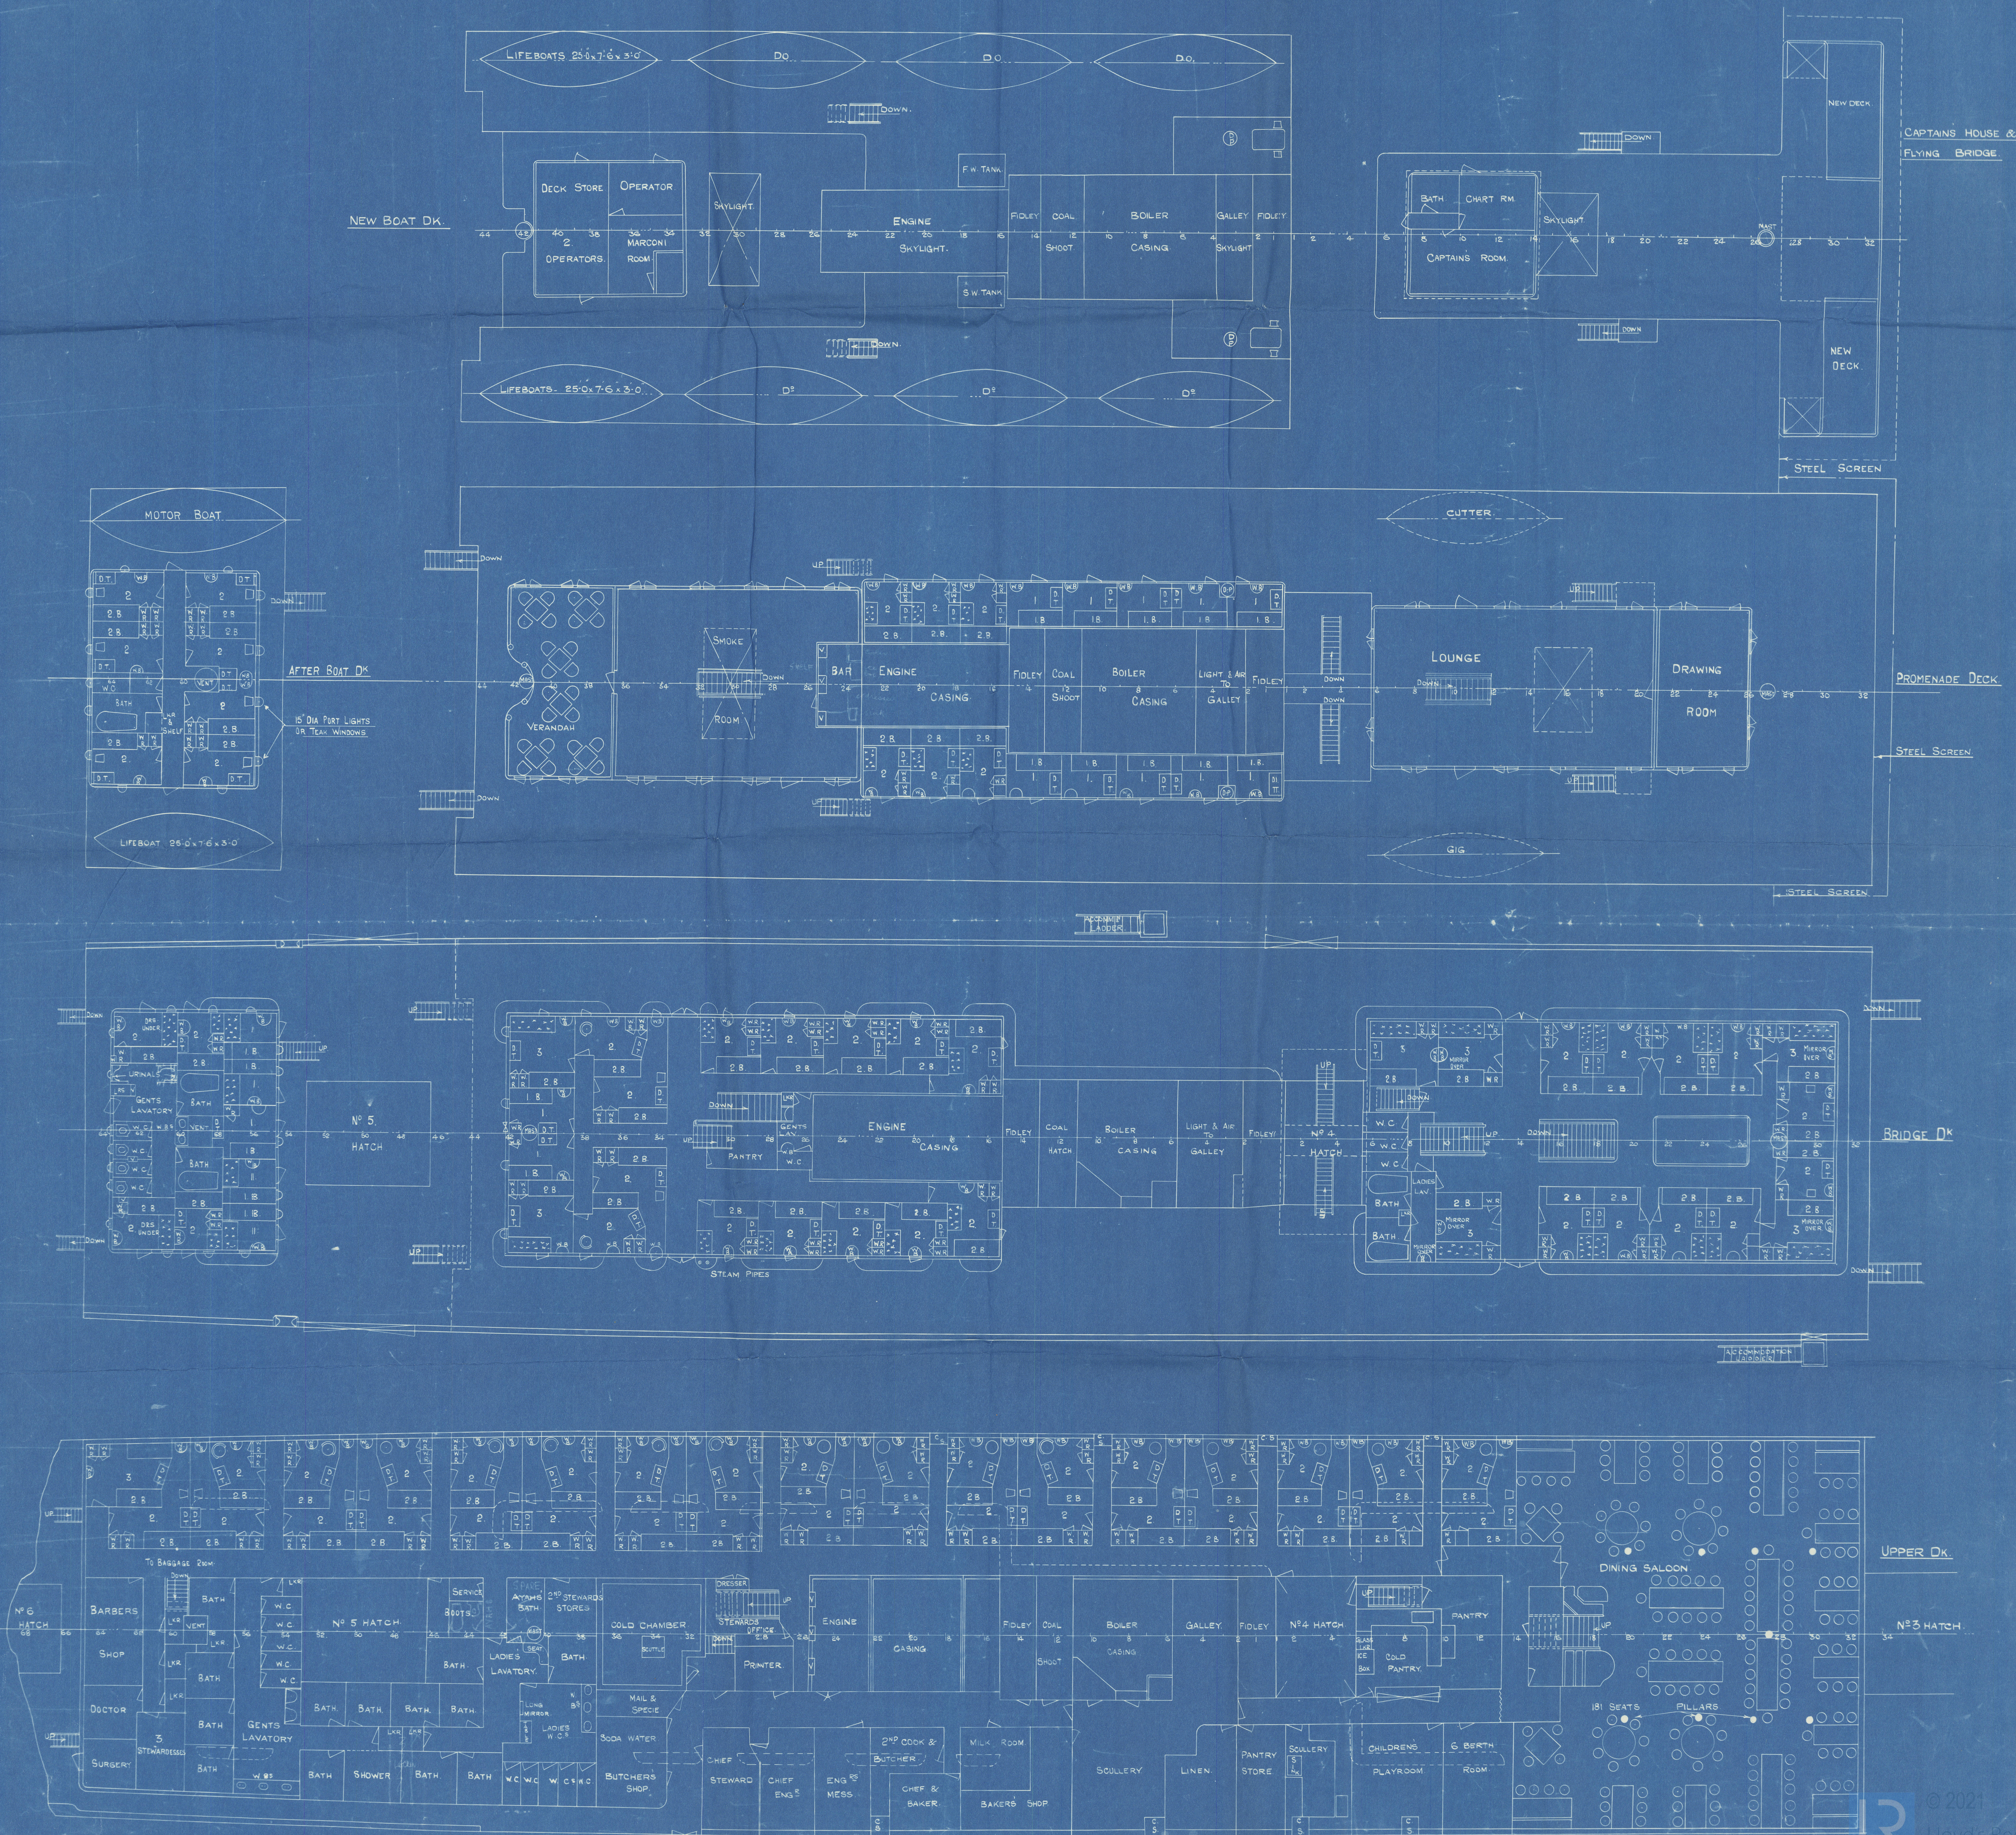

Gloucestershire

Gen. Am. as now fitted

S. S. Gloucestershire

LIVERPOOL:

Report No. 95951.

RETAIN

W495 - 0143



© 2021

Lloyd's Register
Foundation