


1944
1945
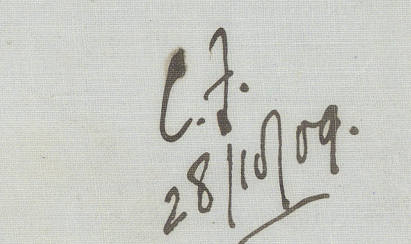

— 467'-0" x 54'-0" x 35'-6" (K. TO B) —

25-10-09
Ed. W.


Harland & Wolff Ltd

Nº 411


Profile

S.S. - Gloucestershire

Bel Rept 6852

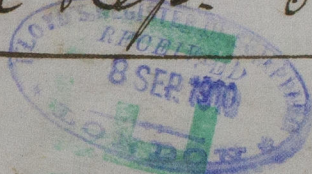

RE

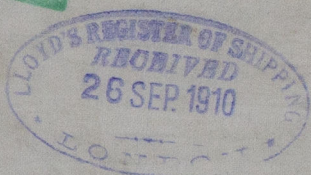

W495-0145



© 2021

Lloyd's Register
Foundation