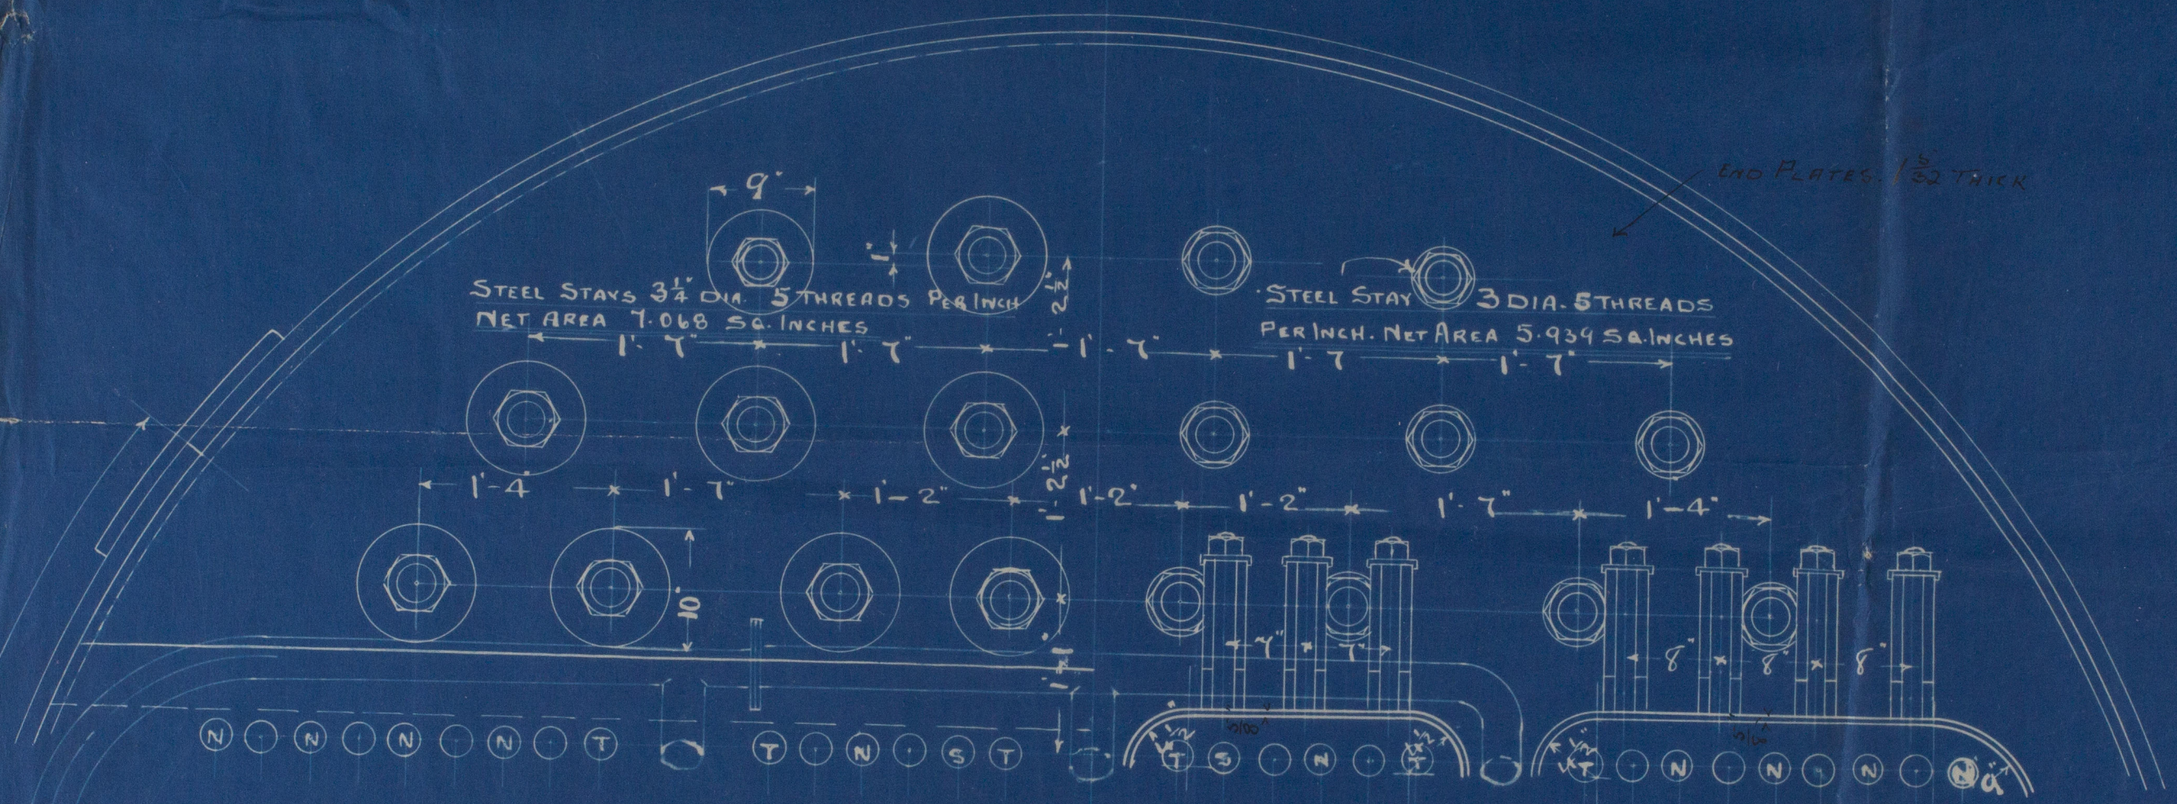

N° 411

ARRANGEMENT OF STEAM SPACE STAYS
FOR S.E. BOILER.

FLY TO DRAWING N° 8252

LLOYDS REGISTER OF SHIPPING LONDON
10/11/09
ARR 10.11.09
6.11.09
LR
Lloyd's Register Foundation