




CLASS 100 ALLIGDS

POUL DIMENSIONS 379.75 x 50.02 x 30.33 m

FORECASTLE 2 ROWS OF BEAMS  
BEAMS 7-5 x 40 BA ON EVERY FRAME

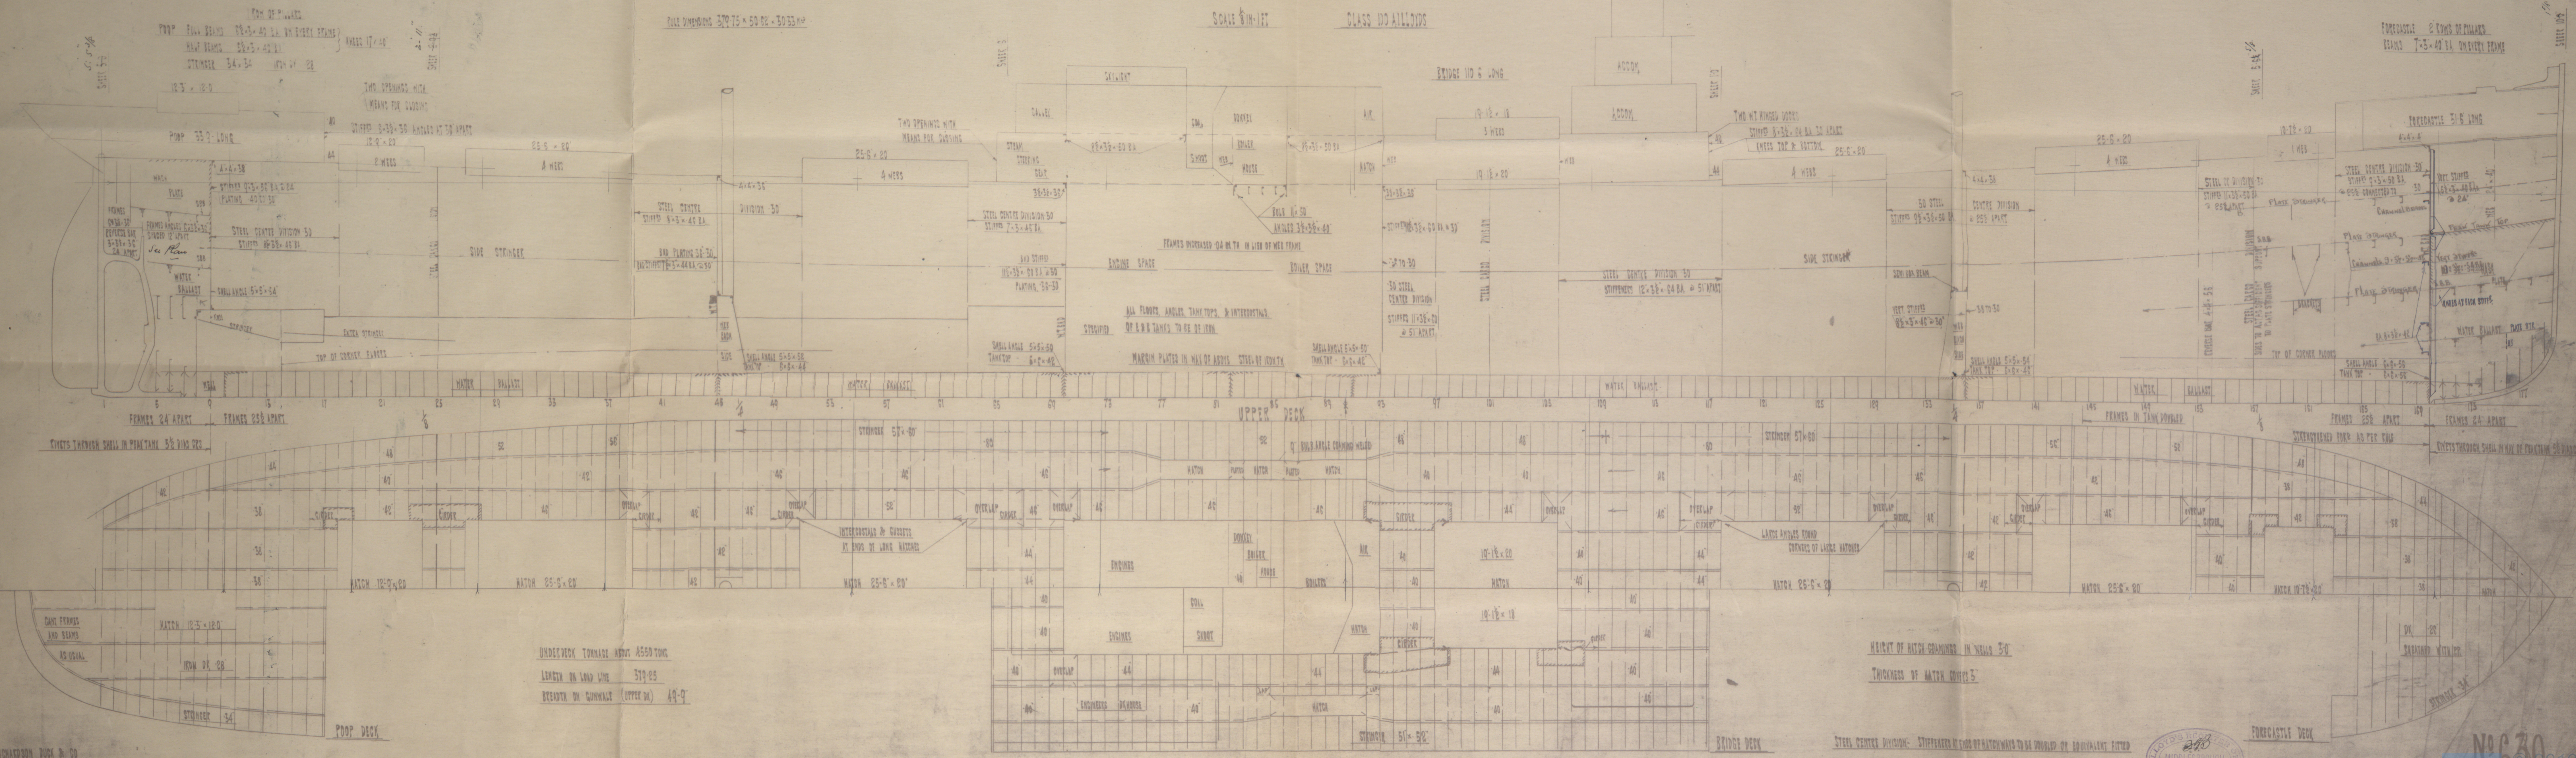

UNDERDECK TONNAGE ABOUT 4550 TONS  
LENGTH ON LOAD LINE 379.25  
BREADTH ON GUNWALE (UPPER DECK) 49.9

HEIGHT OF HATCH COAMINGS IN WELLS 3'-0"  
THICKNESS OF HATCH COVERS 5"

STEEL CENTRE DIVISION: STIFFENERS AT ENDS OF HATCHWAYS TO BE DOUBLED OR EQUIVALENT FITTED





messrs Richardson. Stock & Co<sup>rs</sup>

W630

Profile and Deck Plan

As Built.

S<sup>r</sup>. Dantwren

Mar. Report 1841

RETAIN



© 2019

Lloyd's Register  
Foundation

W497-0178