

19.6.12  
24.6.12  
(639) 16.11.12  
(641) 12.11.13


3.3  
2.0  
1.3

LONGITUDINAL SECTION

SCALE 1/4"=1'-0"  
CLASS 100 ALLOYS

POW. DIMENSIONS 379.75' x 50.82' x 30.33' M

FORECASTLE 2 ROWS OF PILLARS  
BEAMS 7'-3" x 40 BA. ON EVERY FRAME

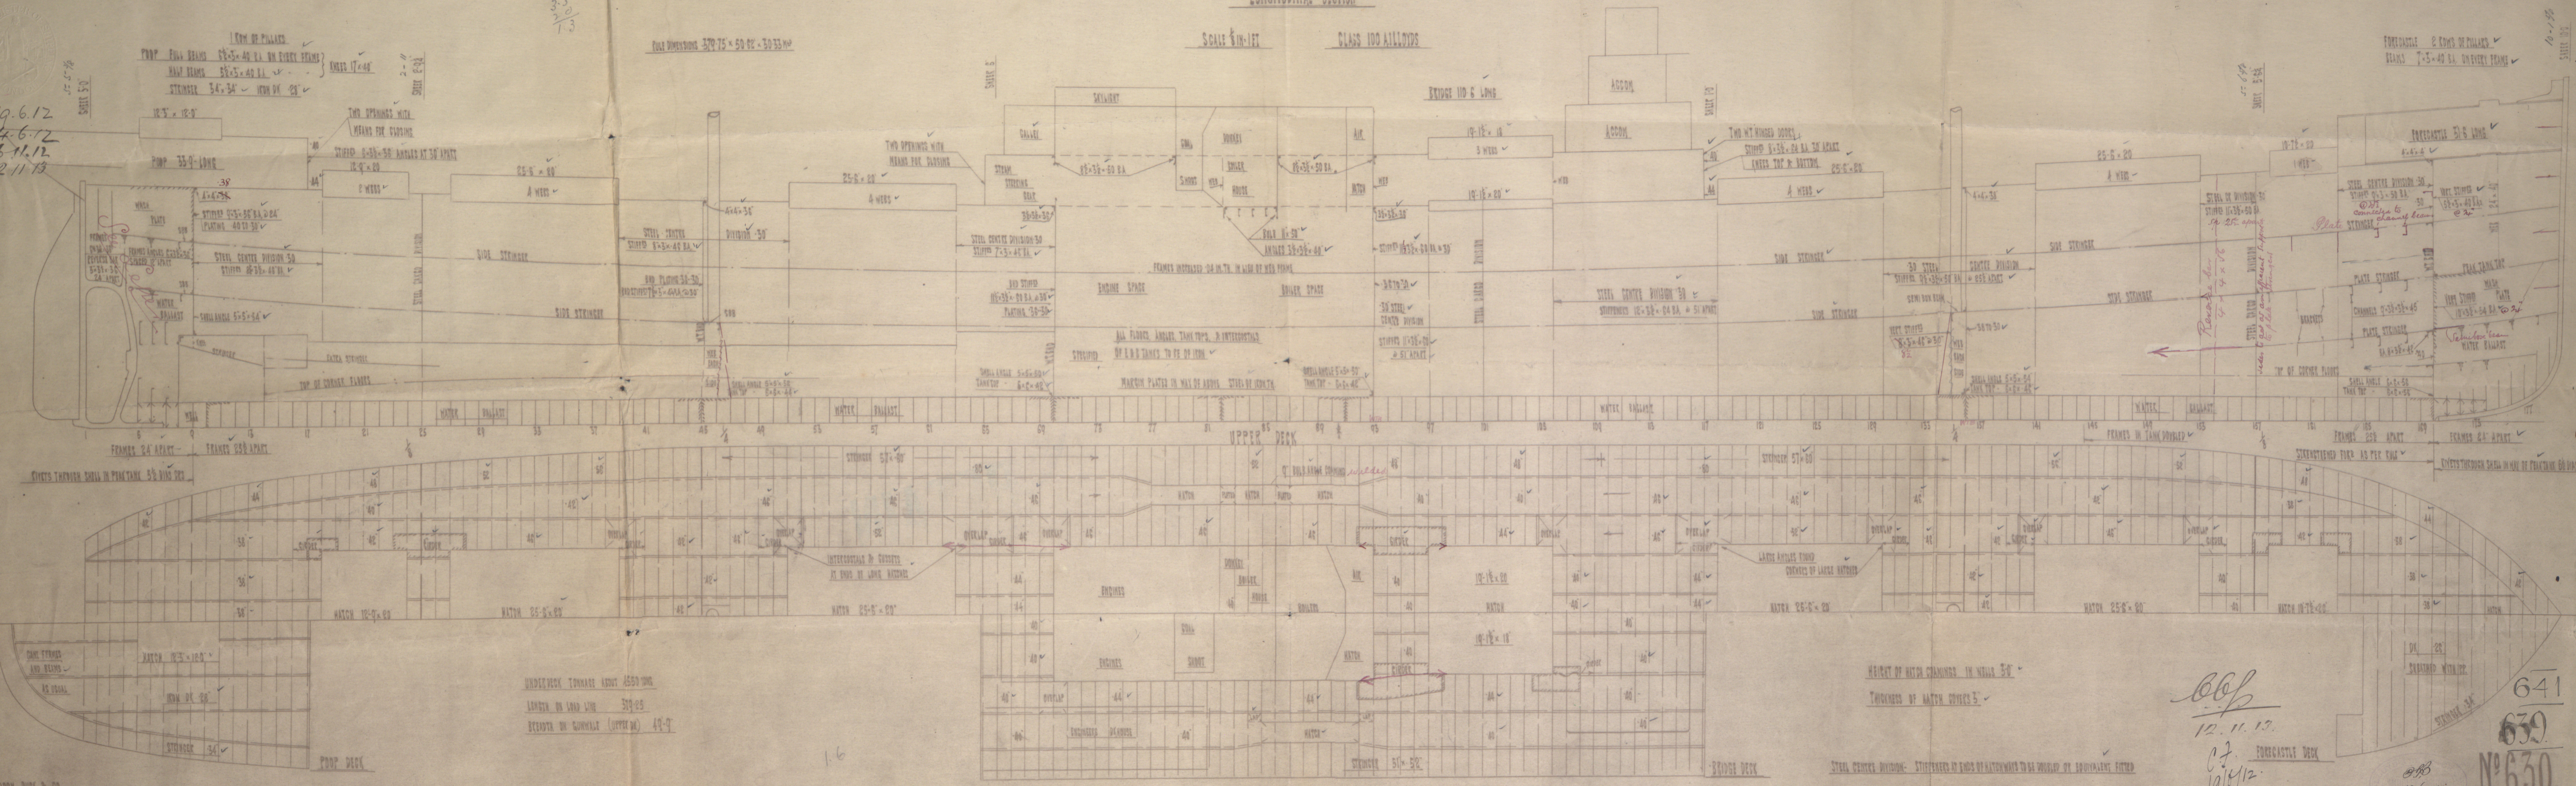

UNDERDECK TONNAGE ABOUT 1550 TONS  
LENGTH ON LOAD LINE 379.25  
BREADTH ON GUNWALE (UPPER DECK) 49.9

HEIGHT OF HATCH COAMINGS IN WALLS 3'-0"  
THICKNESS OF HATCH COVERS 5"

STEEL CENTER DIVISION- STIFFENERS AT ENDS OF HATCHWAYS TO BE DOUBLED OR EQUIVALENT FITTED

666  
12.11.13  
C.F.  
19/11/12


641  
639  
No 630  
17.6.12

Master Richardson Duck & Co  
No 630. 639. 641.



Profit & Loss

No. 630 & 639 "Daredevil"


Med. Report 1841

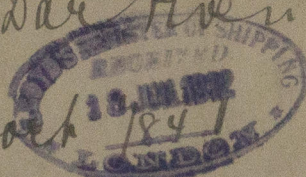

No 639 Pontrevel.

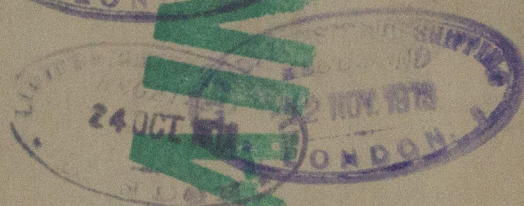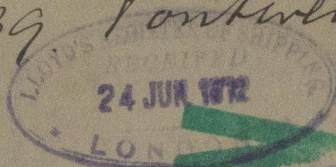


Med. Rpt. No. 8476

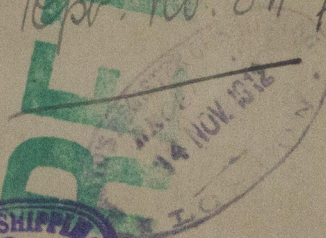

641.

S.S. RHYDWEN.

Med. Report No 8638.

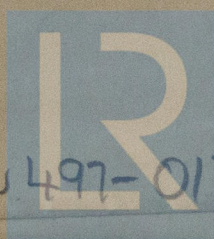

© 2019

Lloyd's Register Foundation

W 497-0179