

MIDSHIP SECTION

SCALE 1/2 IN = 1 FT


CLASS 100 ALLOYDS

19.6.12
24.6.12
16.11.12
12.11.13 (64)

RULE LENGTH 579.75 ✓
" BREADTH 50.62 ✓
" DEPTH 30.35 ✓

TRANSVERSE NO 80.95 ✓
LONGITUDINAL NO 30740 ✓
DEPTH d 28.83 ✓
D/L BRIDGE DECK NOT EXCEEDING 10.00 ✓
D/L UPPER DECK 12.5 ✓
EQUIPMENT NO 32030 ✓

EQUIPMENT
2 BOWERS 55 1/4 CWT STOCKLESS ✓
1 " 47 1/2 CWT " ✓
1 STREAM 15 CWT EX STOCK ✓
1 KEDGE 6 1/2 CWT " " ✓
270 FATHOMS 2 1/2 STUD CHAIN CABLE ✓
90 " 4 1/2 MOORING WIRE OWNERS' CHOICE ✓
120 " 4 1/2 STEEL TOWLINE TO STEEL WIRE ✓
2 OF 90 7 MANILLA HAWSER ✓
2 OF 90 7 " WARP ✓

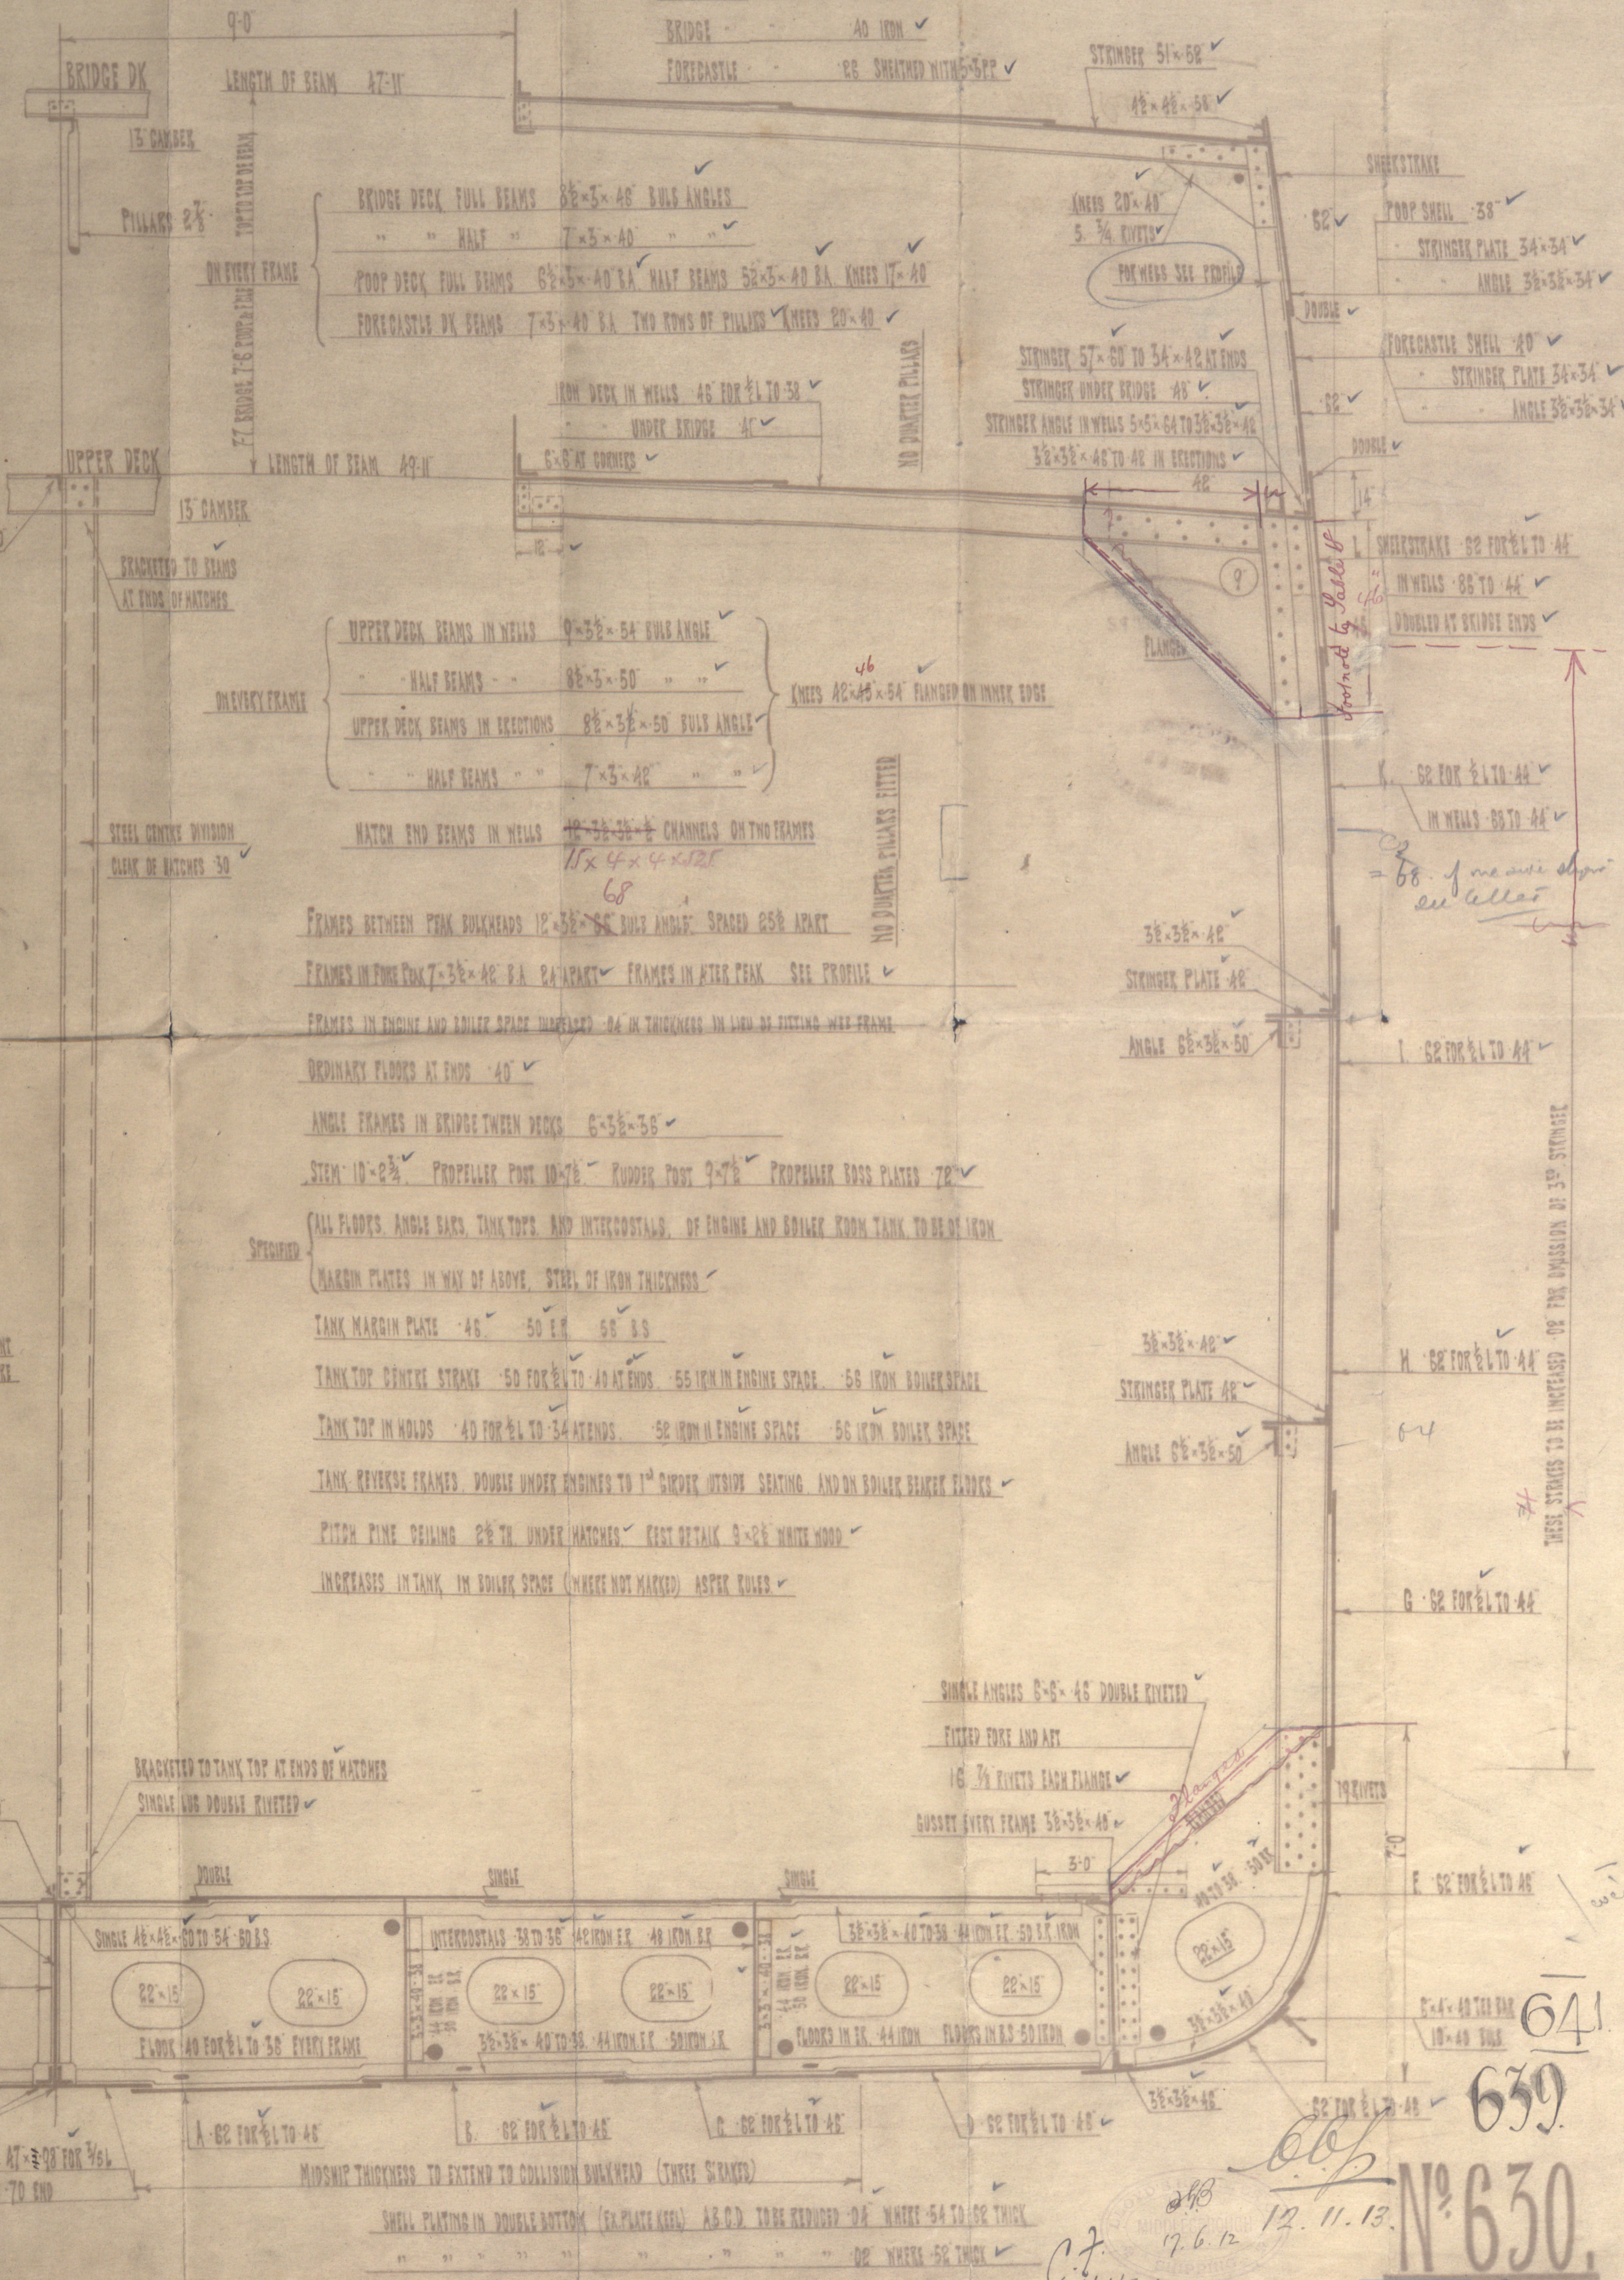

RICHARDSON DUCK & CO LTD
SHIPBUILDERS

STOCKTON-ON-TES TR NO 2526
JUNE 15 1912


C.7.
19/6/12

7.6.12


12.11.13

Nº 630.


Messrs Richardson Buck & Co
No 630. 639. 641.
Mid. Sec.

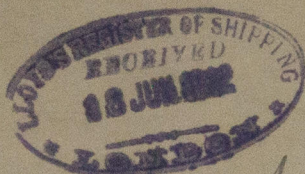


No. 630 - S.S. "Dare Haven"
Midd. Report 7841

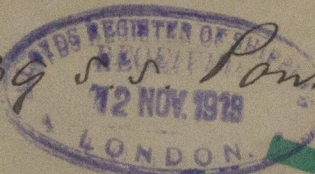

No 639 S.S. "Pontwen"

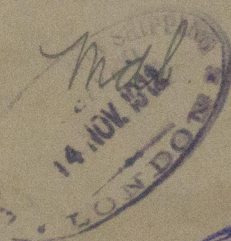

Midd. Rpt. No 8176

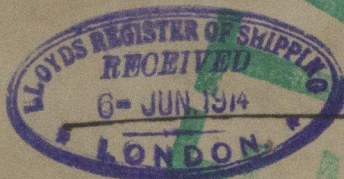

No. 641.

S.S. RHYDWEN.

Midd. Report No 8638.



© 2019

Lloyd's Register
Foundation

W497-0180